


FHWA REGION	STATE	ROUTE	FEDERAL AID PROJECT	ROUTE	STATE PROJECT

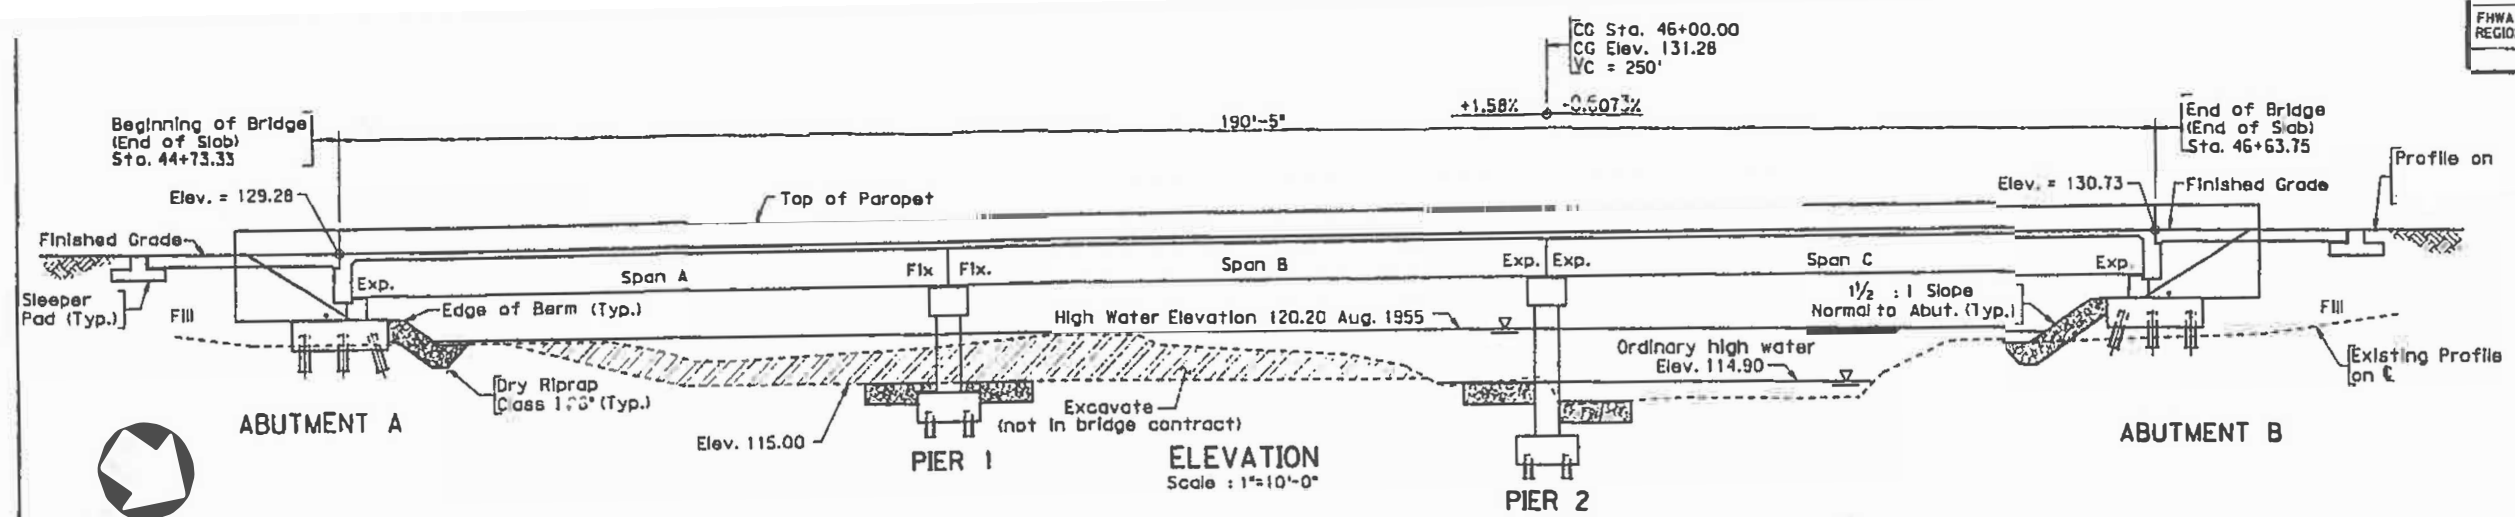

GENERAL NOTE:

Widths: 27'-0" roadway, variable median from 14'-0" variable roadway from 27'-0" to 36'-5 1/2". Overall width 68'-0" face-to-face of curb

Span Layout: 64'-63'-64' prestressed concrete spans made continuous for live load

Capacity: HS20-44 loading and alternate military

Drainage area: 36 sq. mi.

Specifications:

1996, 1997, 1998 and 1999 Interim Specification Modifications.

These plans are incomplete unless accompanied by Supplemental Specifications and Special Provisions in the contract documents.

Design loading includes 20 p.s.f. allowance for construction tolerances and construction methods.

Structural steel in bearings and sole plates shall be Grade 36. Anchor bolts for bearings shall be galv.


Concrete in prestressed members shall be Class I. In superstructure, including parapets, terminal wall and integral abutment backwall shall be Class A4 and piers, Class A3.

Deformed reinforcing bars shall conform to ASTM 60. All reinforcing bar dimensions on the details to centers of bars except where otherwise noted subject to fabrication and construction tolerances.

H-Piles in abutments and piers have a design capacity of 70 tons per pile and shall be driven to refusal. Pile penetration shall conform to Sec. 403.06 (d) & Specifications.


Structural approach slabs, including sleeper pads, Preformed Elastomeric Joint Sealer, are not included in bridge contract.

All curves are to be superelevated and transition accordance with Standard TC-5U. See Road Plans.

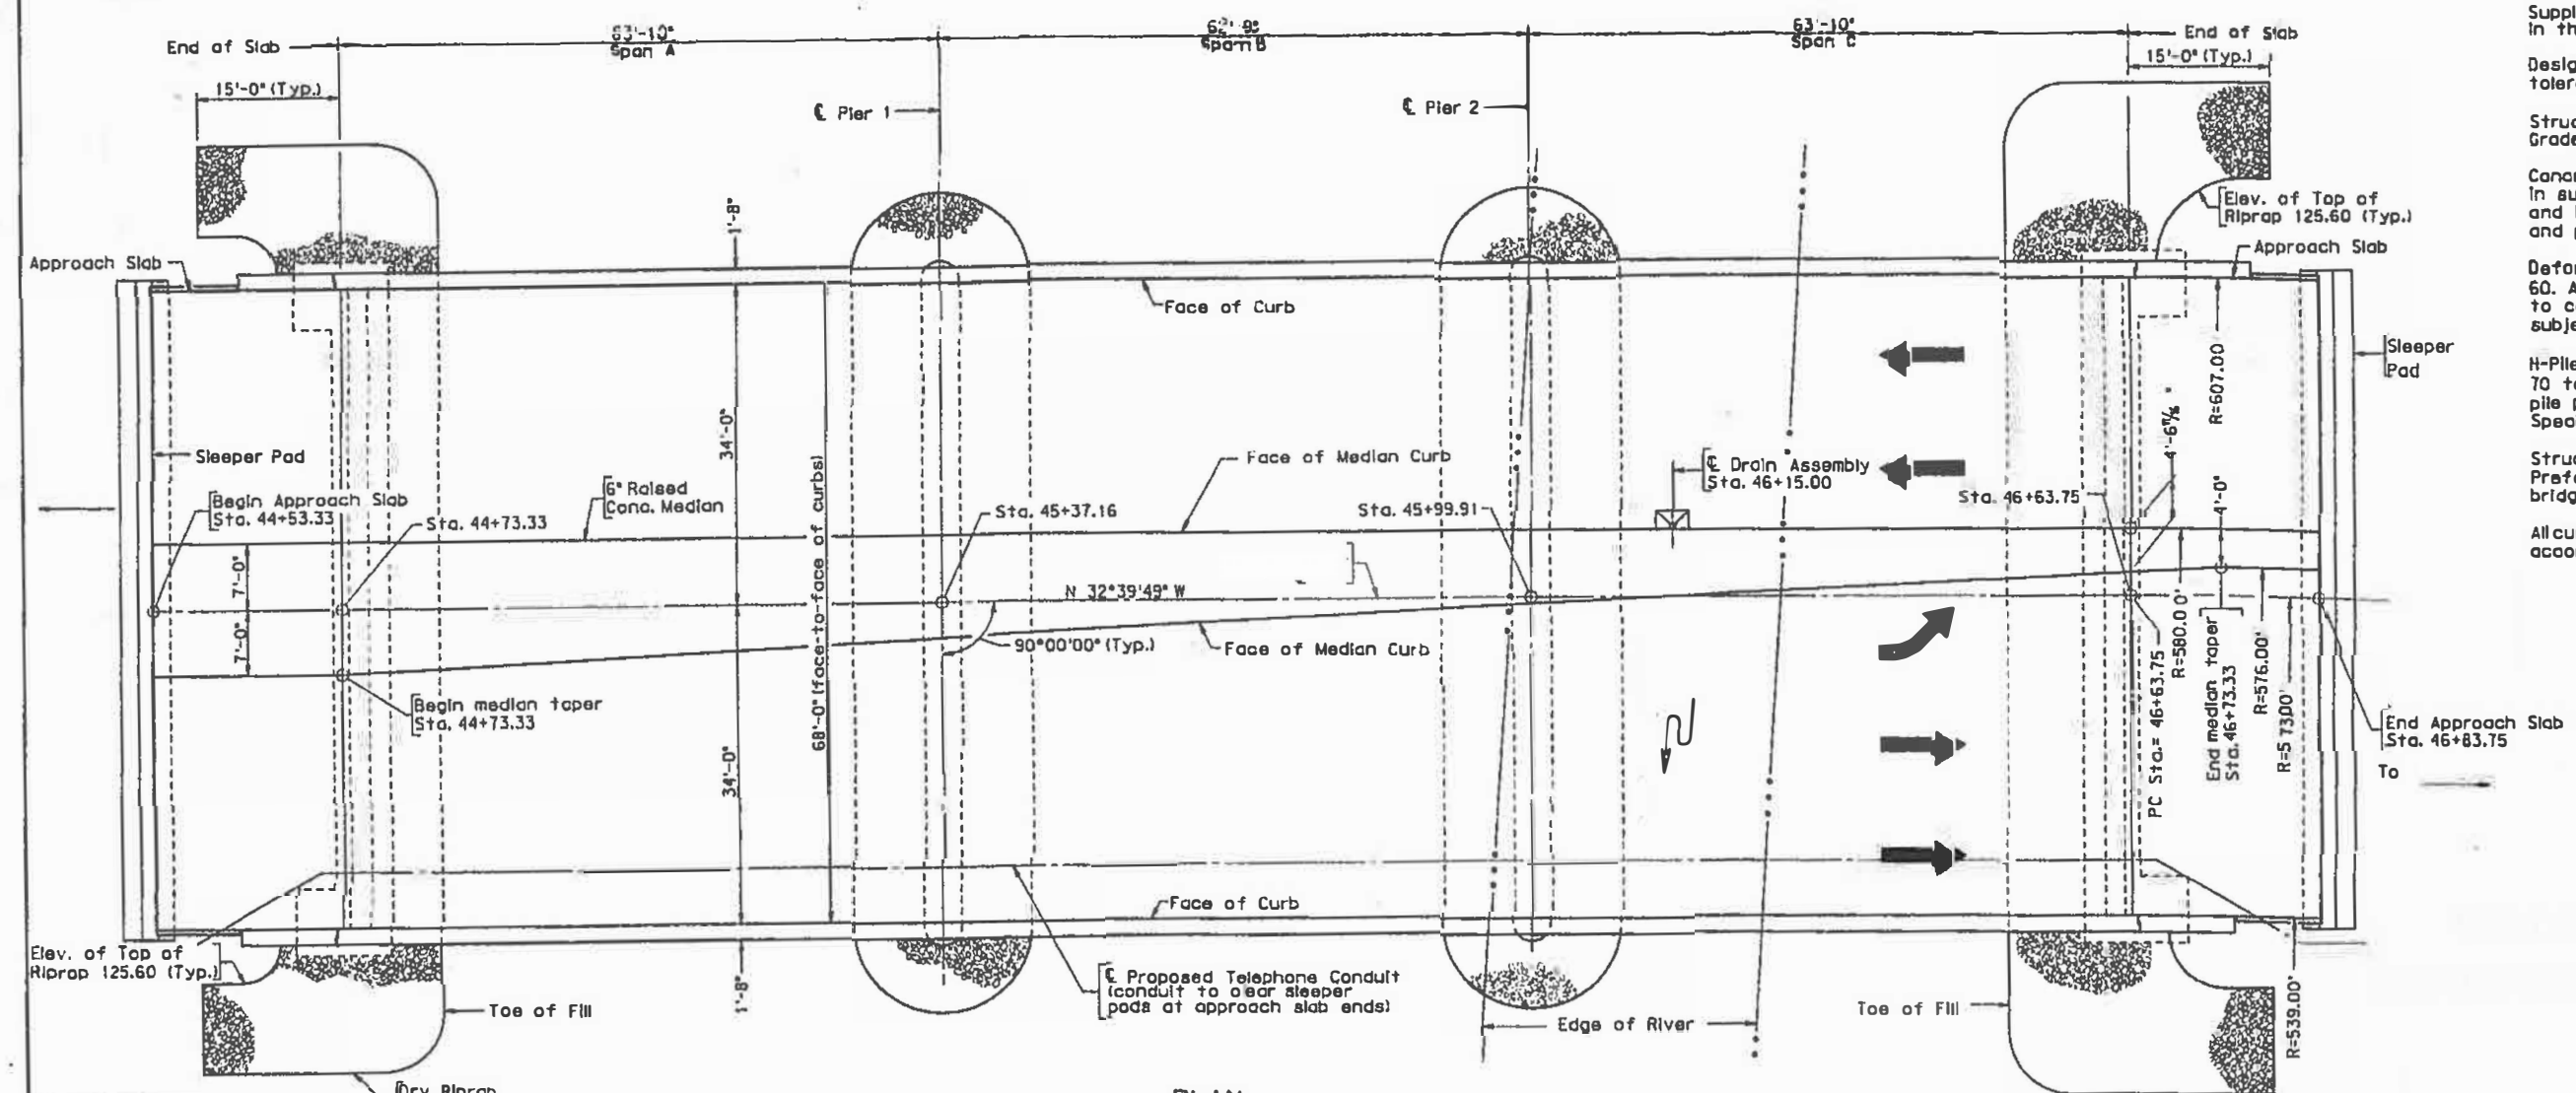

The Bridge As-Built Plans and corresponding BrDR Models are provided for example only and may not represent the modeling techniques used by your agency.

No.	Description	Date
REVISIONS		
For Table of Revisions, see Sheet 2.		

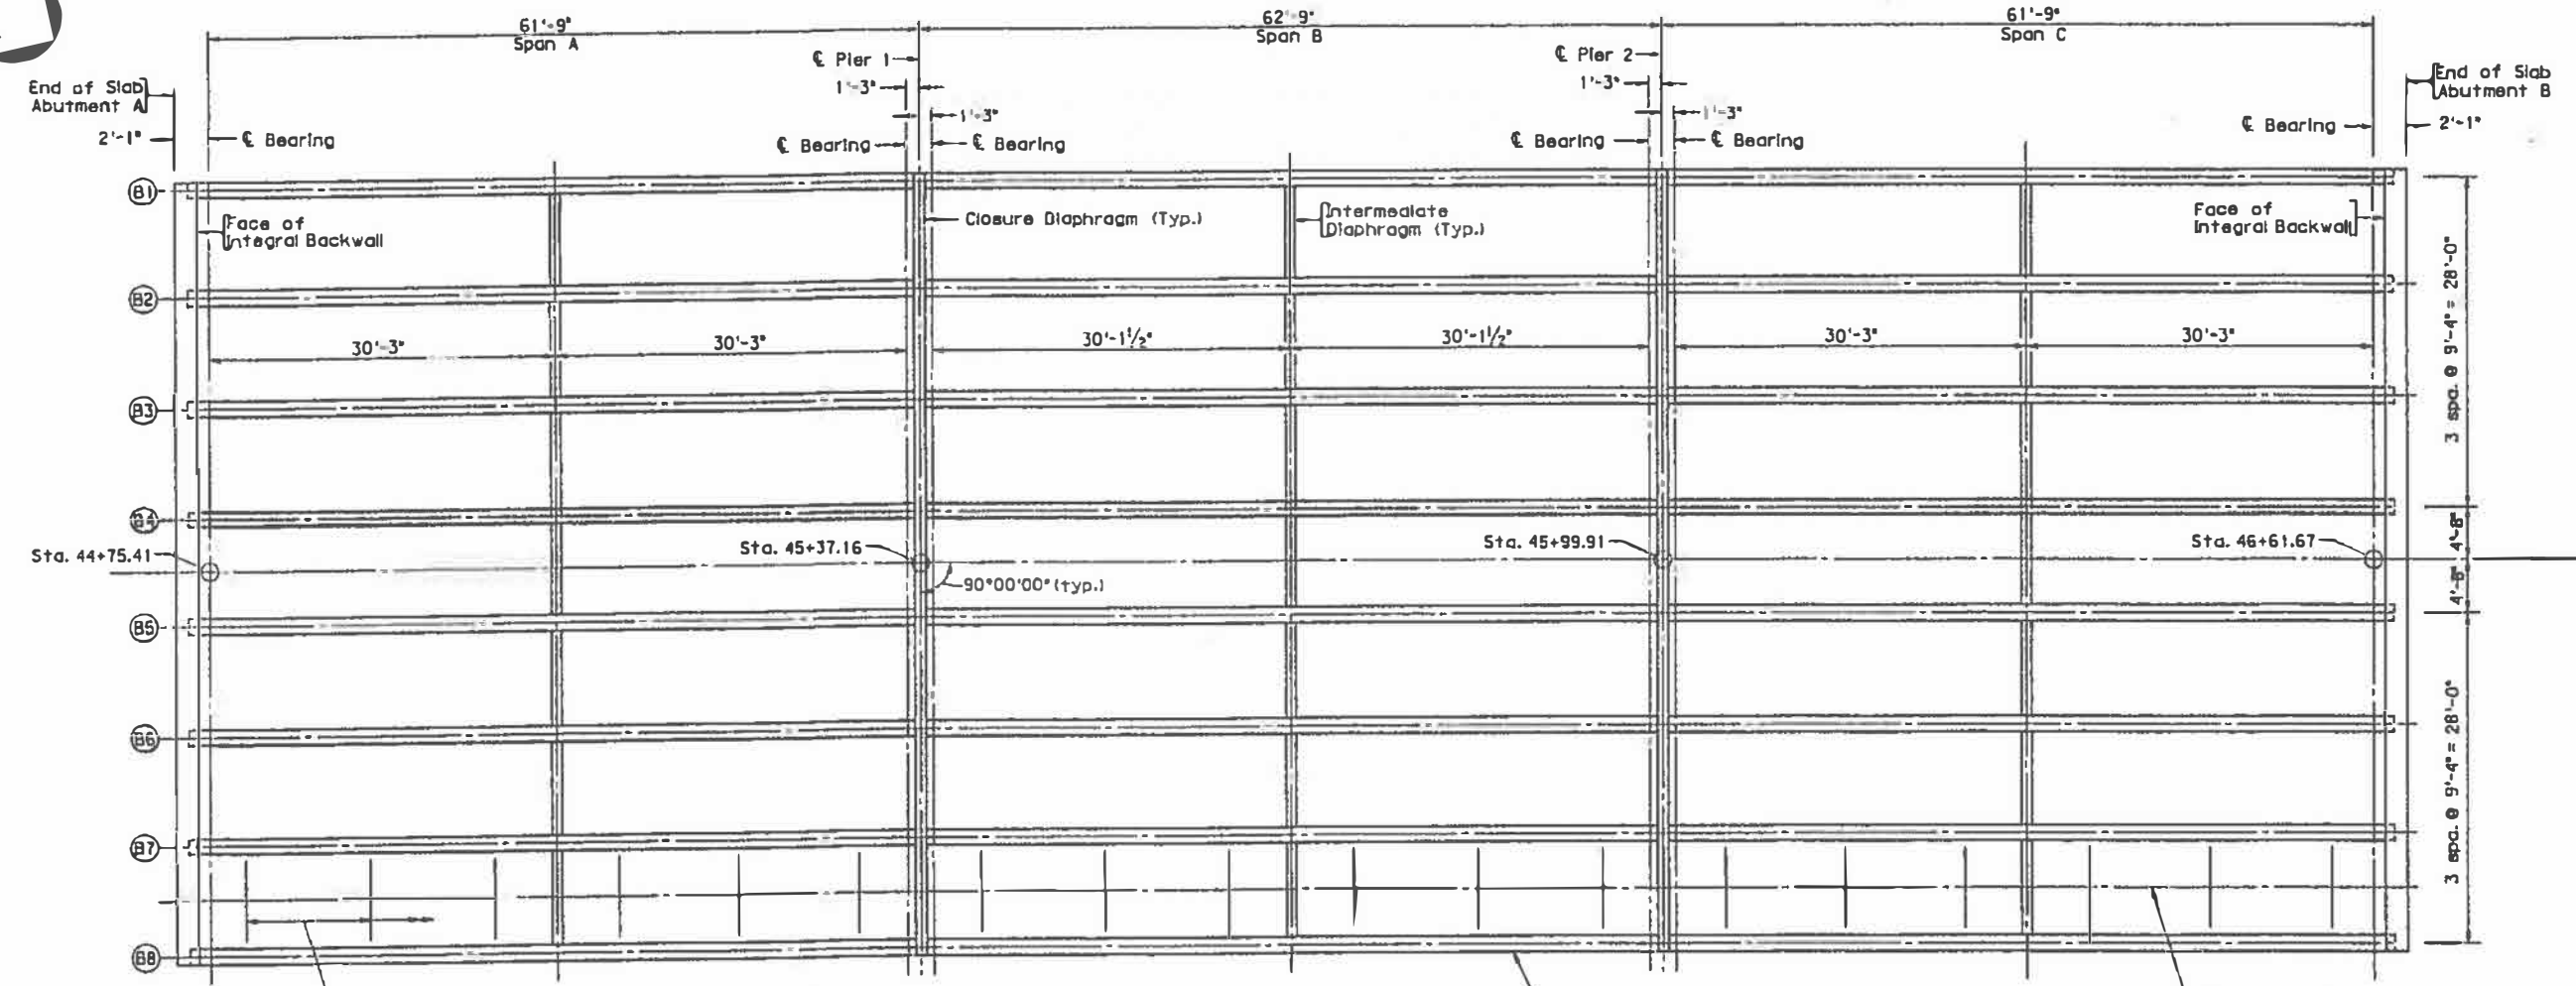

ERECTION DIAGRAM
Scale: 1/8" = 1'-0"


Span	Beam	Points				
		1	2	3	4	5
Span A	1	128.65	129.00	129.34	129.65	129.94
	2	128.84	129.16	129.45	129.73	129.98
	3	129.03	129.31	129.57	129.81	130.03
	4	129.22	129.46	129.69	129.90	130.08
	5	129.21	129.44	129.65	129.84	130.01
	6	129.02	129.25	129.46	129.65	129.81
	7	128.83	129.05	129.26	129.45	129.62
	8	128.63	128.86	129.07	129.26	129.43
Span B	1	129.98	130.25	130.50	130.72	130.93
	2	130.03	130.26	130.47	130.66	130.83
	3	130.07	130.26	130.44	130.60	130.74
	4	130.11	130.27	130.41	130.54	130.64
	5	130.03	130.18	130.30	130.41	130.49
	6	129.84	129.98	130.11	130.21	130.30
	7	129.65	129.79	129.91	130.02	130.10
	8	129.45	129.60	129.72	129.83	129.91
Span C	1	130.96	131.15	131.32	131.46	131.59
	2	130.86	131.01	131.14	131.25	131.34
	3	130.76	130.87	130.97	131.04	131.10
	4	130.65	130.73	130.79	130.83	130.85
	5	130.51	130.57	130.61	130.62	130.61
	6	130.31	130.37	130.41	130.41	130.36
	7	130.12	130.18	130.22	130.20	130.12
	8	129.92	129.98	130.03	129.99	129.87

Location	Live Load + 1 (Service Load)		Non-Composite DL (Service Load)		Composite DL (Service Load)		Release Stress at 0.4 L		Final Stress (Pos. Mom.)**				Final Stress (Neg. Mom.)				
	Max. M	Max. V	Max. M	Max. V	Max. M	Max. V	Top	Bottom	P/S+DL+LL		P/S+DL		P/S+DL+LL		P/S+DL		
	k-ft	k	k-ft	k	k-ft	k	psi	psi	psi	psi	psi	psi	psi	psi	psi	psi	
Span A & C																	
CL Brg. Abut A	Interior Beam	72.8	58.4	0.0	54.0	12.4	9.8	-----	-----	-60.8	626.5	-77.8	707.4	-242.2	1489.3	-118.4	900.4
	Exterior Beam	52.1	41.8	0.0	47.3	10.2	8.0	-----	-----	-61.9	644.5	-77.1	703.6	-229.4	1295.9	-118.7	865.5
Midspan	Interior Beam	682.3	33.7	840.4	1.5	116.3	2.9	-----	-----	1358.8	-210.1	1199.5	547.7	1157.6	746.7	1199.5	547.7
	Exterior Beam	488.2	24.1	726.4	0.7	95.5	2.3	-----	-----	1079.6	216.5	937.2	770.3	899.7	915.8	937.2	770.3
CL Brg. Pier 1	Interior Beam	-530.3	69.5	0.0	56.1	-161.3	15.5	-----	-----	-60.8	626.5	-77.8	707.4	-242.2	1489.3	-118.4	900.4
	Exterior Beam	-379.5	49.8	0.0	48.3	-132.4	12.7	-----	-----	-61.9	644.5	-77.1	703.6	-229.4	1295.9	-118.7	865.5
Span B																	
CL Brg. Pier 1	Interior Beam	-480.6	63.3	0.0	53.9	-145.2	12.6	-----	-----	-94.0	783.2	-114.4	880.0	-226.6	1413.9	-114.4	880.0
	Exterior Beam	-343.9	45.3	0.0	47.1	-119.3	10.3	-----	-----	-96.5	777.6	-114.6	848.3	-215.0	1238.5	-114.6	848.3
Midspan	Interior Beam	588.5	26.7	833.7	1.5	43.8	0.0	-----	-----	1307.0	-20.9	1169.6	632.7	1117.9	878.5	1169.6	632.7
	Exterior Beam	421.1	19.1	720.5	0.8	36.0	0.0	-----	-----	1031.2	364.4	908.4	842.1	862.2	1021.7	908.4	842.1
CL Brg. Pier 2	Interior Beam	-480.8	63.3	0.0	53.9	-145.2	12.6	-----	-----	-94.0	783.2	-114.4	880.0	-226.6	1413.9	-114.4	880.0
	Exterior Beam	-344.0	45.3	0.0	47.2	-119.3	10.3	-----	-----	-96.5	777.6	-114.6	848.3	-215.0	1238.5	-114.6	848.3


Note:
Spacing of supports for the telephone cable system is not shown. See telephone conduit for actual spacing.

References:
1. For prestressed girder details, see sheet 10.
2. For diaphragm details, see sheet 10.
3. For bearing details, see sheet 11.
4. For integral backwall details, see sheets 6 & 7.
5. For telephone conduit details, see sheet 11.


* Maximum Moments at End Spans may not be at midspan.
** Positive Moment does not include creep and shrinkage.

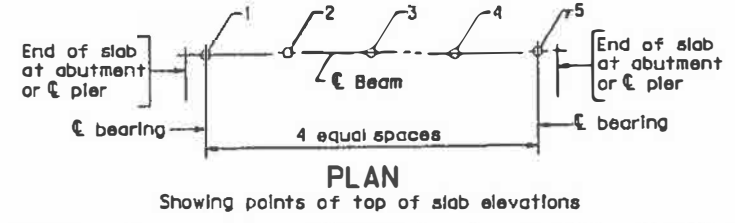


No.	Description	Date	Date	Plan No.
Revisions				

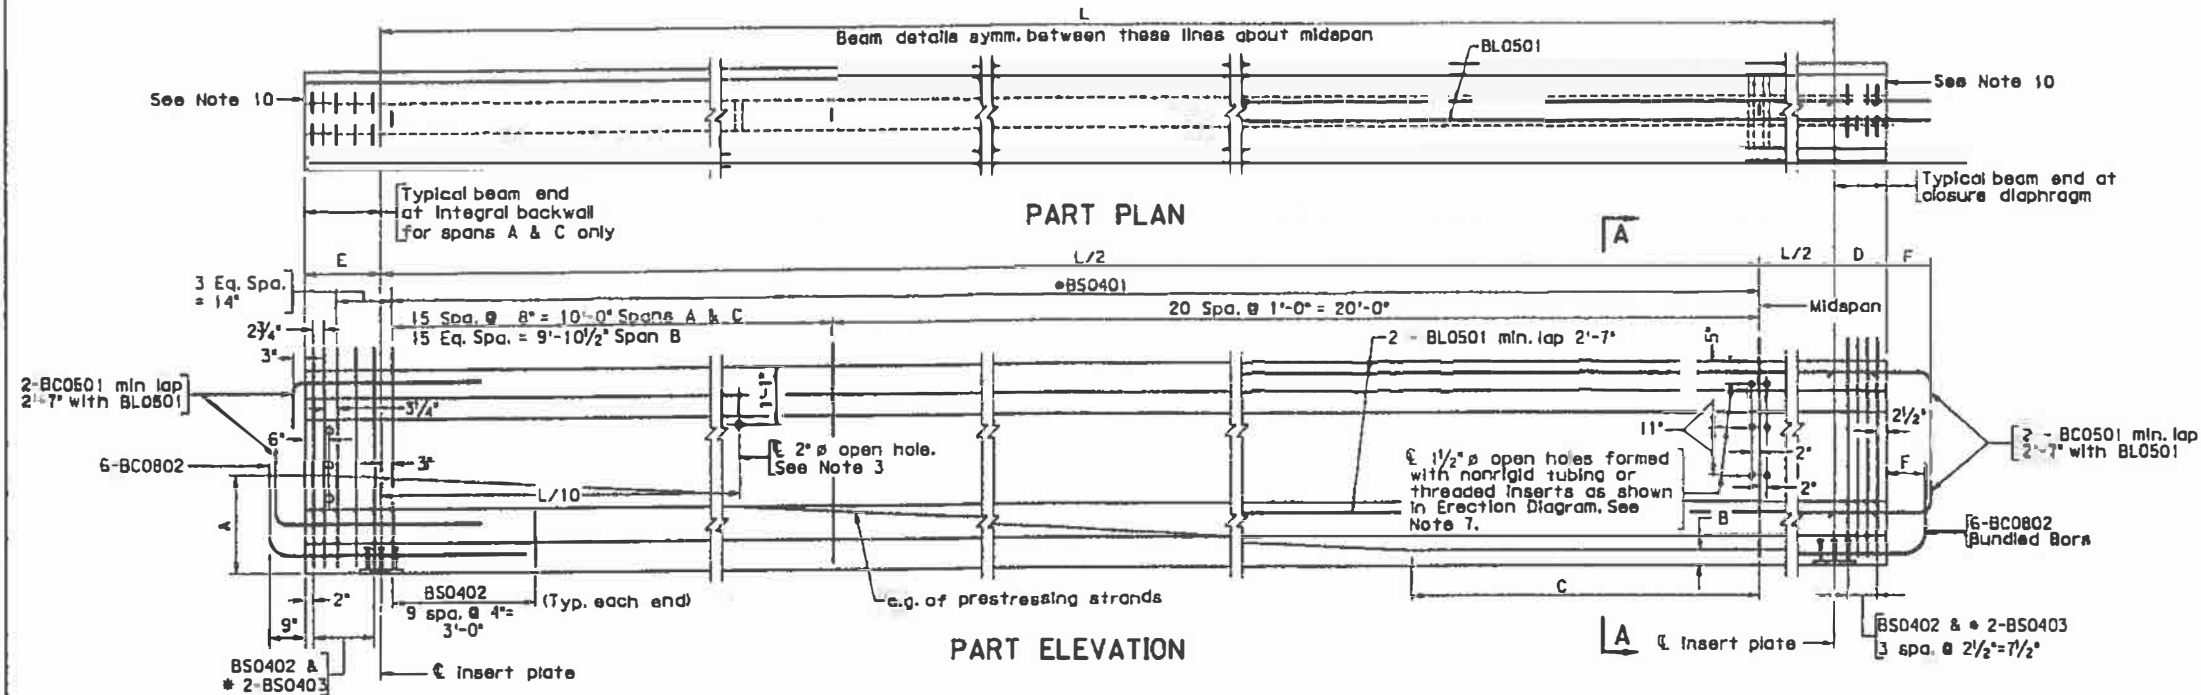


- Notes:
- 1) At end diaphragm use 1" deep recesses around local groups with 2" minimum edge clearance and fill with p applied mortar immediately after clipping strands. An epoxy mortar covering the ends of strands with a min thickness of 1/8" may be used as an alternate. Strands should be before mortar is applied. After mortar is allowed to cure entire end of beam shall be covered with epoxy type
 - 2) For reinforcing steel, prestressing strands and dimensions shown in the exterior beam, see interior beam.
 - 3) Beams shall have 2" ø open holes formed with nonrigid on stream crossings. Holes may be slightly shifted to forcing bars and strands.
 - 4) Threaded insert, when embedded shall develop full strength 1/8" threaded bolt (ASTM A307).
 - 5) All prestressing strands shall be low-relaxation, grade 2 uncoated.
 - 6) For details of insert plate, see sheet 11.
 - 7) For location of closure and intermediate diaphragms, see Diagram on sheet 8.
 - 8) The Contractor, after a written approval from the Engineer use different prestressing strand arrangement provide the total prestressing force and its o.g. are the same on the plans.
 - 9) 2 - 1/2" ø strands stressed to 1000 lbs. may be substituted - #5 bars.
 - 10) At closure diaphragm and integral backwall, end strands 1" from beam after clipping. End of beam shall be reinforced in accordance with Section 405.05 of the Road and Bridge Specifications.
 - 11) Top of beam to be roughened to a full amplitude of
 - 12) All reinforcing bar dimensions except for bending diagram centers of bars.
 - 13) 3/4" ø inserts for telephone conduit supports not shown sheet 13 for details.

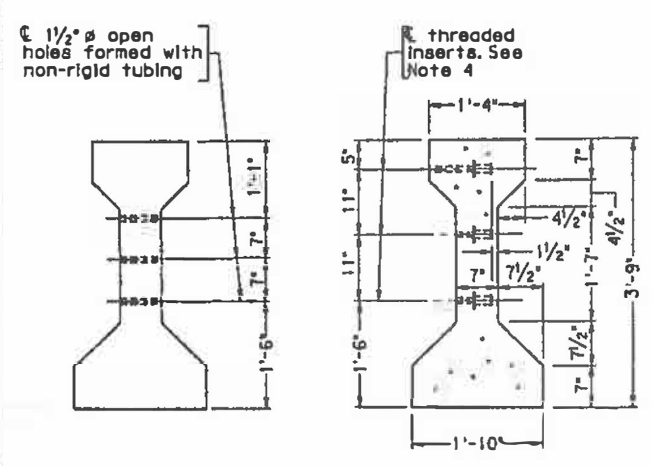

END VIEW SECTION A-A
EXTERIOR BEAM
See Note 2

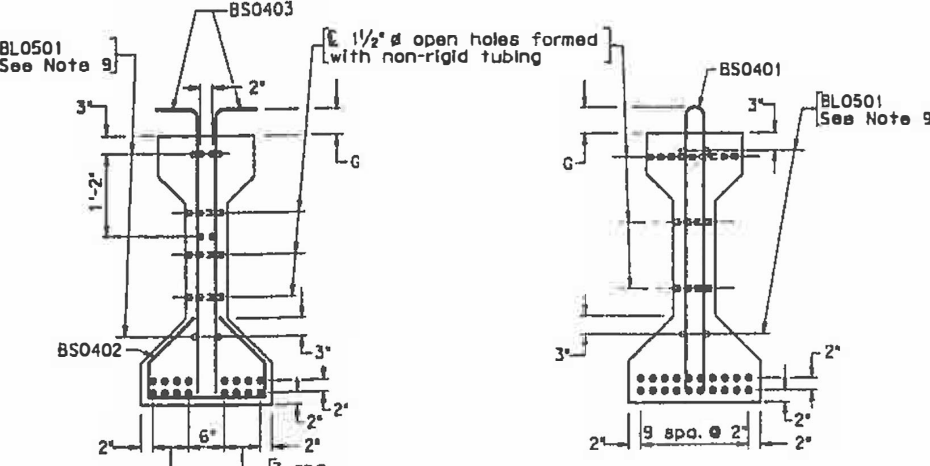


END VIEW SECTION A-A
INTERIOR BEAM
For dimensions not shown, see Exterior Beam.
For placement of BC Series bars see sheet 10.

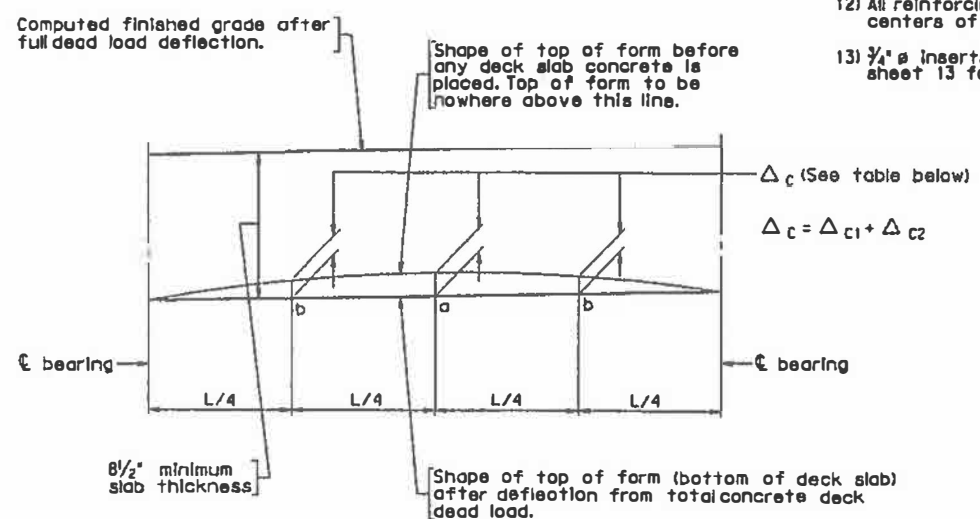


Adjustment of deck slab forms to correct for dead load deflections shall be made by varying thickness of concrete bolsters between slab and beam without alteration of slab thickness. Longitudinal screed should be set above final finished grade by amounts = Δc_2
 Δc_1 = Deflection of beam from dead load of concrete deck slab, bolsters and diaphragms and does not include the deflection of the beam from its own weight.
 Δc_2 = Deflection of composite section from dead load (e.g. parapet and curb added after deck slab is cast).

ANTICIPATED DEAD LOAD DEFLECTION**					
Beams	At a		At b		
	Δc_1	Δc_2	Δc_1	Δc_2	
Spans A & C	Beams 2 thru 7	3/16"	1/16"	3/16"	1/16"
	Beams 1 & 8	3/16"	1/16"	1/16"	1/16"
Span B	Beams 2 thru 7	3/16"	0	3/16"	0
	Beams 1 & 8	3/16"	0	1/16"	0

DEAD LOAD DEFLECTION DIAGRAM
** Deflection shown are actual deflections without multipliers.

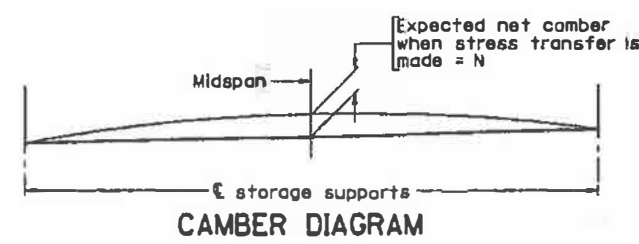


CAMBER DIAGRAM

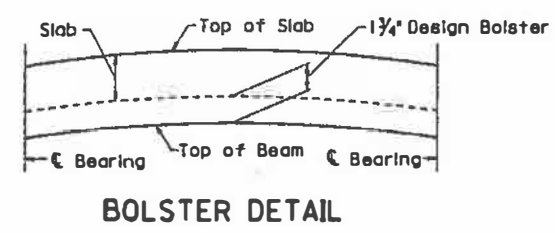

BOLSTER DETAIL

DIMENSION TABLE											
Beam	Prestr. force per strand lb.	No. and size of strands/beam	Net camber N in.	A ft.-in.	B in.	C ft.-in.	D in.	E in.	F in.	G in.	L ft.-in.
Spans A & C	30,980	20 - 1/2" ø	7/8"	9 3/8"	3"	6'-3"	9 1/2"	19"	8 3/8"	6 1/4"	60'-6"
Span B	30,980	20 - 1/2" ø	7/8"	9 3/8"	3"	6'-2"	9 1/2"	—	8 3/8"	6 1/4"	60'-3"

REINFORCING STEEL S			
Mark	No.	Size	Ler
BS0401	1704	#4	8'
BS0402	688	#4	4'
BS0403	416	#4	4'
BL0501	192	#5	32'
BC0501	192	#5	4'
BC0802	288	#8	8'

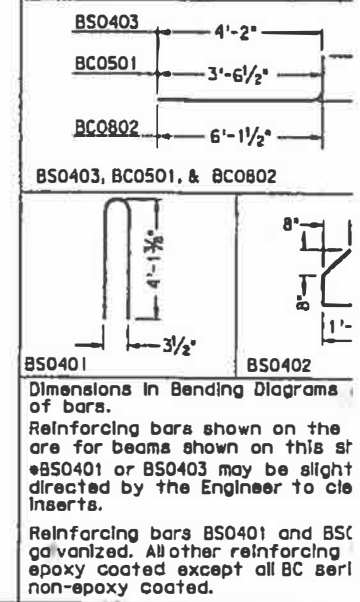













BS0403, BC0501, & BC0802

PRESTRESSED CONCRETE TYPE III

No.	Description	Date	Date	Plan No.
Revisions				

Not to Scale

FHWA REGION	STATE	FEDERAL AID ROUTE	PROJECT	STATE	PROJECT

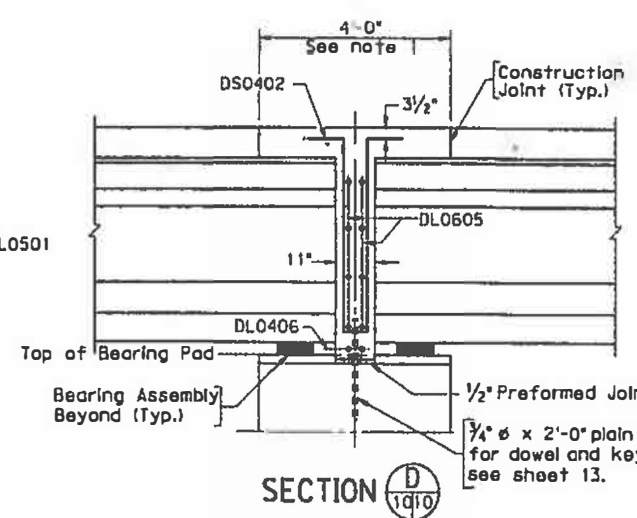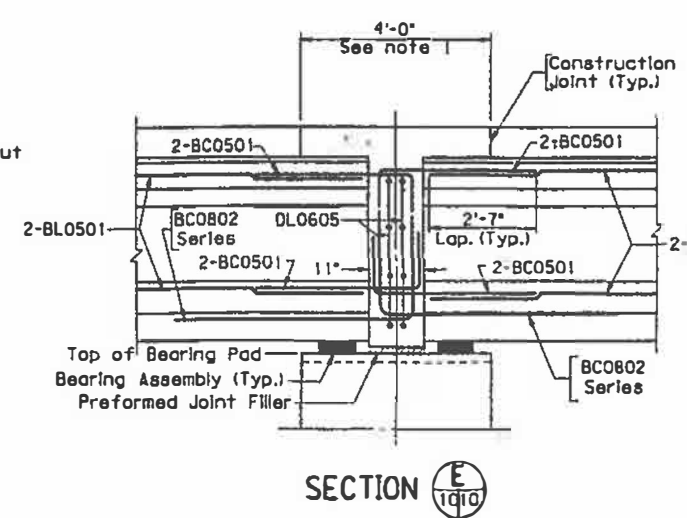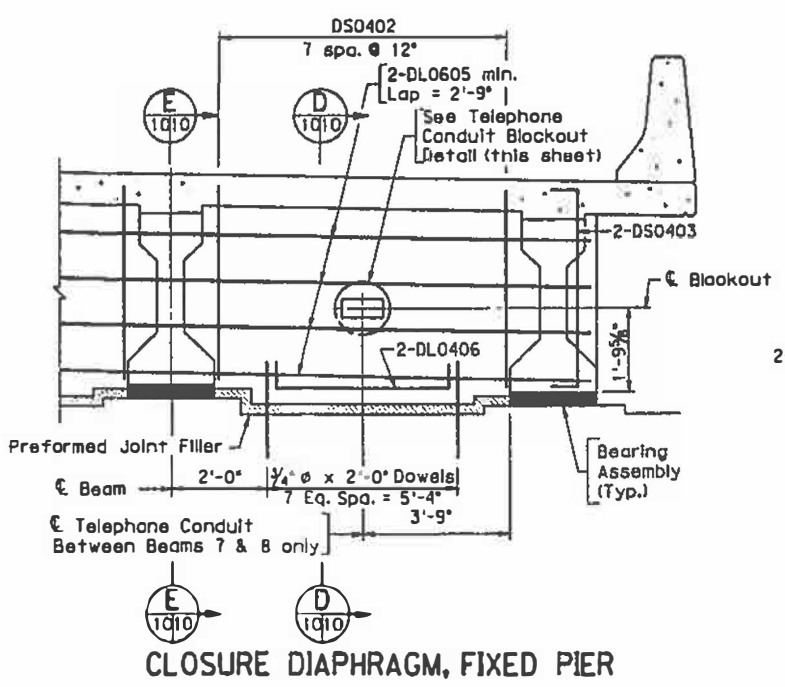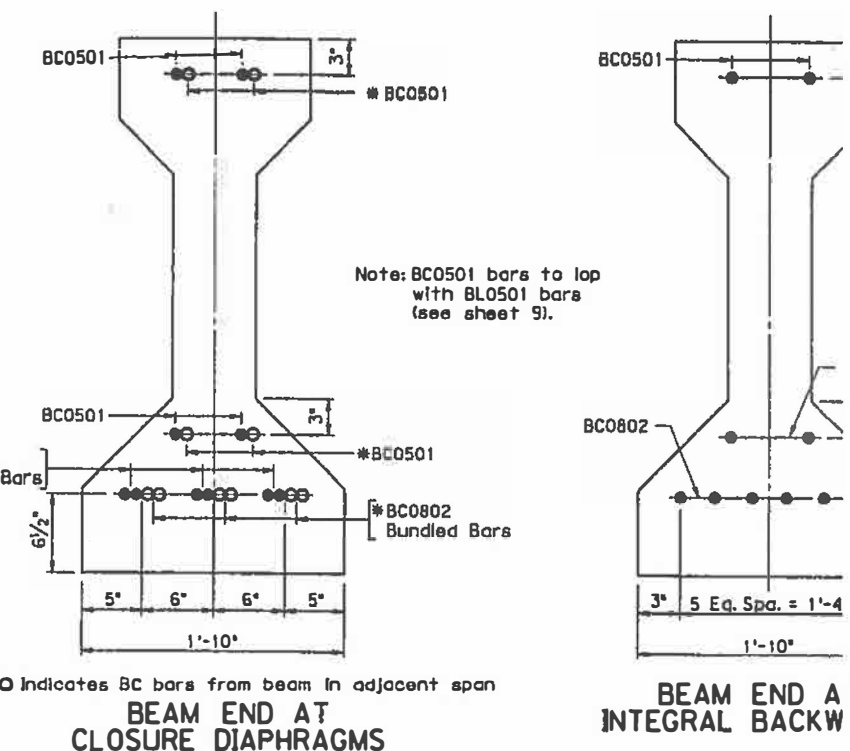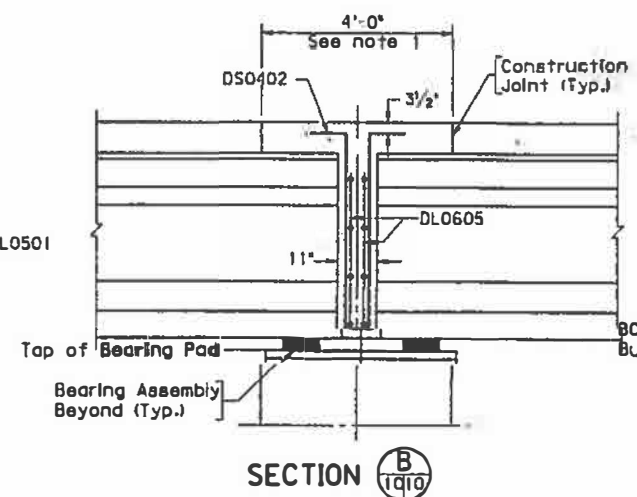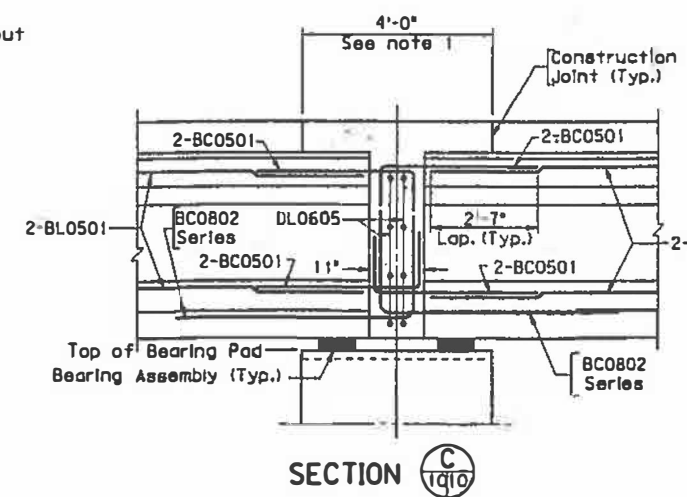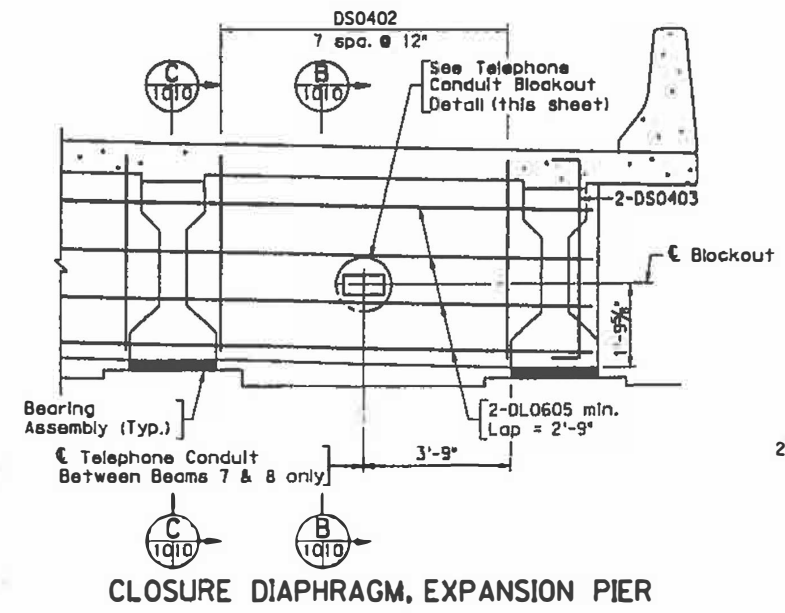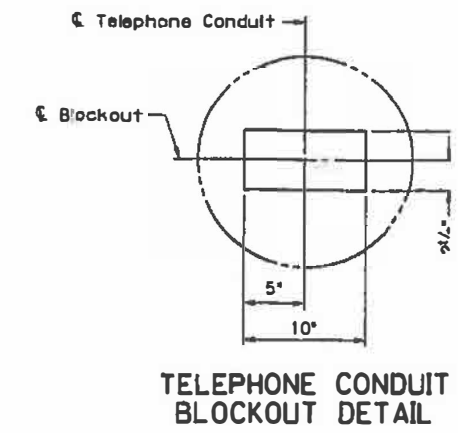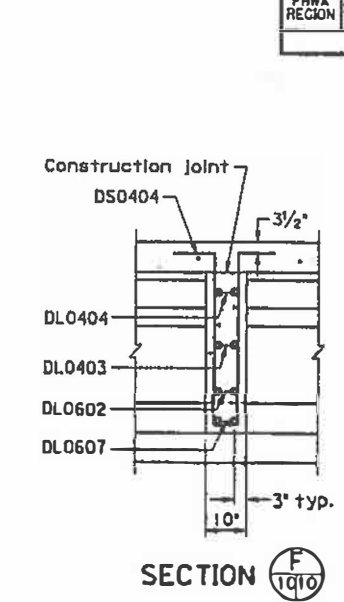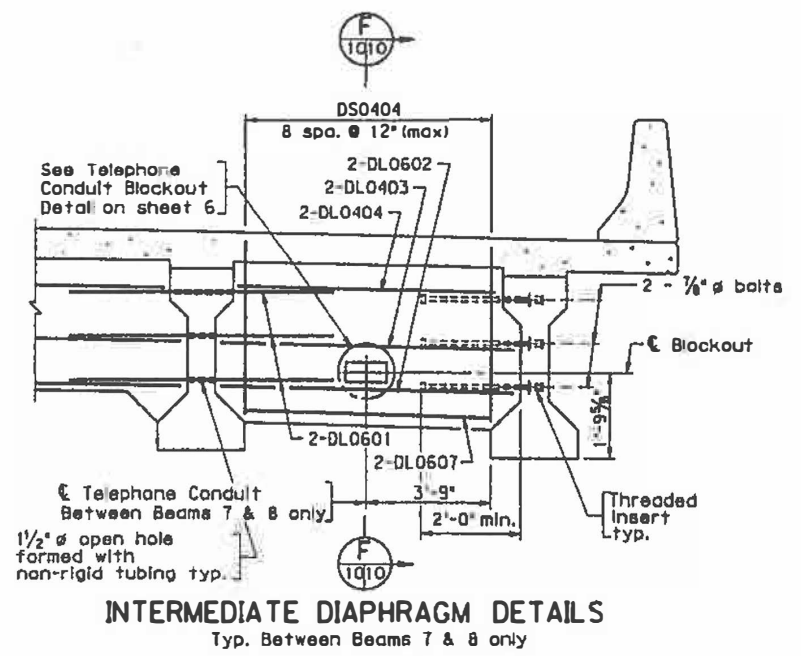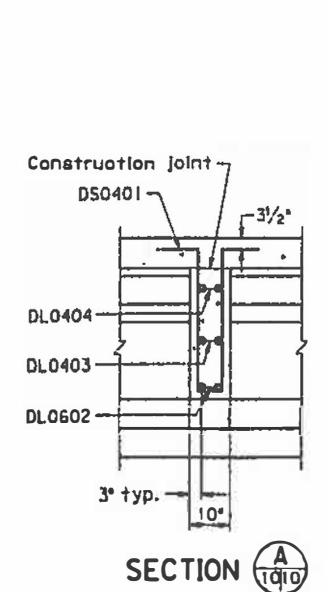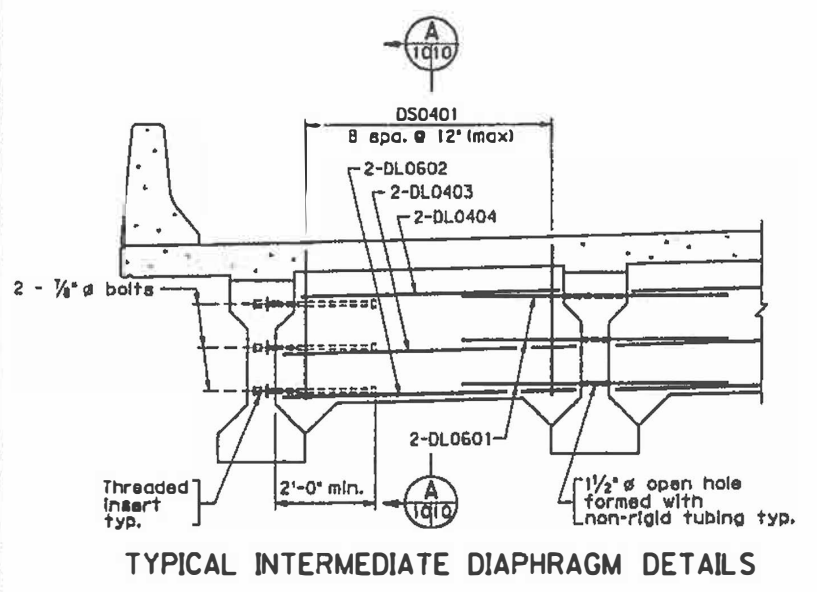

- Notes:
1. This portion of the slab shall be cast with the closure diaphragm.
 2. For details of bearing pads and bearing pad assemblies see sheet 13.
 3. Reinforcing steel in diaphragms shall be adjusted to clear conduit blockout.






No.	Description	Date	Date	Plan No.

INTERMEDIATE AND CLOSURE DIAPHRAGM DETAILS


Not to Scale (unless otherwise noted)

REGION	ROUTE	PROJECT	ROUTE	PROJECT
3	VA.			

Notes:
 Material: Elastomer - 50 durometer hardness.
 Shim - ASTM A36 or A570 mild steel.
 Elastomeric bearings shall be molded as a single unit.
 Bevel sole plates to grade. Minimum 3/4" thickness.
 Insert plate shall provide uniform bearing over its entire area. Insert plate is 1" wider than sole plate.
 In welding insert plate to sole plate, ample time shall be between weld passes to prevent heat damage to the sole plate and elastomeric pad. Elastomer shall not be at temperatures higher than 400° F.
 For closure diaphragm details, see sheet 10.
 For designation of fixed or expansion bearings, see elev on front sheet.

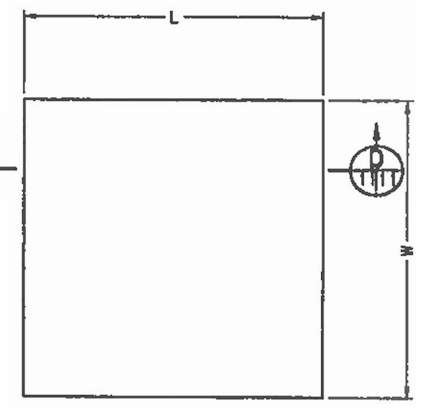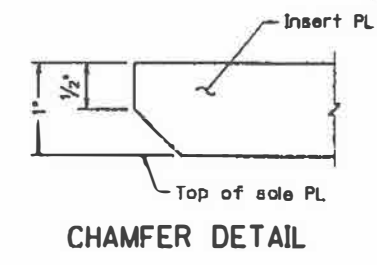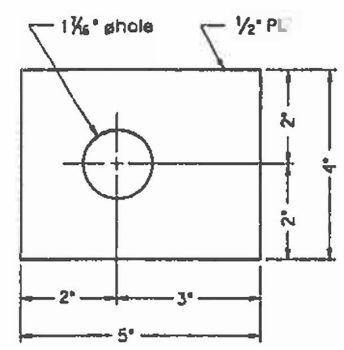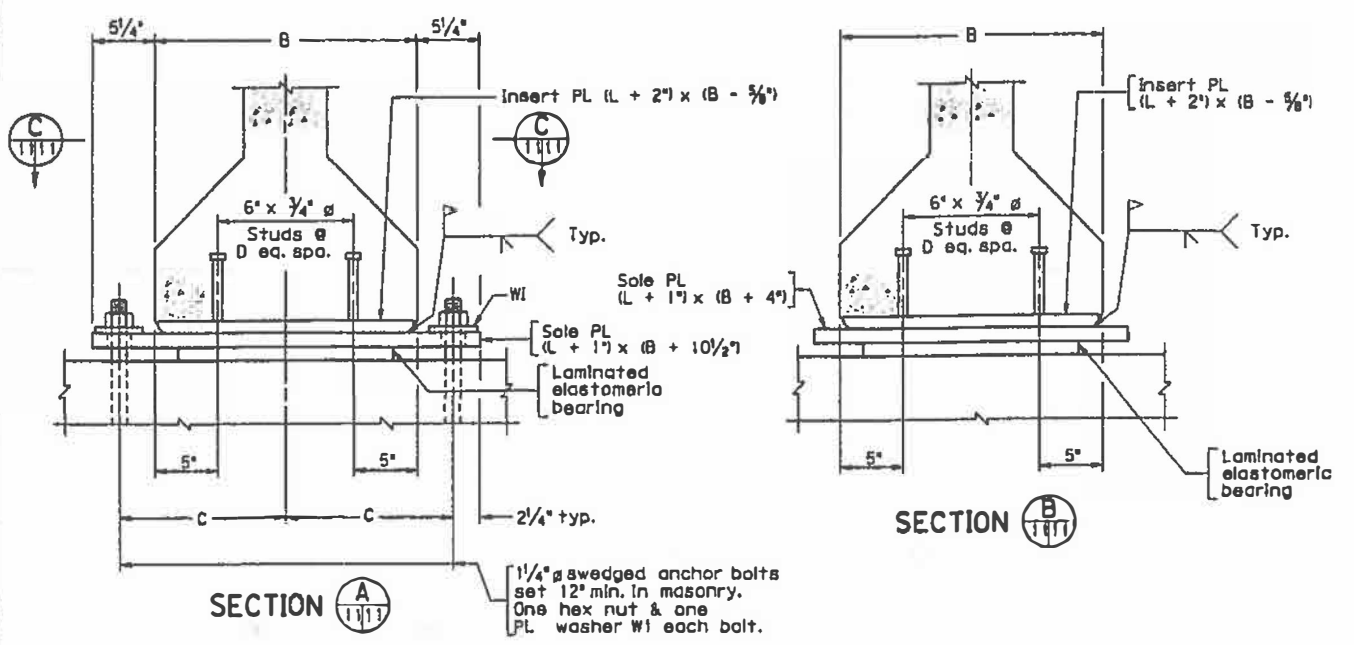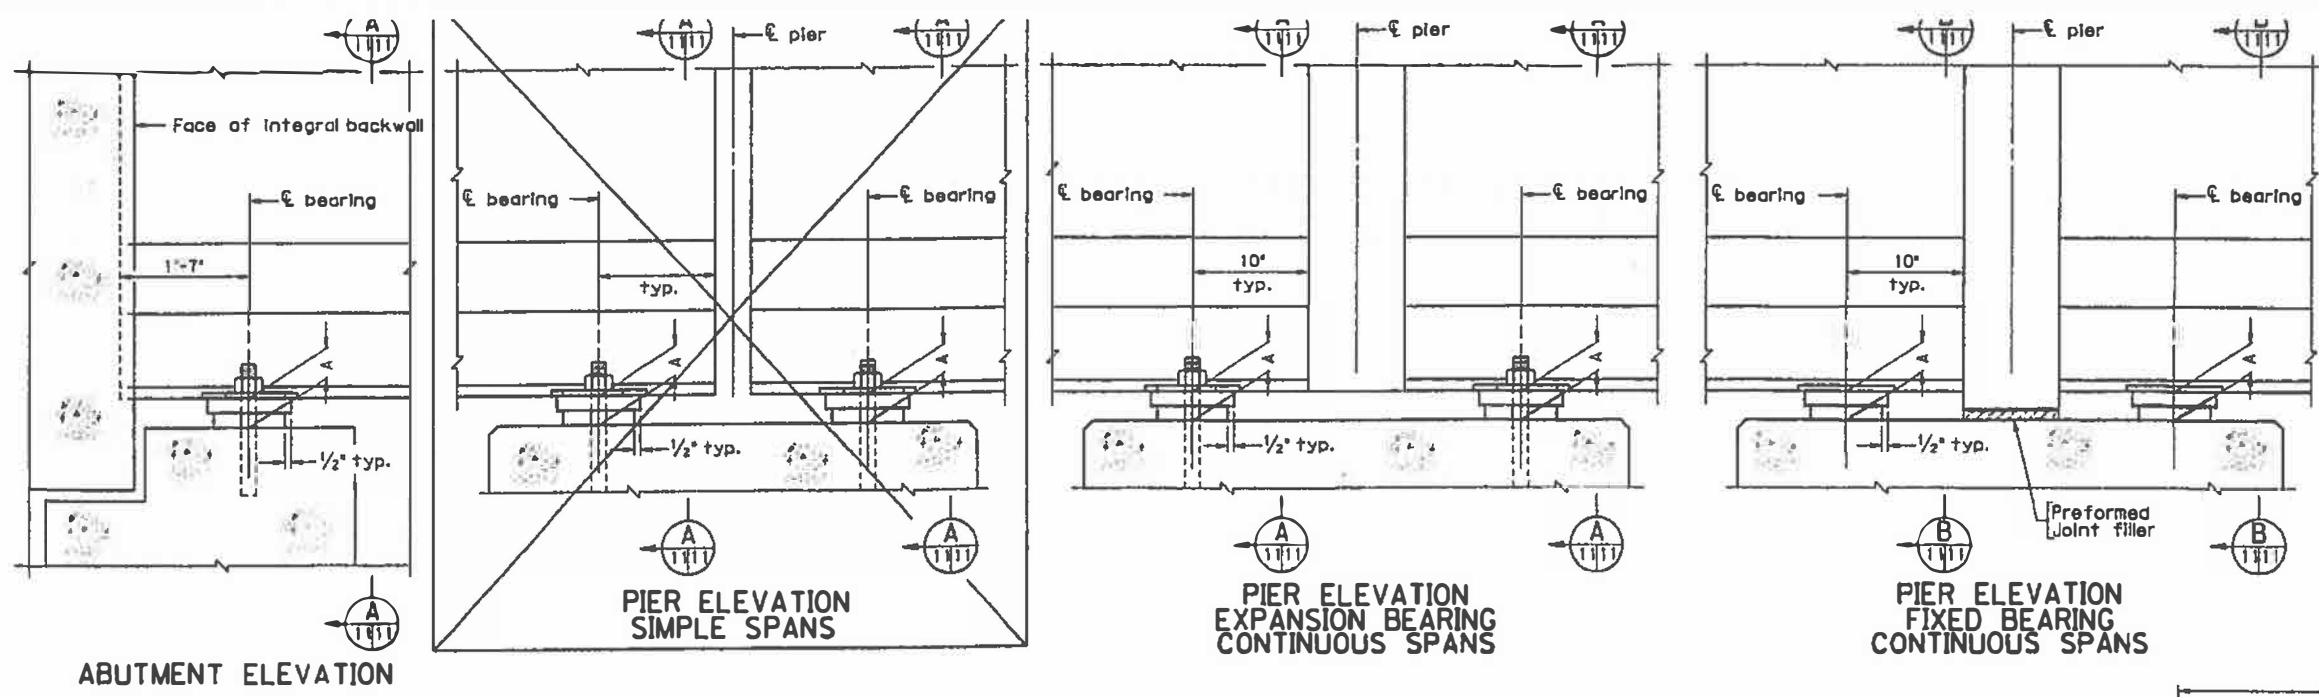


Beam Type	B	C	D
II	1'-6"	1'-0"	1
III	1'-10"	1'-2"	1
IV	2'-2"	1'-4"	2
V	2'-4"	1'-5"	3
VI	2'-4"	1'-5"	3

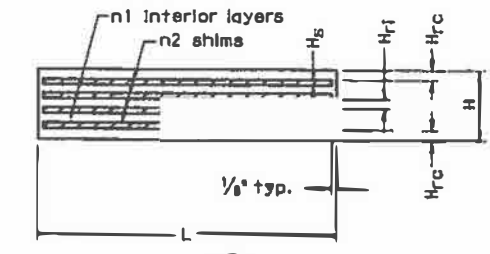

Span	Abut.	Pier	Beam Type	A	Laminated Elastomeric Bearing						Grade %
					W	L	H	H _{rc}	n1 @ H _{r1}	n2 @ H _g	
A	A	—	III	2 1/8"	16	11	1 1/8"	0.2500	2 @ 0.3519	3 @ 0.1196	1.6
A	—	1	III	2 3/8"	16	11	1 3/8"	0.2500	2 @ 0.3519	3 @ 0.1196	1.0
B	—	1	III	2 3/8"	16	11	1 3/8"	0.2500	2 @ 0.3519	3 @ 0.1196	1.0
B	—	2	III	2 7/8"	17	10	2 1/8"	0.2500	3 @ 0.3614	4 @ 0.1196	0.5
C	—	2	III	2 7/8"	17	10	2 1/8"	0.2500	3 @ 0.3614	4 @ 0.1196	0.5
C	B	—	III	3 1/8"	17	11	2 3/8"	0.2693	4 @ 0.3877	5 @ 0.1196	0

All dimensions in table are in inches.

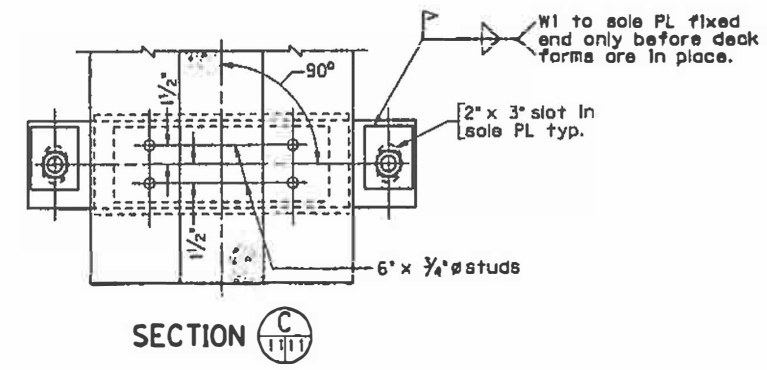


PRESTRESSED CONCRETE BEARING DETAIL				
No.	Description	Date	Designed: ..	Date
	Revisions		Drawn: ..	
			Checked: ..	
				Plan No

7-15-96
BBD-8

*Open deflection joint
1'-3" deep

ROUTE	PROJECT	ROUTE	PROJECT
-------	---------	-------	---------

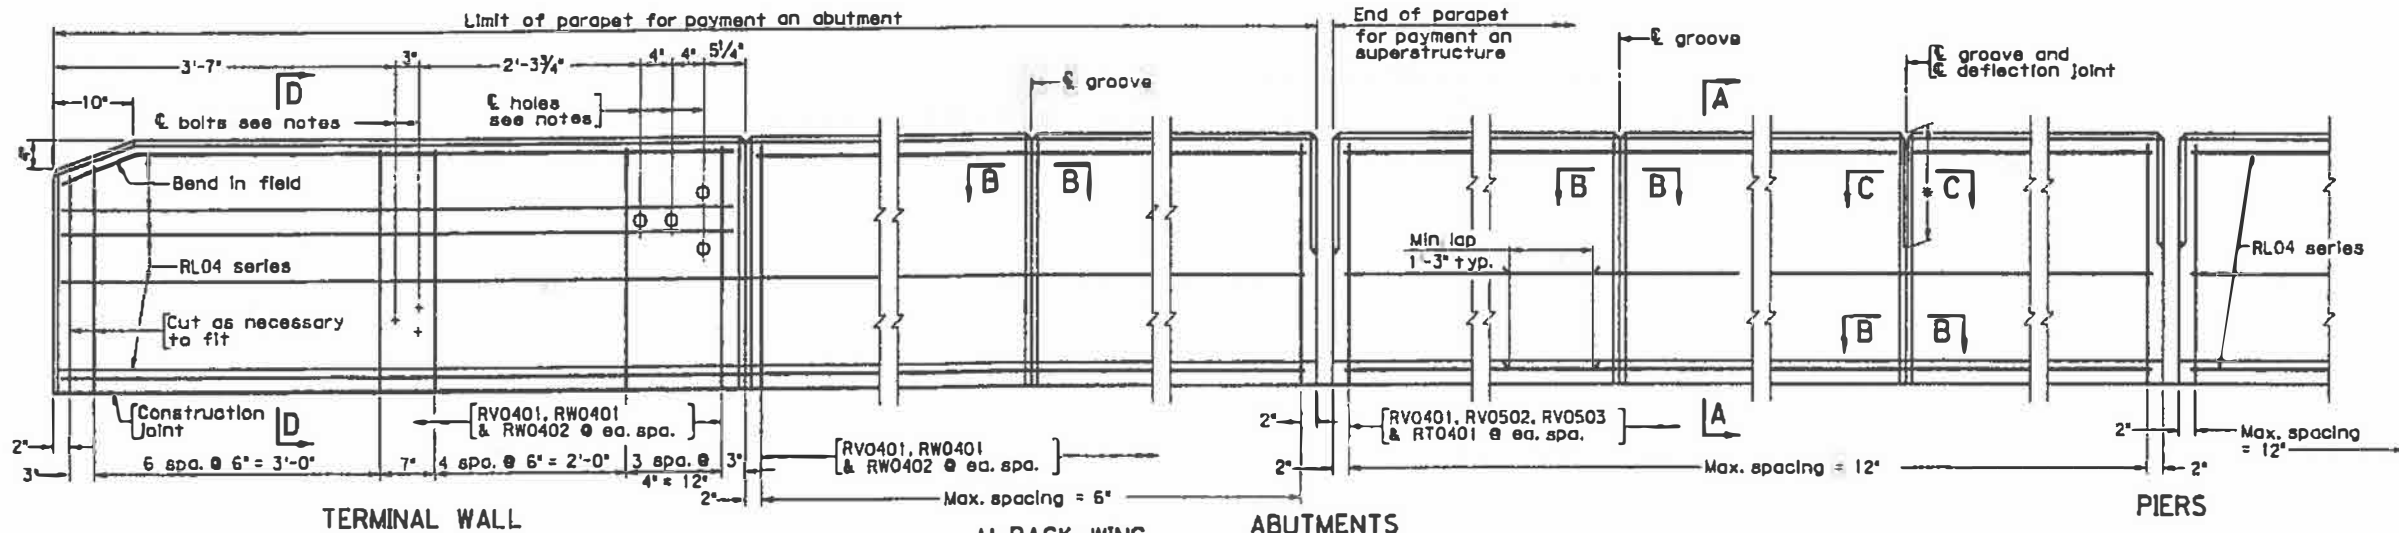

NOTES:

Rounded edges with 1" radius may be used in lieu of top of parapet.

Reinforcing bars RV0502 and RV0503 shall be galvanized. A reinforcing bar shall be epoxy coated.

Detail shown at pier is applicable when joint is in slab. It is continuous over pier, use groove and deflection joint.

Spacing of grooves to be approximately 8'-0". If lighting is used (see Bridge Conduit System), groove shall be located approximately 4'-0" from light standard. Spacing of deflection joints shall not exceed three groove spaces.

Barrier delineator size, color, and spacing to be in accordance with the Specifications. Cost of delineator to be included in price bid for parapet. Reflective surface of barrier delineator shall be facing oncoming traffic.

The Contractor shall determine all dimensions and details necessary for installation.

All concrete shall be Class A4.




For details of wingwall below construction joint, see abutment sheet(s).

Terminal walls are detailed to take guardrail attachment.

Holes, where shown, shall be formed with sleeves of 1 1/2" nominal pipe.

Bolts, where shown, shall be 3/8" dia. expansion anchor bolts to be drilled and installed when rub rails attached.

For extruded parapets: During extrusion, open joints at abutments and piers shall be formed by the use of lubricated plates or other means so that uniformity of the opening and channel is maintained. Dimension of 1" (as shown in Section thru Joint Extrusion Only) is additional deck slab that shall be cast in place at contractor's expense. Dimension(s) to face of curb shall not exceed.



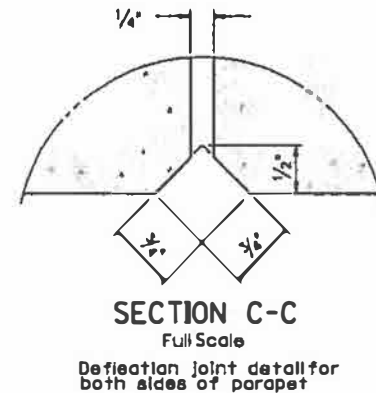
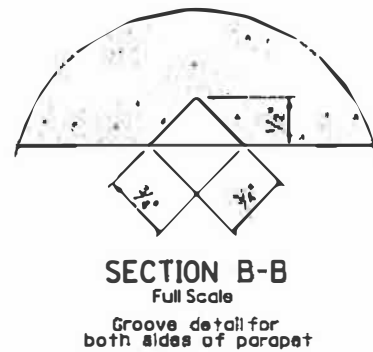
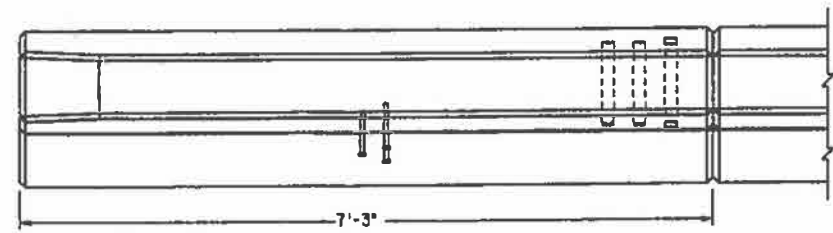


REINFORCING STEEL SCHEDULE					
RV0401	RV0502	RV0503	RW0401	RW0402	RW0401

Dimensions in bending diagram are out to out of bars, except as shown.

Mark	No.	Size	Length	Pin Ø	Lacc
RT0401		#4	3'-0"	—	Slab
RV0401		#4	5'-2"	4 1/2"	Parapet
RV0502		#5	3'-10"	3 3/4"	Parapet
RV0503		#5	2'-4"	3 3/4"	Parapet
RW0401		#4	2'-0"	3"	Terminal W
RW0402		#4	2'-5"	3"	Terminal W
RL04		#4	—	—	Parapet

Cost of all bars listed in schedule to be included in price bid for

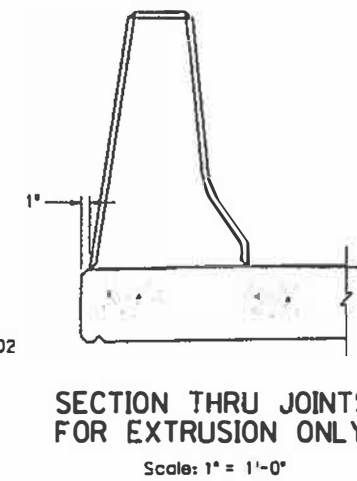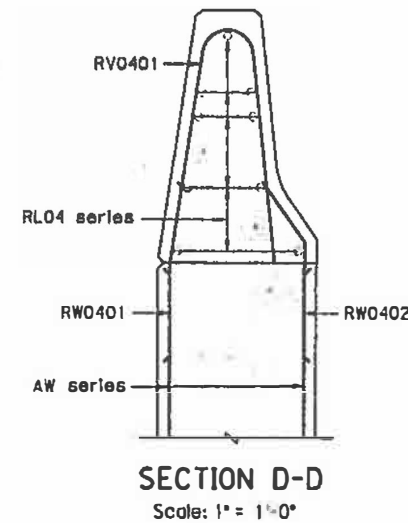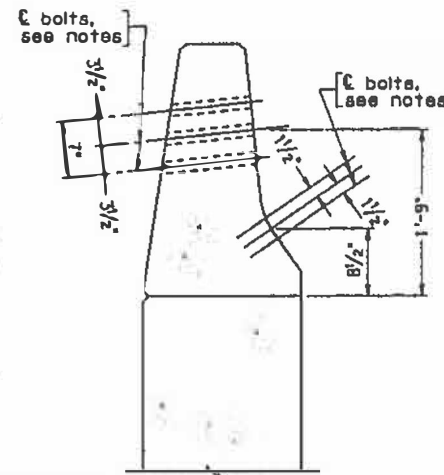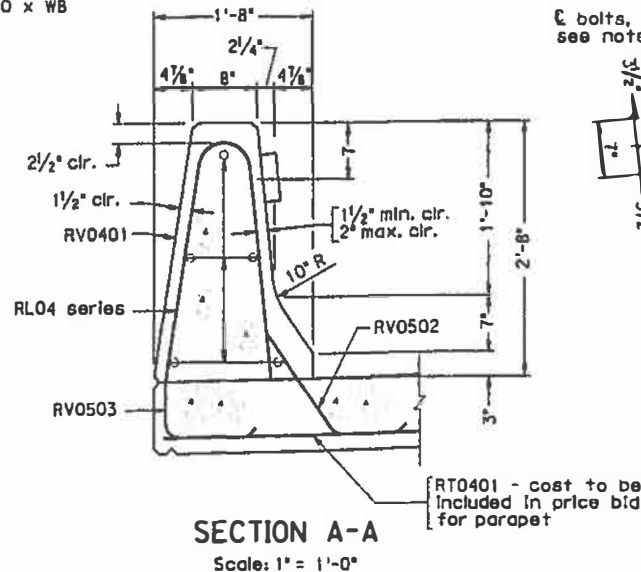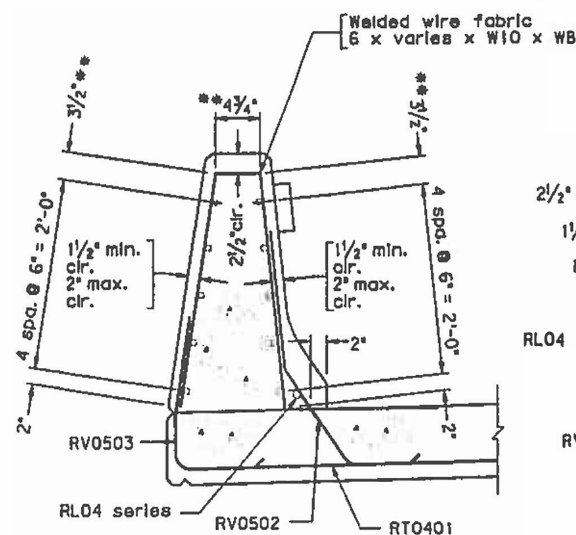

No.	Description	Date	Designed	Date	Plan No.
			Drawn:		
			Checked:		

CAST-IN-PLACE CONCRETE PARAPET (IF

2-01-99

CADD BPB-3A

- ① 4" F.R.E. duct
- ② 4" galv. steel duct
- ③ 4" PVC-B duct
- ④ PVC-galv. adaptor
- ⑤ Galv.-F.R.E. adaptor
- ⑥ F.R.E. exp. joint
- ⑦ F.R.E. look ring

***Limit of telephone conduit in bridge contract when approach slabs or drainage aprons are not used shall be the extension of the conduit a minimum of one foot behind back of backwall.

REGION	ROUTE	PROJECT	ROUTE	PROJECT
--------	-------	---------	-------	---------

NOTES:

Glass fiber reinforced epoxy (FRE) duct shall comply with D2310 and ASTM D2996, and shall be RTRP-III, except as noted herein.

Inside diameter shall be 4.00" minimum, wall thickness shall be minimum.

Duct performance shall not be impaired by exposure to ultraviolet radiation. Duct shall have fire resistance which equals requirements of U.L. 651 - Section 17.

Joints shall be positive locking, (threaded bell and spigot, bonded bell and spigot, or driven tapered bell spigot).

Expansion joints shall be sliding sleeve type, with or without rings, with provision for minimum of 6" expansion travel.

Lock rings shall be split FRE duct, minimum of 3" long, 0.010" minimum thickness, glued in place after installation of conduit.

Threaded couplings shall be used on steel conduit.


Steel fittings and rods shall be galvanized in accordance with ASTM A153.

Support angles shall be galvanized in accordance with ASTM A153.

Hanger details shown are designed to support as many ducts as shown. Dead loads used were as follows: Cables = 8.5 lbs./ft., Conduit = 0.8 lbs./ft.


Underground installation of PVC-B duct shall be in accordance with Road and Bridge Standards ECI-1 except the minimum spacing between ducts shall be 1/4".

Contractor shall space supports for the telephone conduit such that the 3/4" inserts for the H.S. bolts will not interfere with the draped strands in the prestressed concrete.

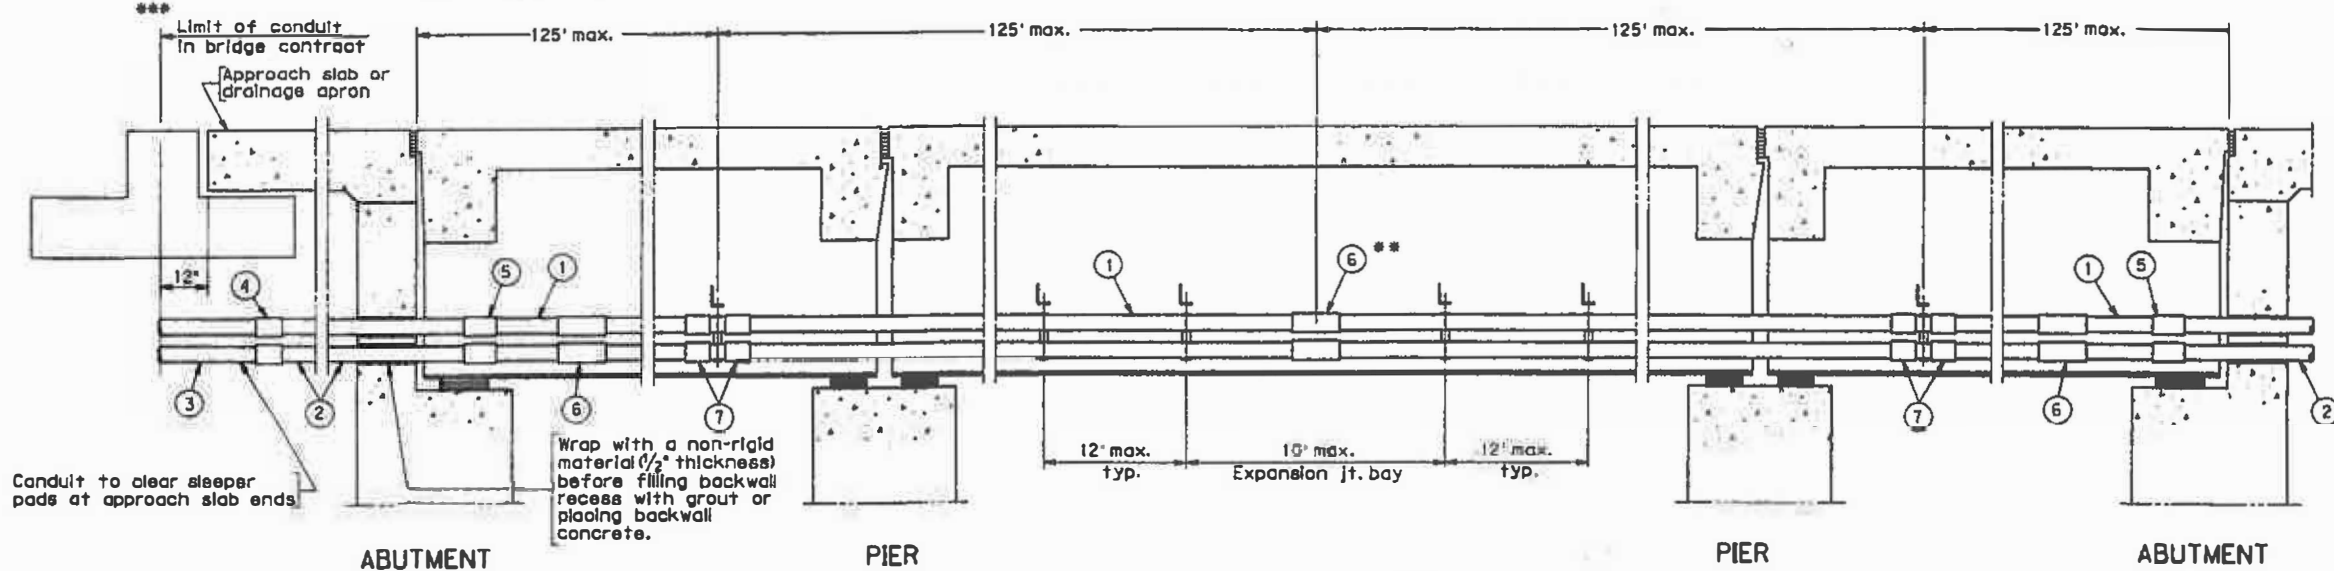


SHORT SPAN BRIDGES
Max. span L = 200'

** Not required on bridges under 250' total length.

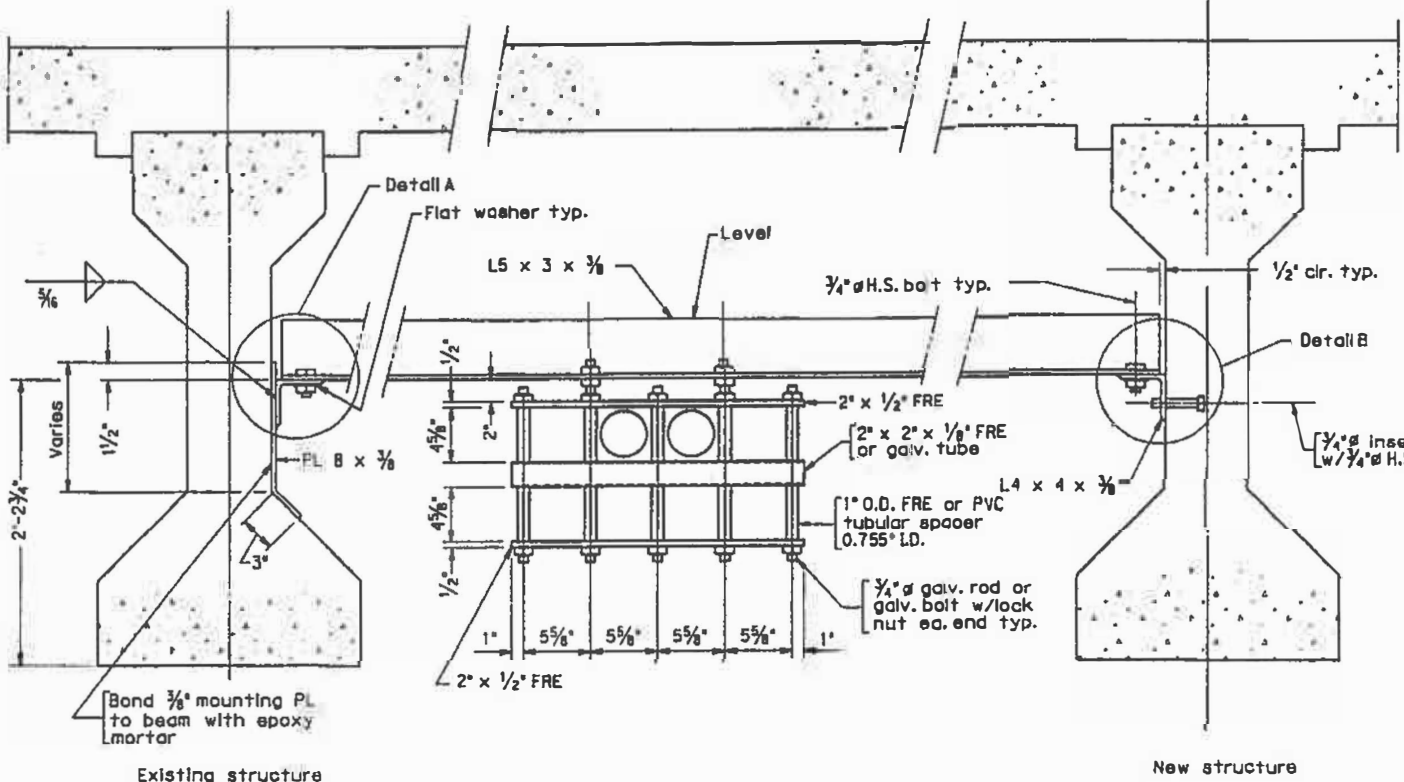


TYPICAL SUPPORT DETAIL

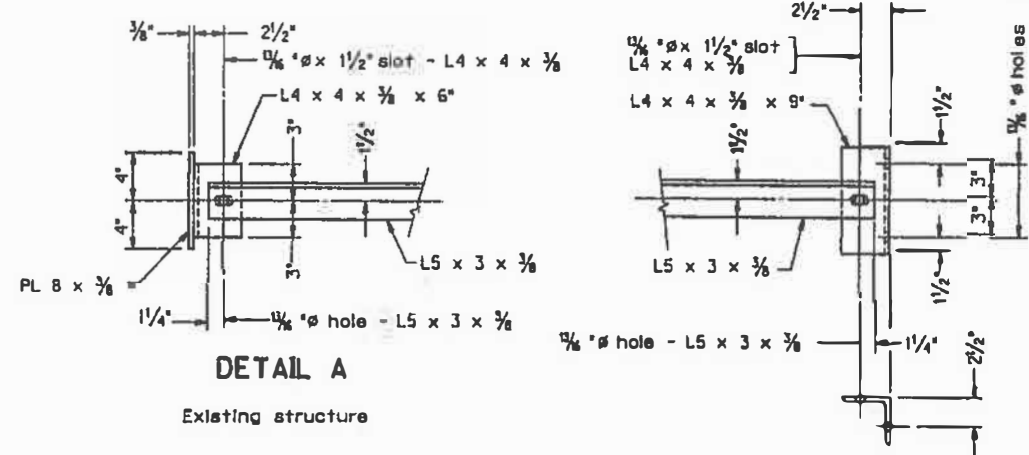


DETAIL A
Existing structure

DETAIL B
New structure

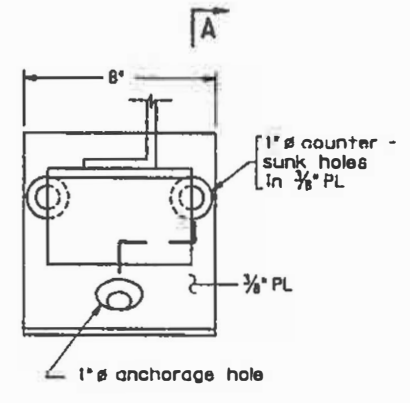


ELEVATION

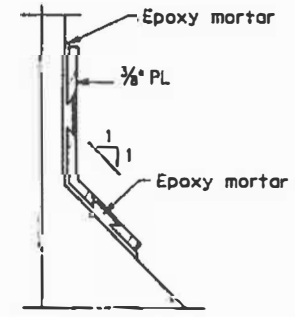

SECTION A-A

CONDUIT FORMATIONS

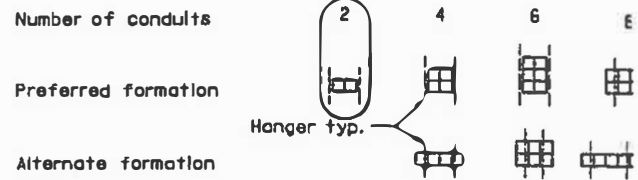


No.			Description			Date		
Revisions			Designed: G. Henderson			Date		
			Drawn: ...			Plan No.		
			Checked: ...					


TELEPHONE CONDUIT

CADD BTC-7 MOD. 7-1-93


- Notes:
1. When finishing concrete between and beyond pier surface to drain from pier to edge of cap.
 2. Piles to be driven to depths in accordance with Specifications 403.06 (e).
 3. For spacing of dowel bars, see sheet 10.
 4. The cost for dowel bars shall be included in the for substructure concrete.

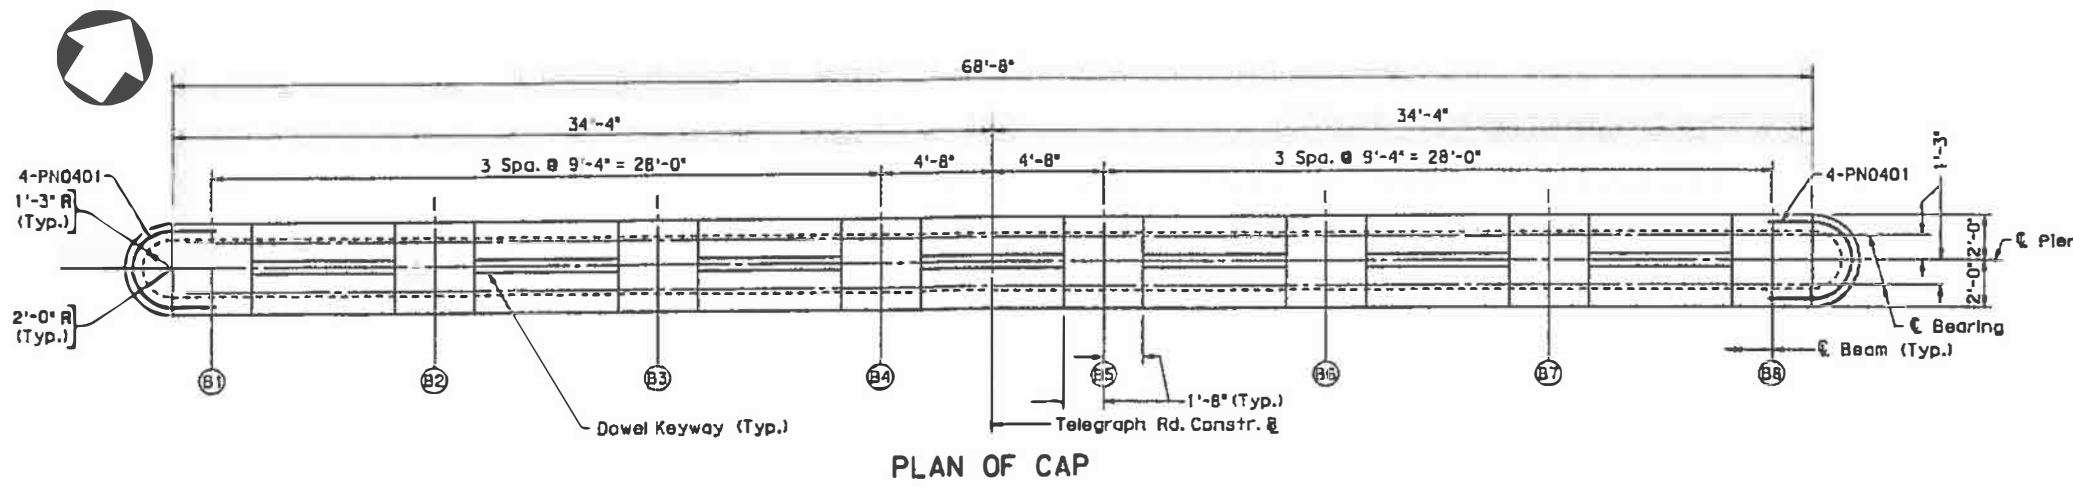


PLAN OF CAP

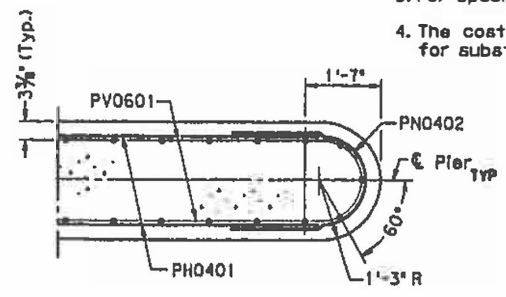


SECTION B
Scale: 1/2" = 1'-0"

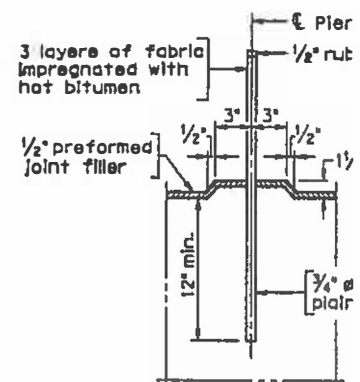


DOWEL DETAIL
Pier 1 Only - Typ. between
Scale: 1 1/2" = 1'-0"

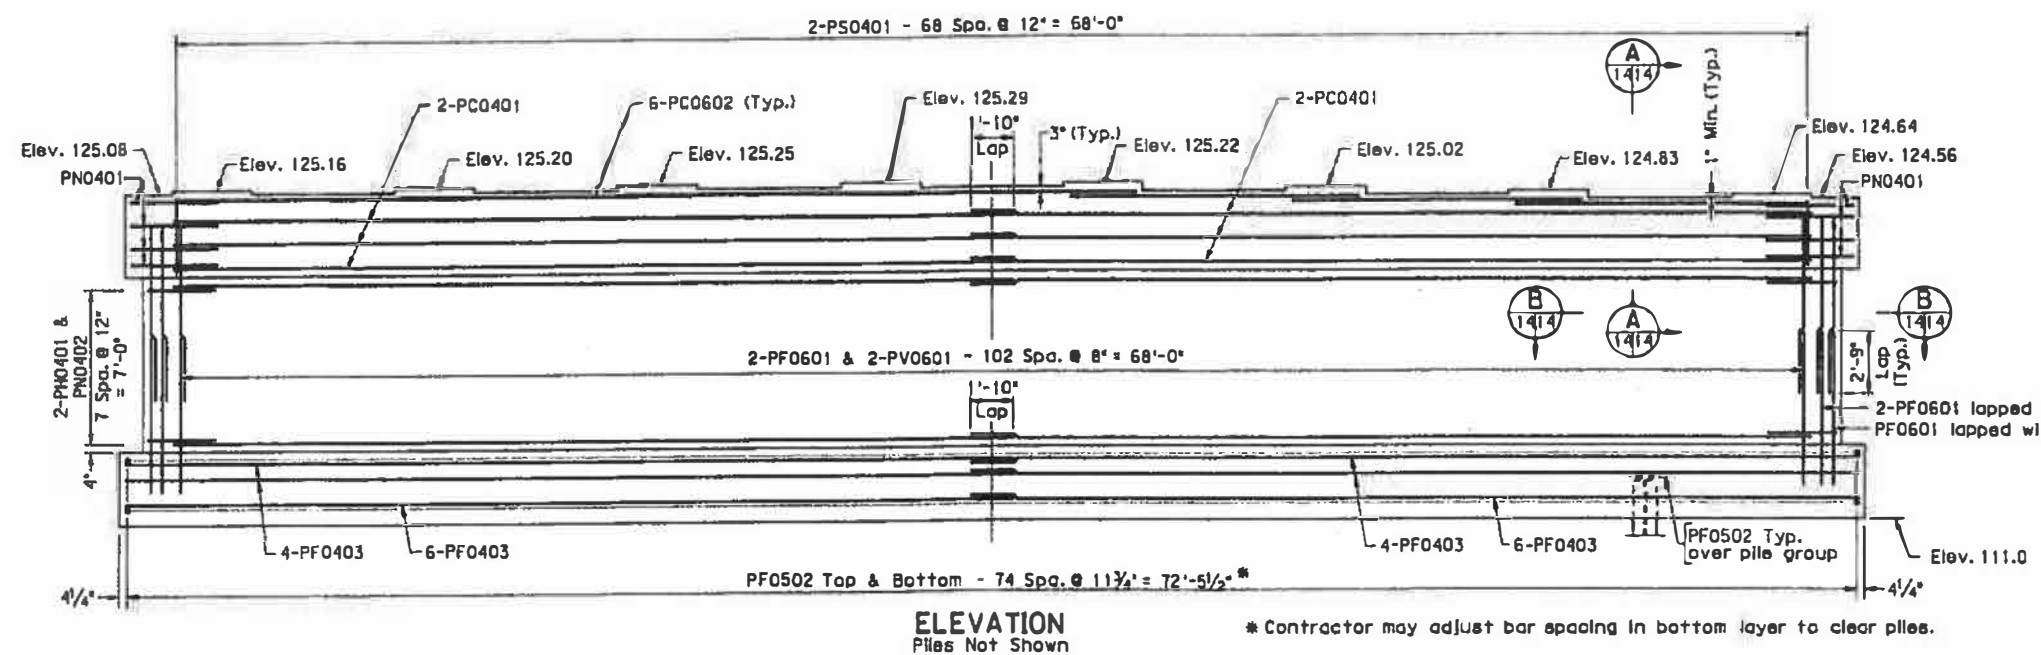


ELEVATION
Piles Not Shown

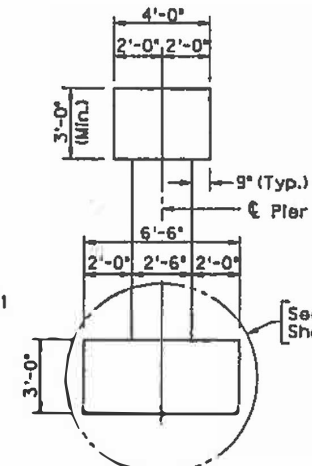

END VIEW
Piles Not Shown

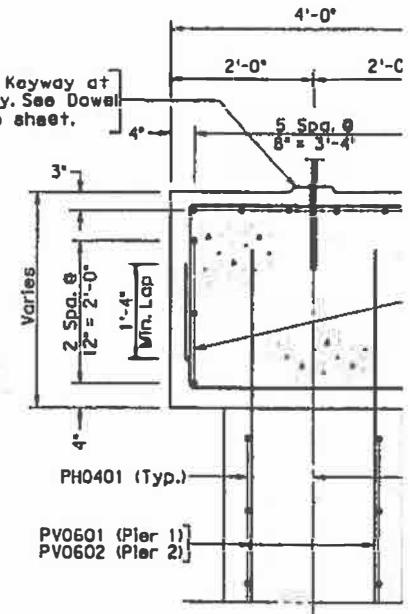

SECTION A
Scale: 3/4" = 1'-0"

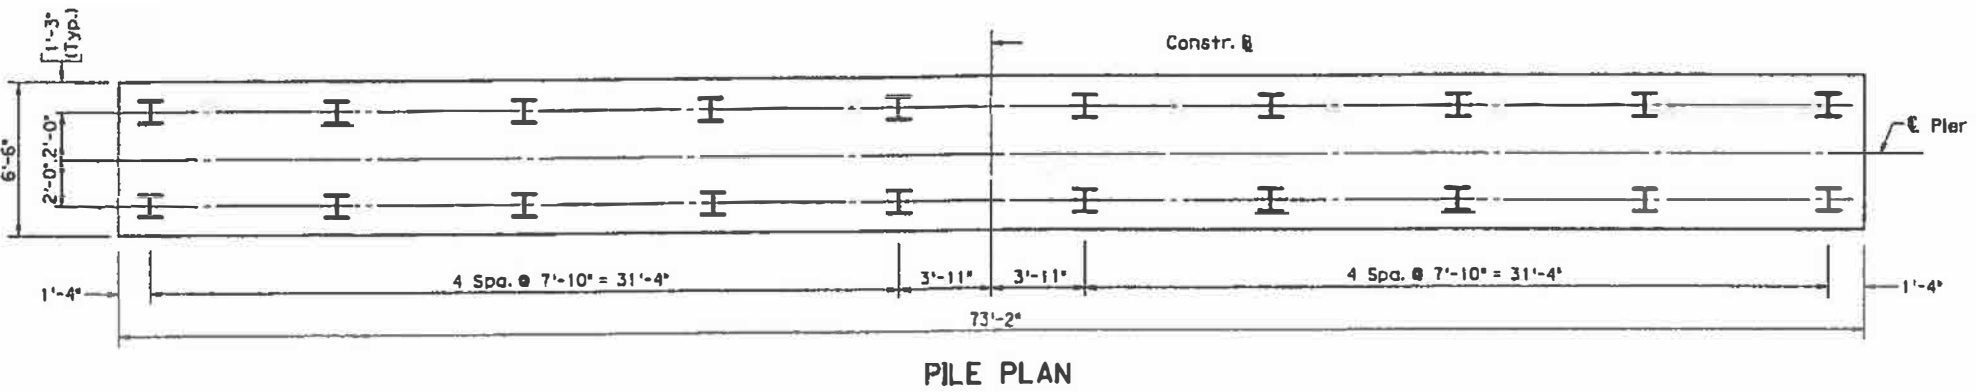


PILE PLAN


Scale: 1/4" = 1'-0" unless otherwise noted

				PIER 1	
No.	Description	Date	Designed:	Date	Plan
			Drawn:		
			Checked:		
Revisions					


- Notes:
- When finishing concrete between and beyond pc surface to drain from center pier to edge of cap.
 - Piles to be driven to depths in accordance with Specifications 403.06 (e).

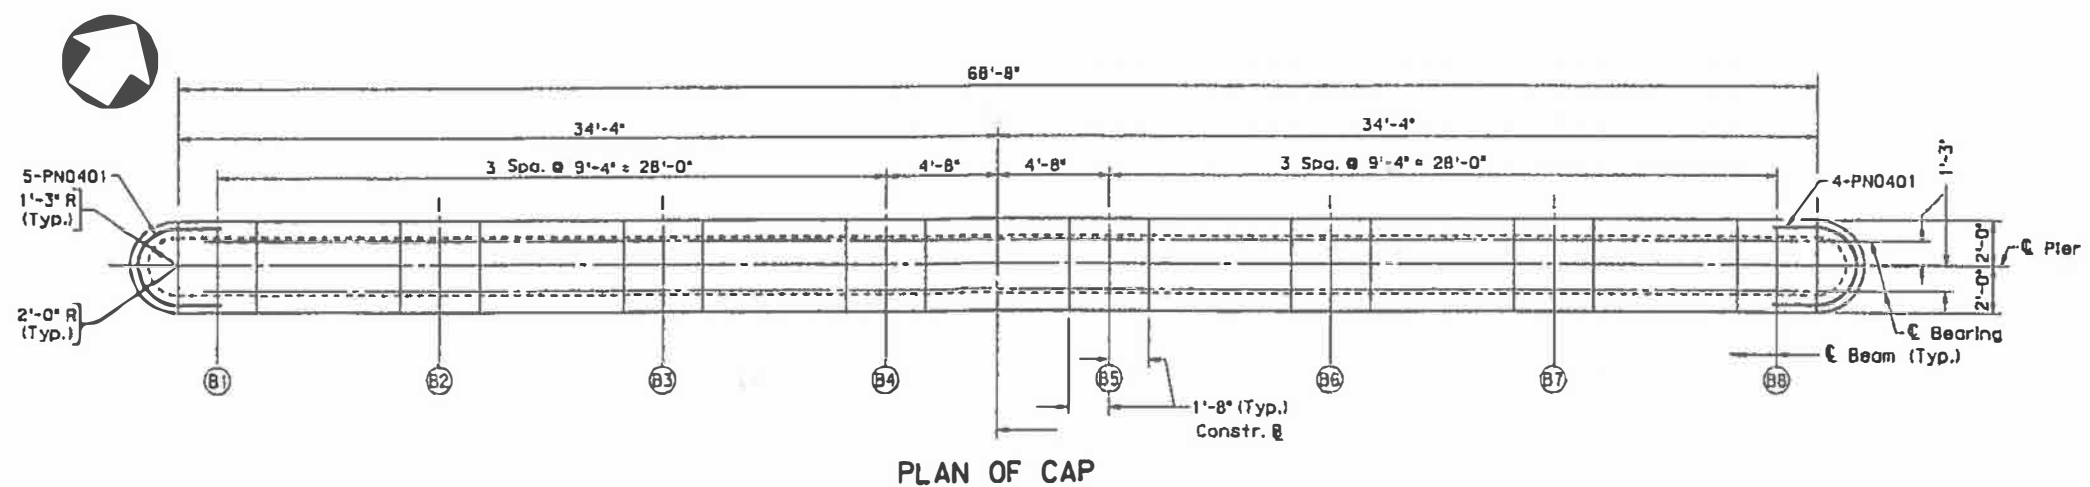


PLAN OF CAP

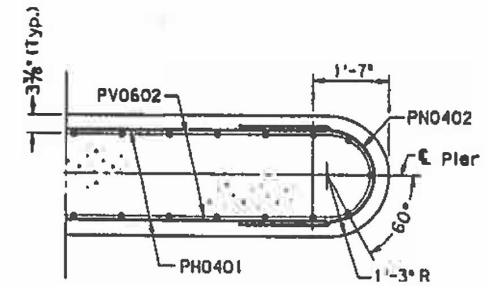

SECTION B
Scale: 1/2" = 1'-0"

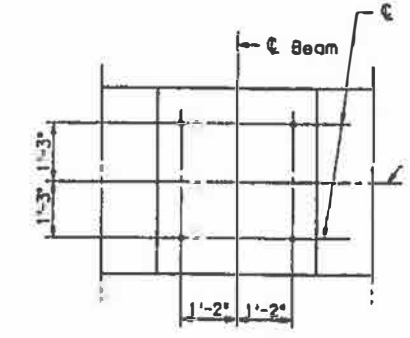


TYPICAL ANCHOR BOLT LA
Scale: 1/2" = 1'-0"

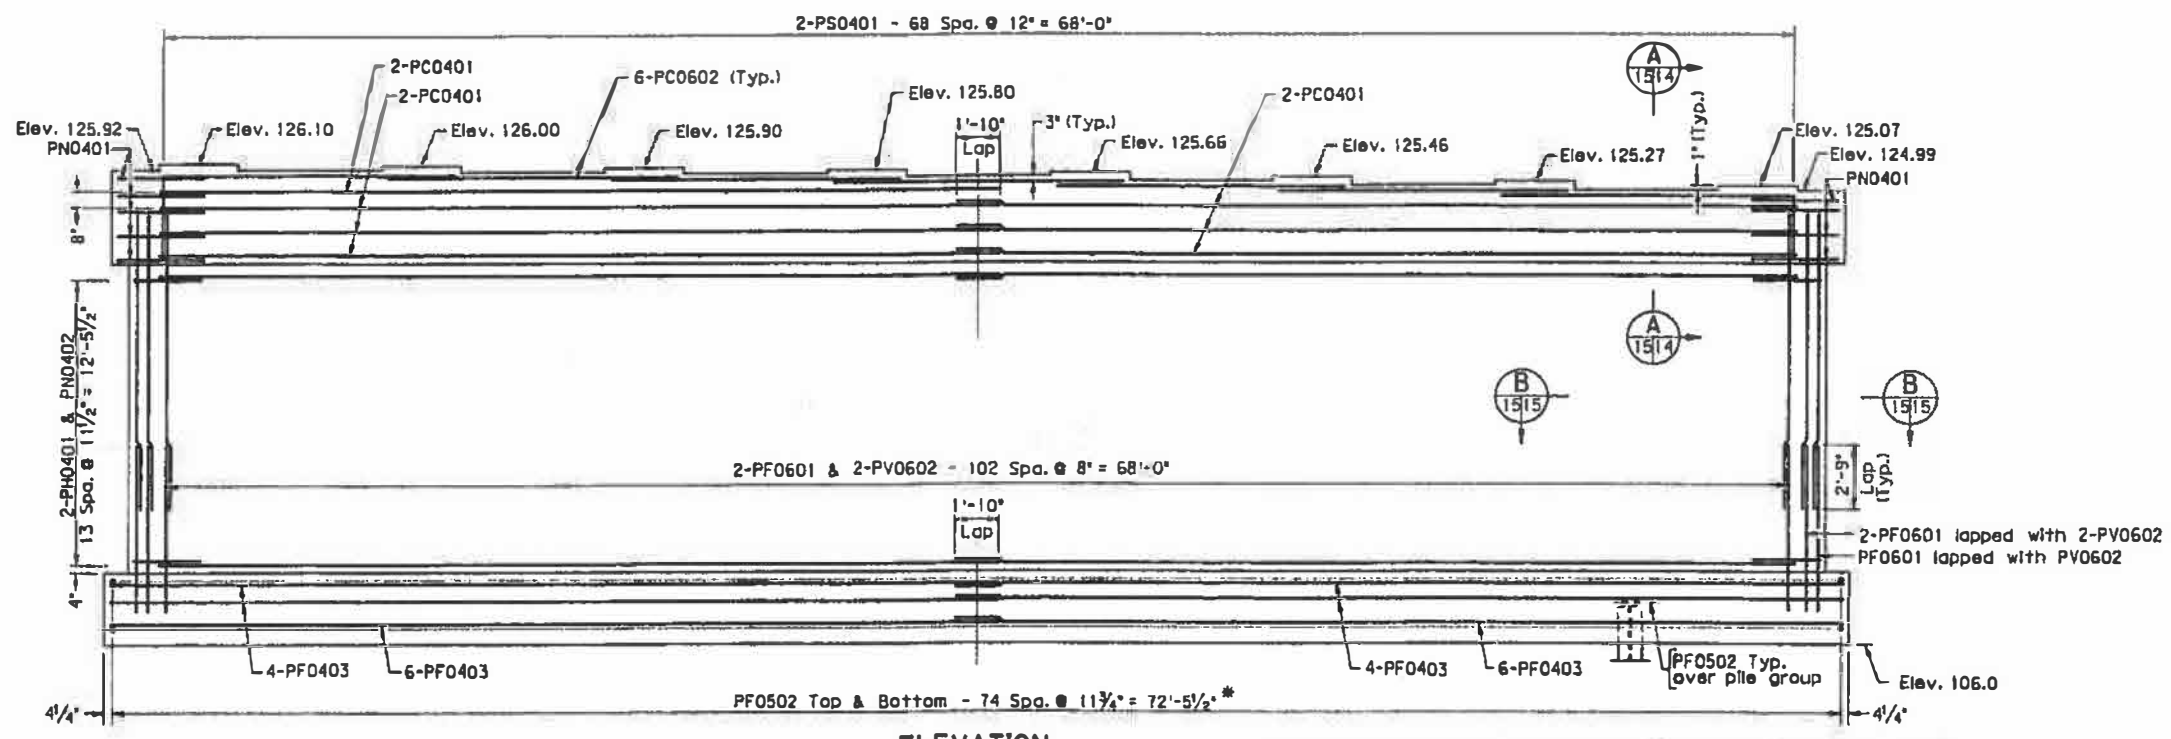


ELEVATION
Piles Not Shown


* Contractor may adjust bar spacing in bottom layer to clear piles.

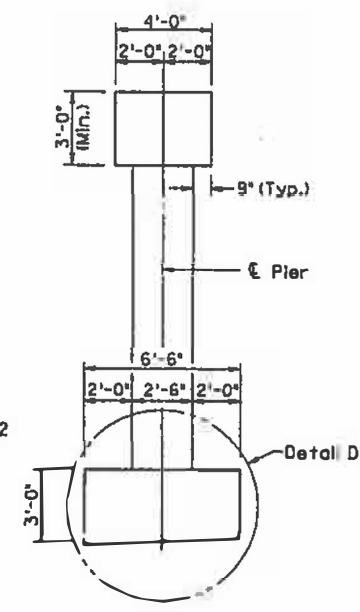

END VIEW
Piles Not Shown

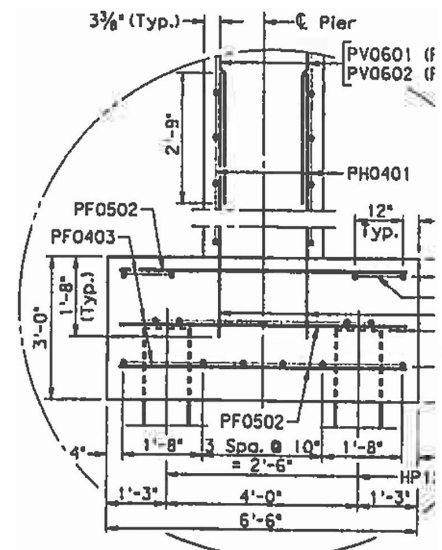

DETAIL D
Scale: 1/2" = 1'-0"


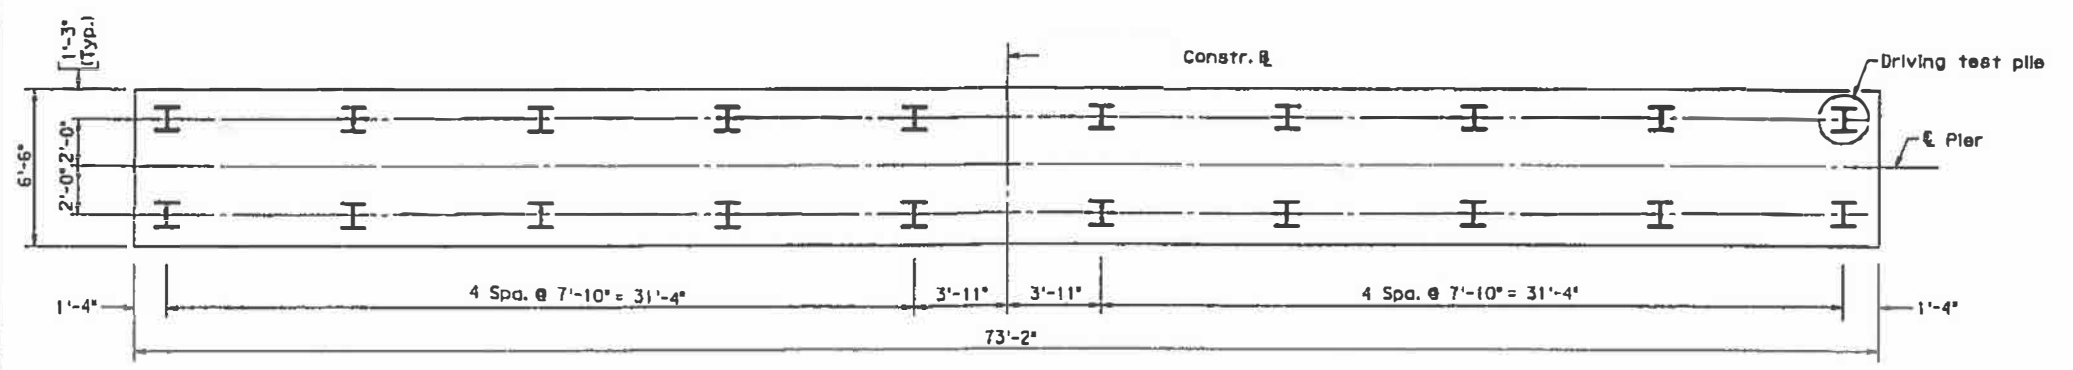


PILE PLAN

Scale: 1/4" = 1'-0" unless otherwise noted

PIER 2				
No.	Description	Date	Designed:	Date
			Drawn:	
			Checked:	
	Revisions			Plan No.

REGION	STATE	ROUTE	PROJECT	ROUTE	PROJECT
--------	-------	-------	---------	-------	---------






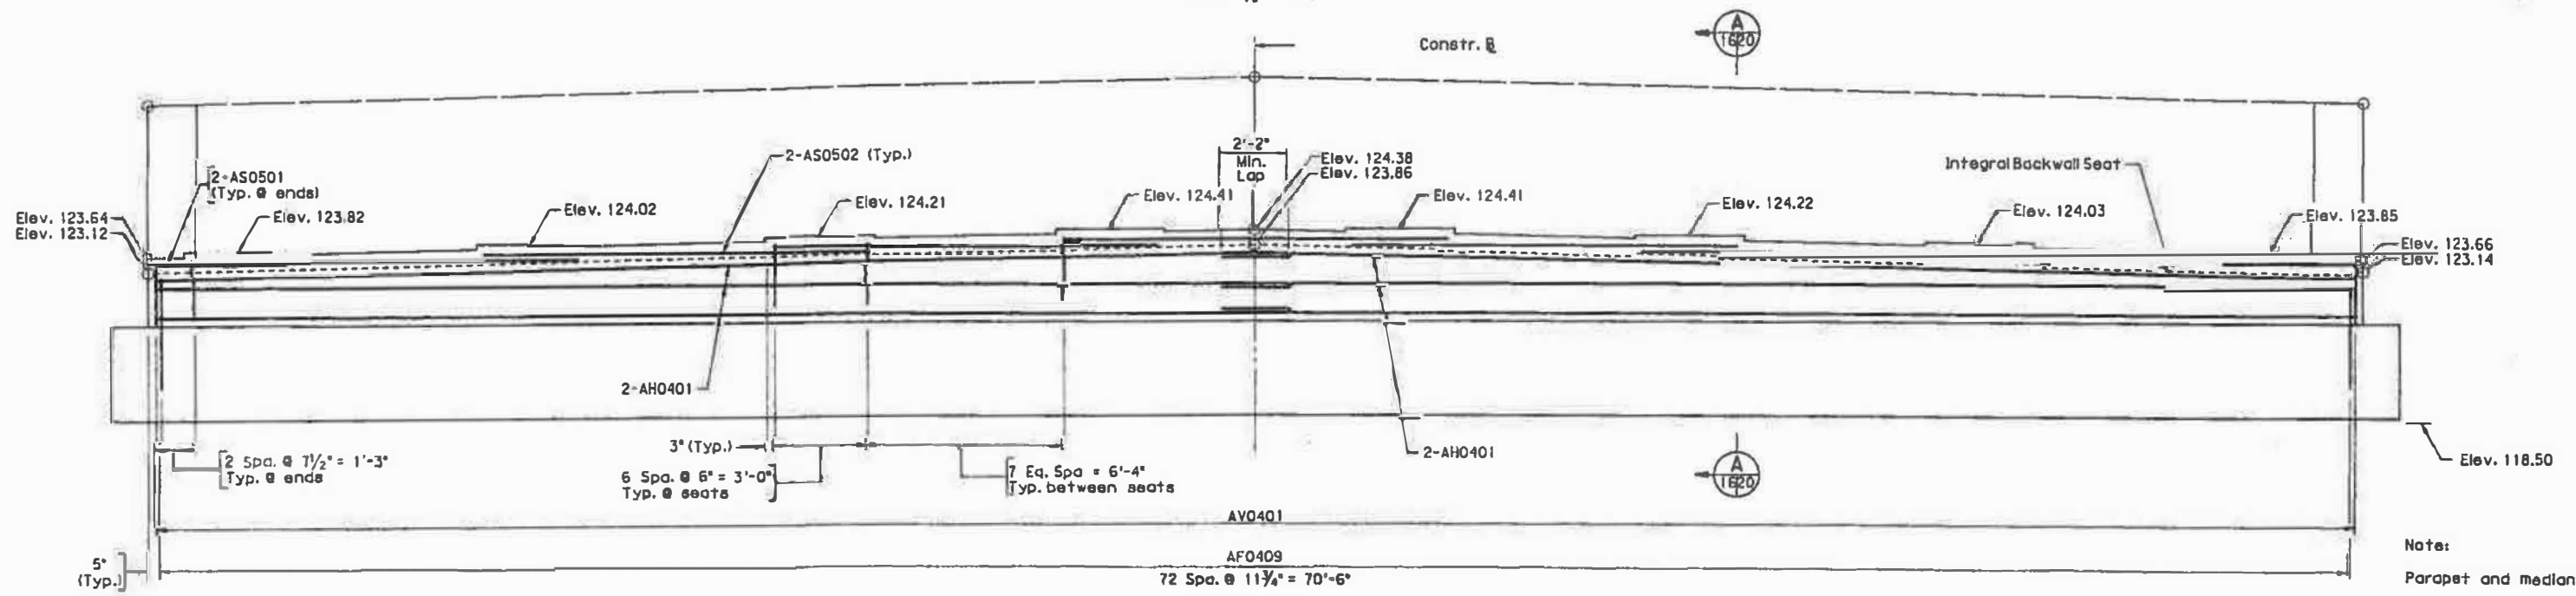
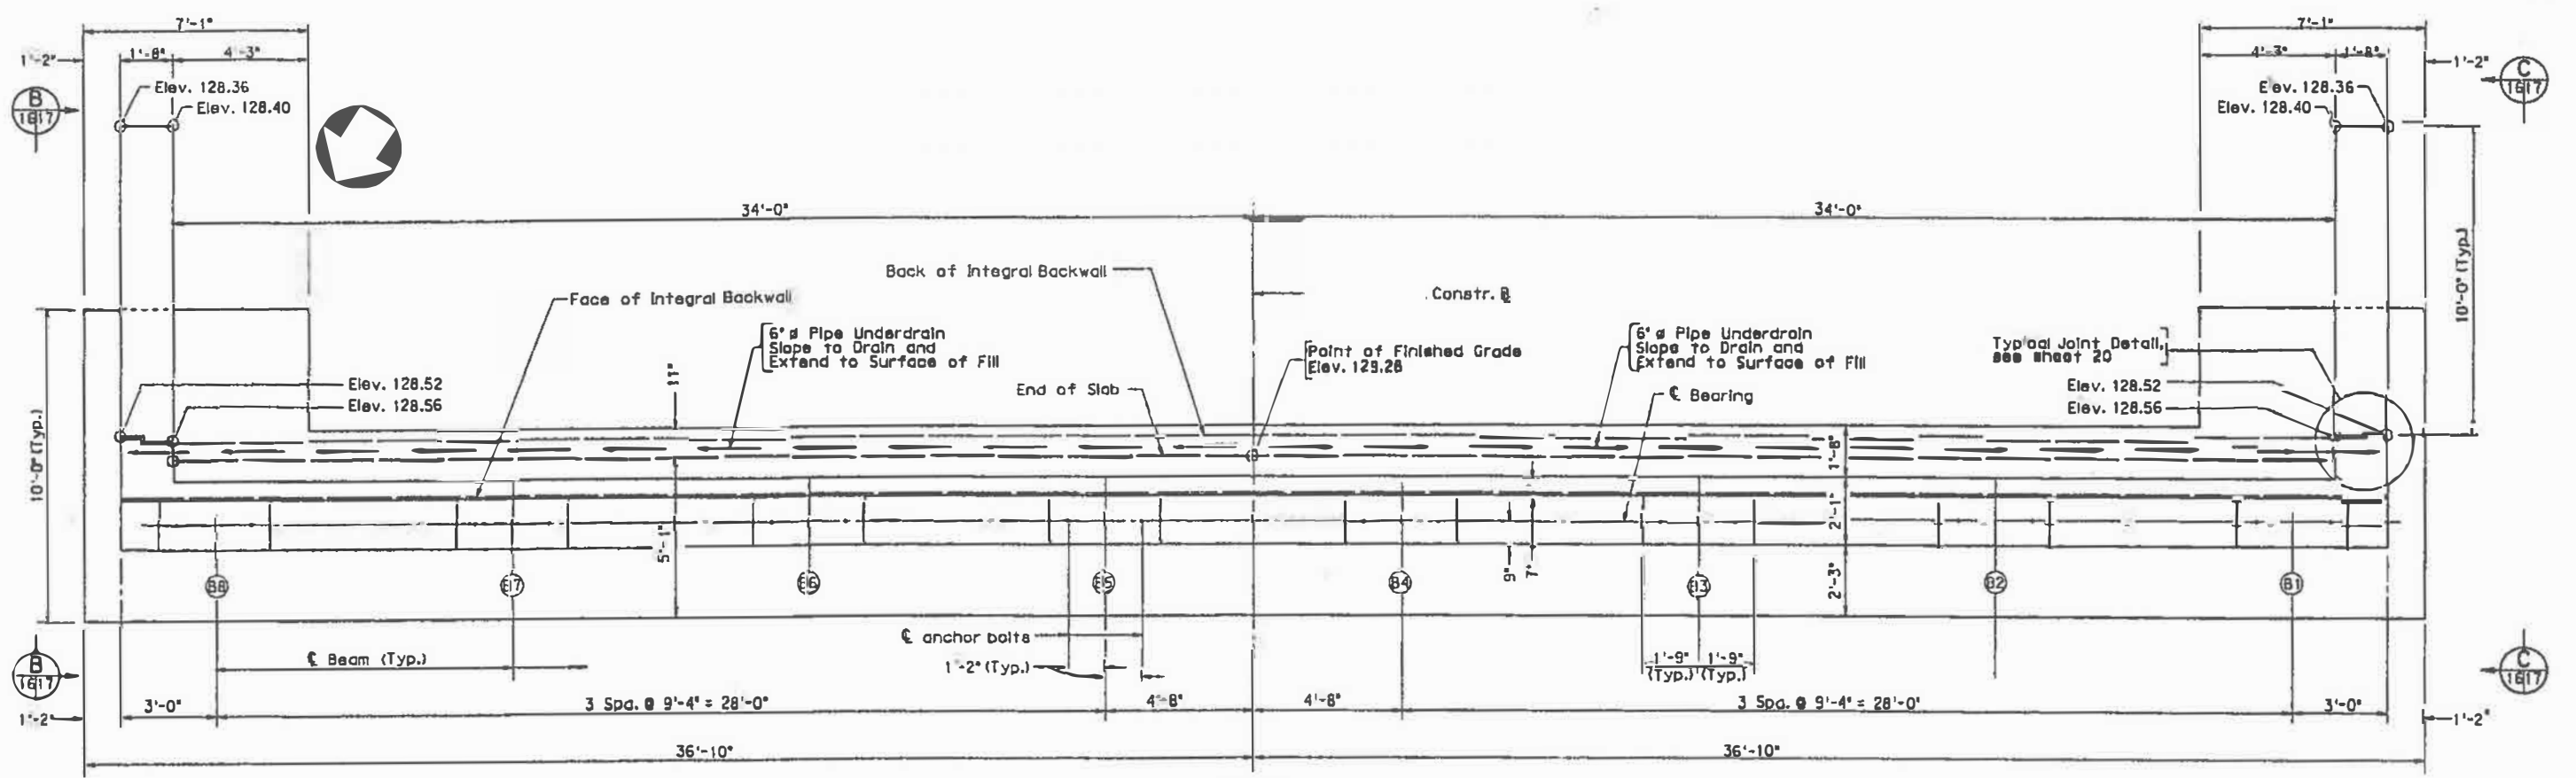


Note:
Parapet and median not shown

No.	Description	Date	Designed:	Drawn:	Checked:	Date	Plan No.

**ABUTMENT A
PLAN & ELEVATION**

FHWA REGION	STATE	ROUTE	FEDERAL AID PROJECT ROUTE	STATE PROJECT

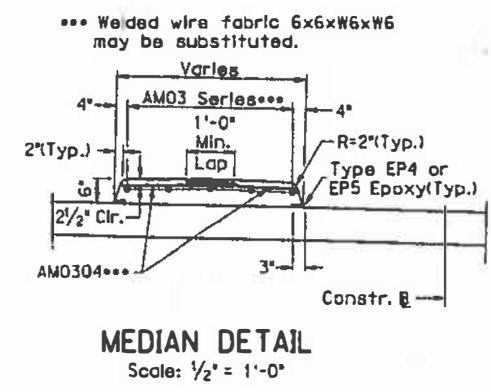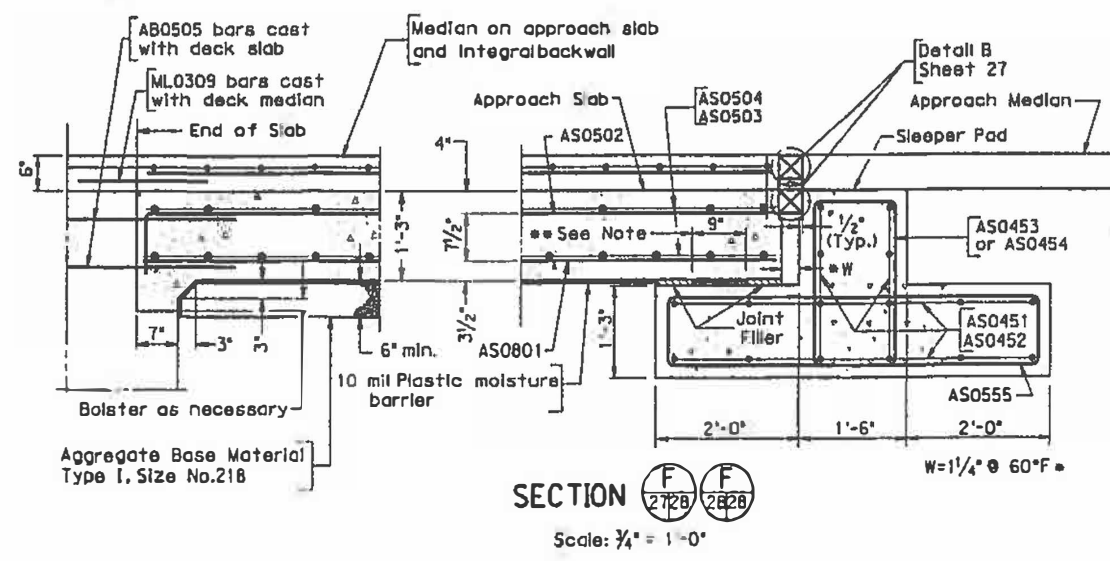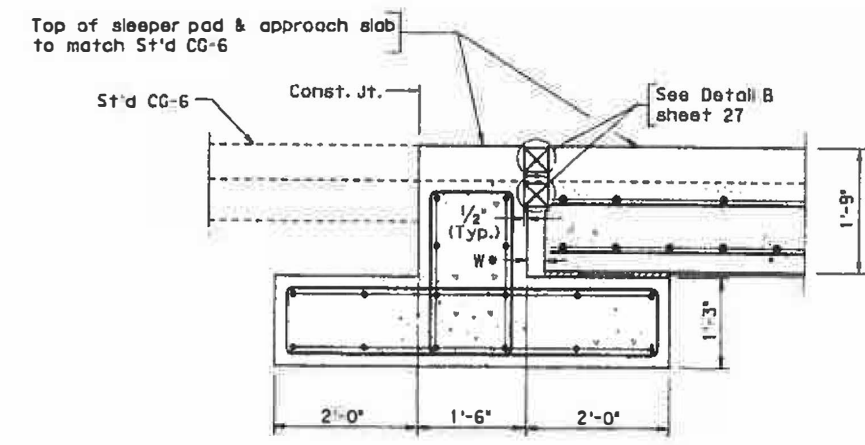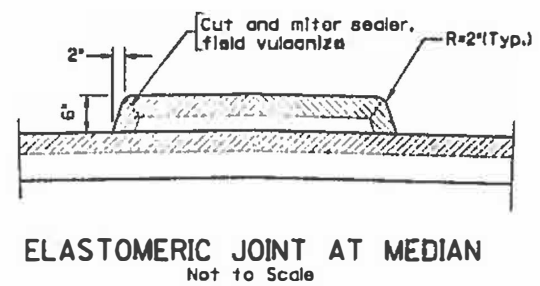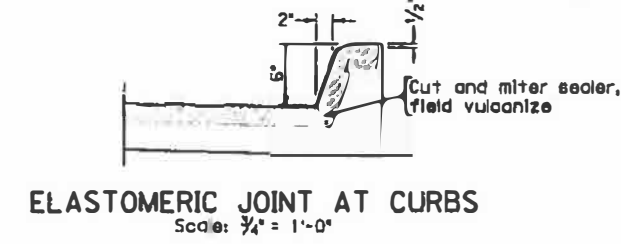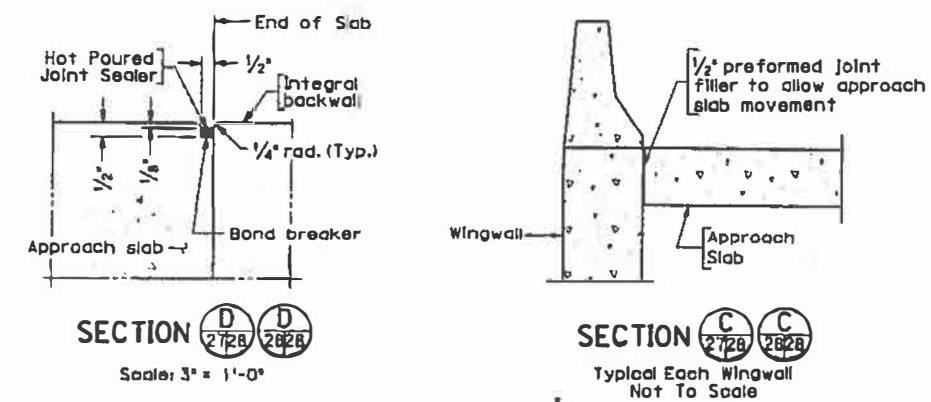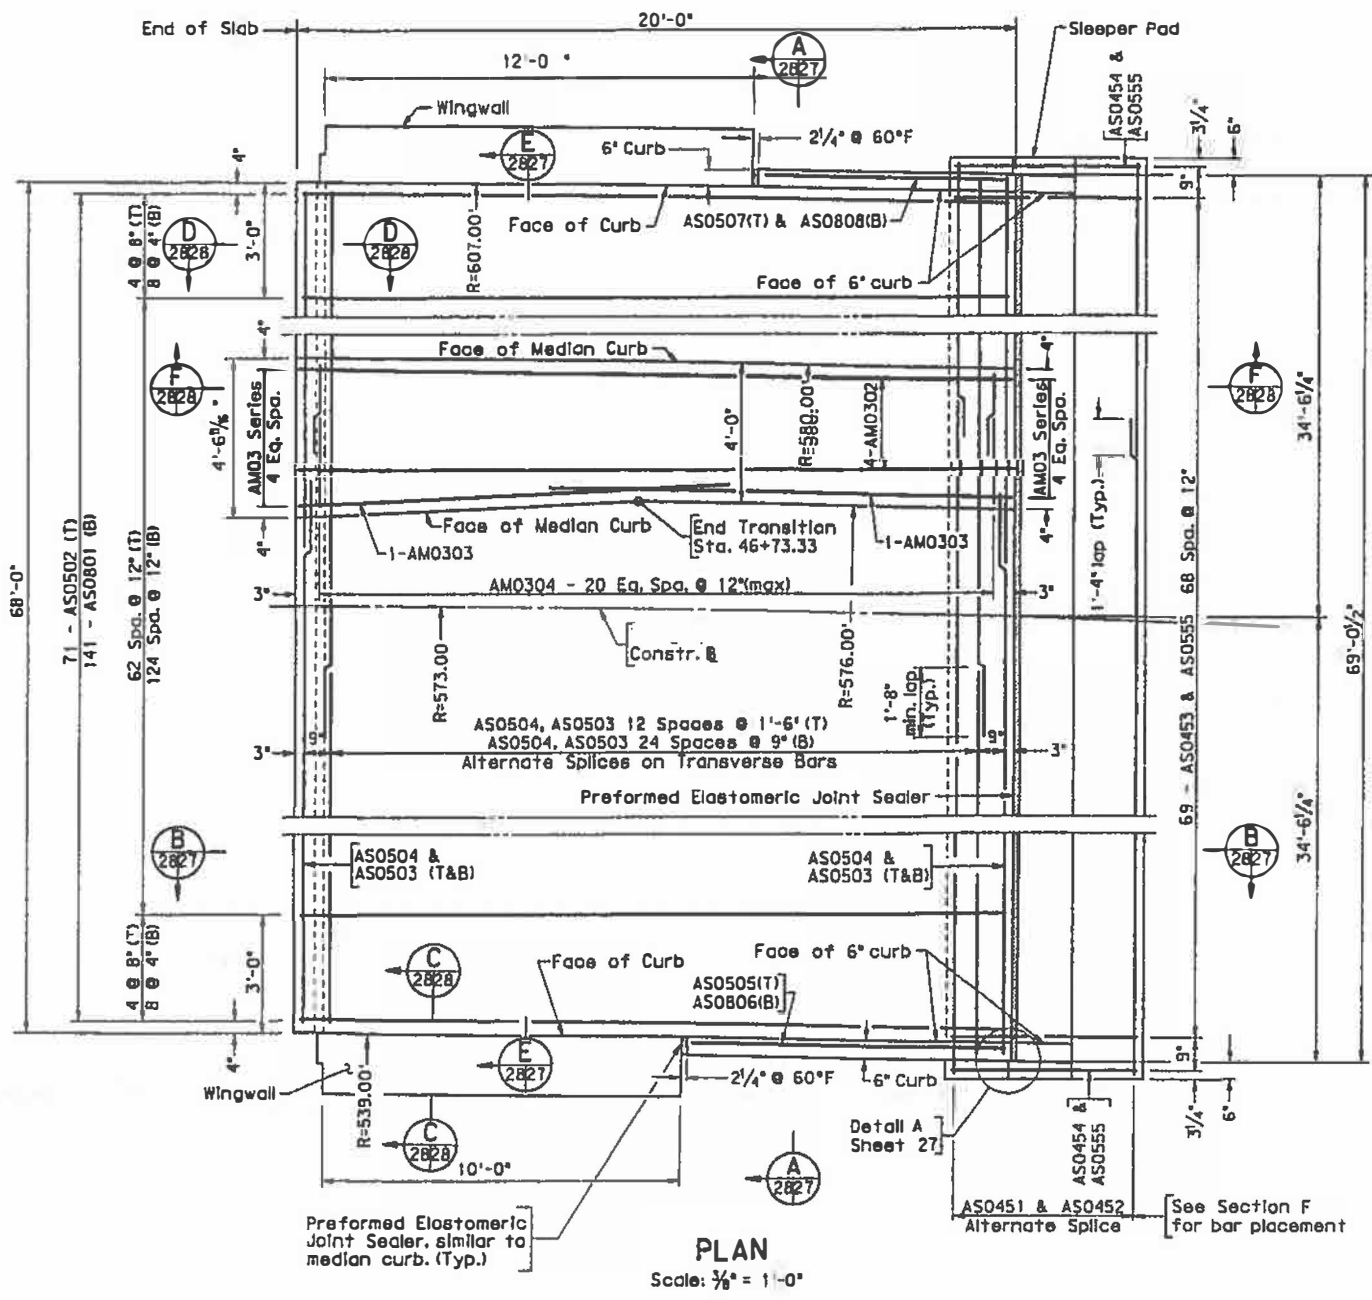

Notes:

Capacity: H520-44 loading and alternate military loading.

All joints that are to be sealed shall be free of crack spoiled areas and their faces shall be free of all foreign matter, curing compound, oils, greases and dirt. All faces must be sandblasted or brushed with a mechanical rotary wire brush prior to sealing, the joint shall be blown out with oil-free compressed air.

Preformed sealer shown is for heavy-duty structural use and may vary slightly depending on manufacturer. Seal installed in one continuous piece.

Joint width, W (1 1/2") is the final joint width of the curb when placed at 60° F. All joint widths at Abutment B shall be increased or decreased for every 10° F temperature rise or fall respectively by 1/4".

Deformed reinforcing bars shall conform to ASTM A615. All reinforcing bar dimensions except for bending diagrams are to centers of bars.

The cost for the aggregate material and moisture barrier for the approach slab will be included in the price bid for the approach slab and no additional compensation will be made.

Structural approach slabs, including sleeper pads and 3/4" Elastomeric Joint Sealer, are not included in the bridge.

Prime aggregate base material with 0.35 gal. per sq. yd. of Asphalt Material Type RC-70, RC-250 or MC-250 if aggregate base is exposed for more than 2 weeks.


• 2-1/8" X 9" preformed bedding material pads conforming to full length of sleeper pad seat. Between the pads use powdered graphite lubricant or Molykote 321 by Dow Corning. Cost to be included in other bid item.

T & B denote Top & Bottom.

1/2" preformed joint filler to be included with cost of approach slab.

For details of preformed elastomeric joint sealer, see section 27.


REINFORCING STEEL SCHEDULE				
Mark	No.	Length	Pin #	Location
AS0801	141	19'-8"	---	Bottom longitudinal
AS0502	71	20'-4 1/2"	3 3/4"	Top longitudinal
AS0503	42	40'-0"	---	Top & bot. trans.
AS0504	42	30'-2"	---	Top & bot. trans.
AS0505	1	8'-6"	---	Top longitudinal
AS0806	1	8'-6"	---	Bottom longitudinal
AS0507	1	6'-6"	---	Top longitudinal
AS0808	1	6'-6"	---	Bottom longitudinal
AS0451	16	40'-0"	---	Sleeper Pad Trans.
AS0452	16	30'-10"	---	Sleeper Pad Trans.
AS0453	69	6'-4"	2"	Sleeper Pad stirr.
AS0454	2	6'-10"	2"	Sleeper Pad stirr.
AS0555	71	11'-11"	2 1/2"	Sleeper Pad stirr.
AM0302	4	19'-8"	---	Median longitudinal
AM0303	2	11'-2"	---	Median longitudinal
AM0304	42	2'-6"	---	Median transverse

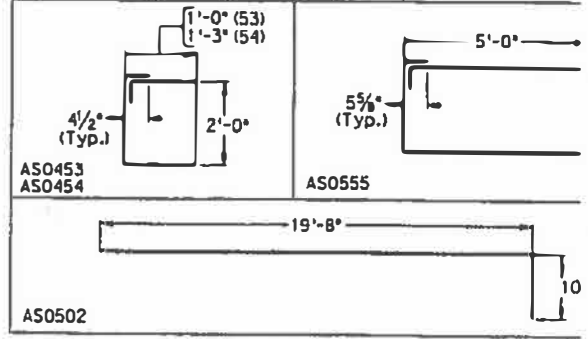


Dimensions in Bending Diagram are to out-to-out of bars.

APPROACH SLAB ABUTMENT B					
No.	Description	Date	Designed/Drawn/Checked	Date	Plan No.


CADD BAS-11 MOD 6-20-96

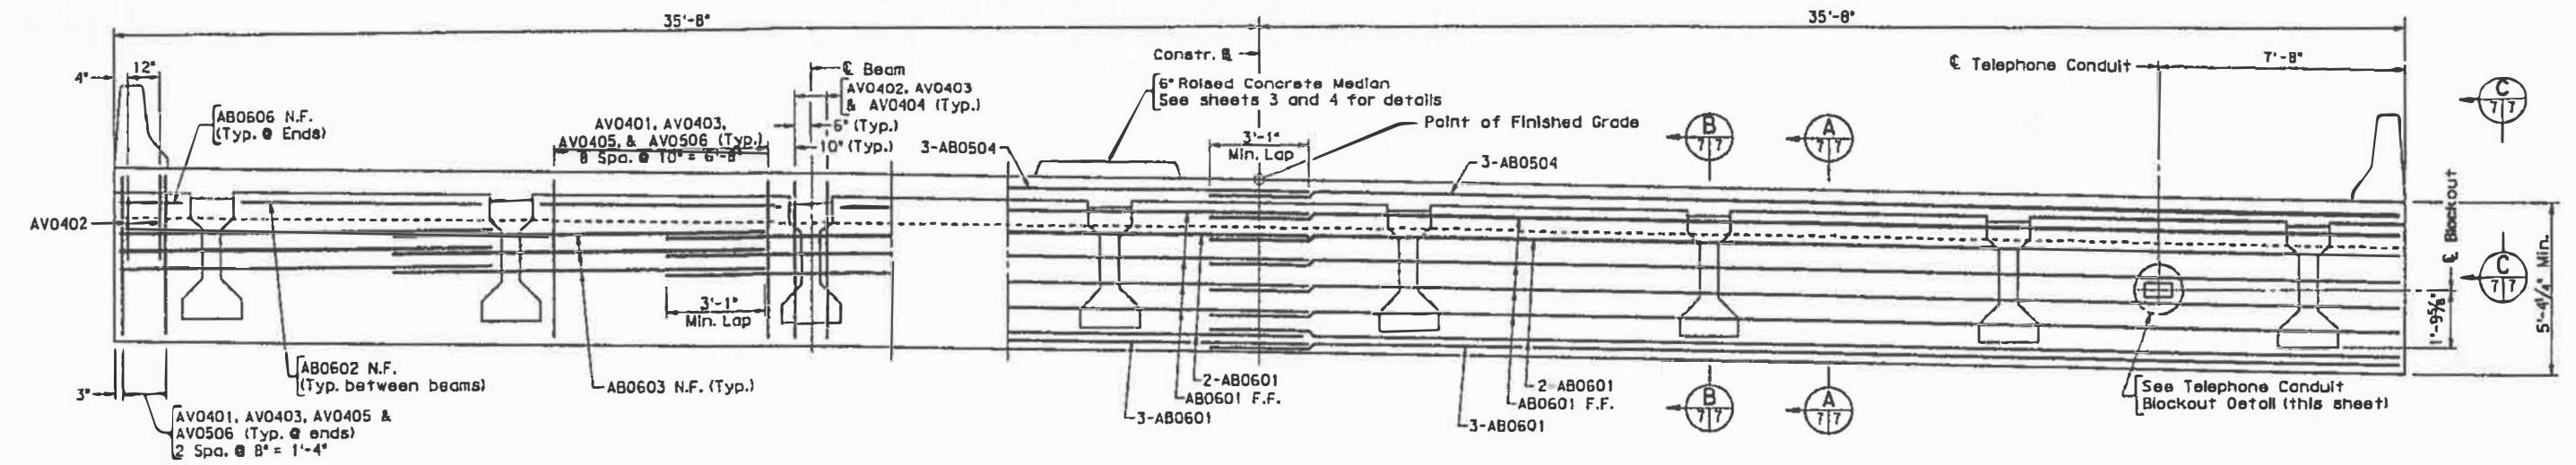


ELEVATION - INTEGRAL BACKWALL
Looking Ahead
Scale: 3/8" = 1'-0"

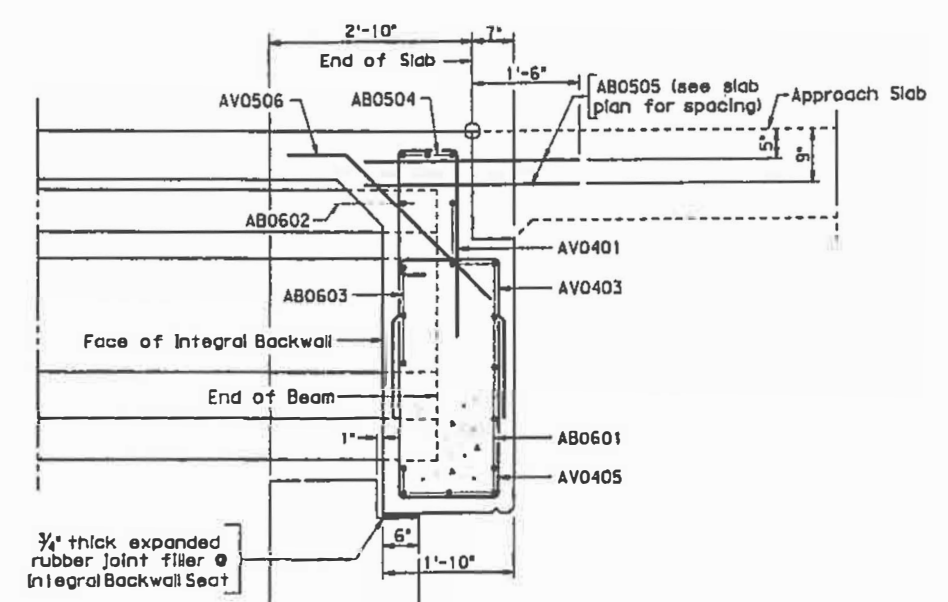


SECTION A
Scale: 3/4" = 1'-0"

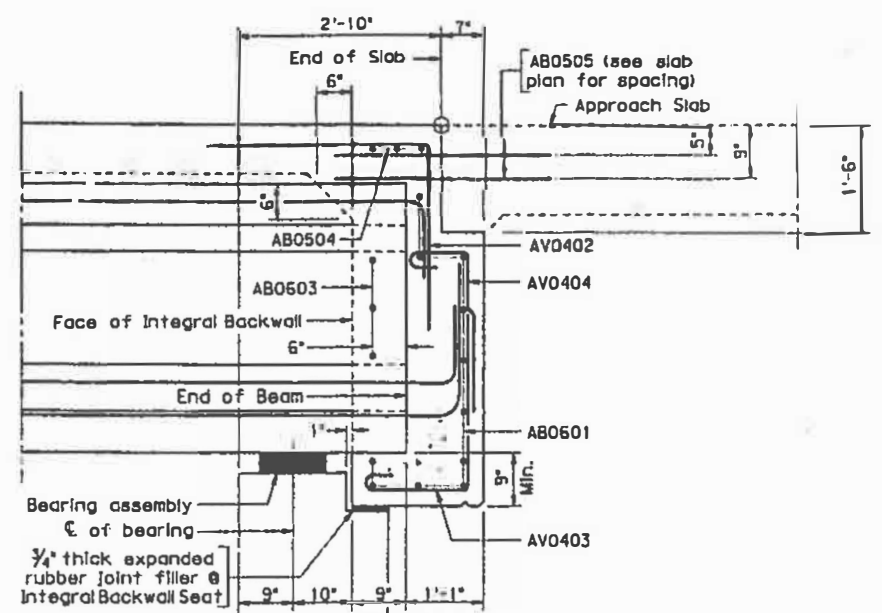

SECTION B
Scale: 3/4" = 1'-0"

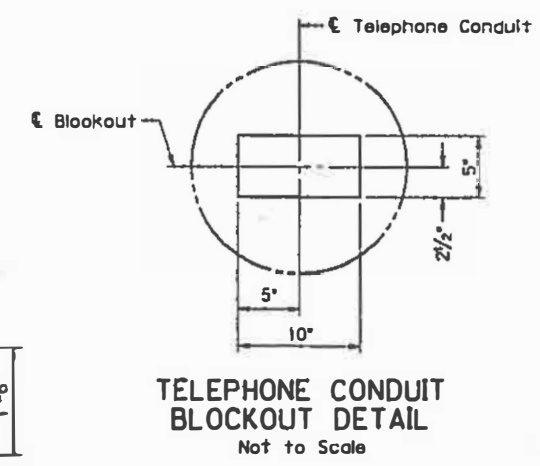

TELEPHONE CONDUIT BLOCKOUT DETAIL
Not to Scale

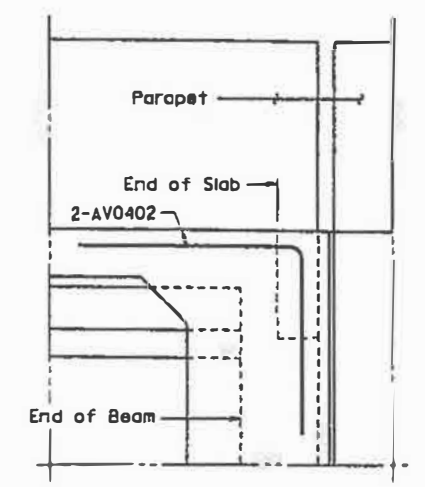


VIEW C
Scale: 3/4" = 1'-0"
For additional reinforcement, see Section A

Note:
Reinforcing steel in backwall shall be adjusted to clear tele conduit blockout.


Legend:
N.F. - Near Face
F.F. - Far Face

BACKWALL DETAIL ABUTMENT B				
No.	Description	Date	Designed:	Date
			Drawn:	
			Checked:	
				Plan No.


CADD PCB-3C MOD. 11-21-96

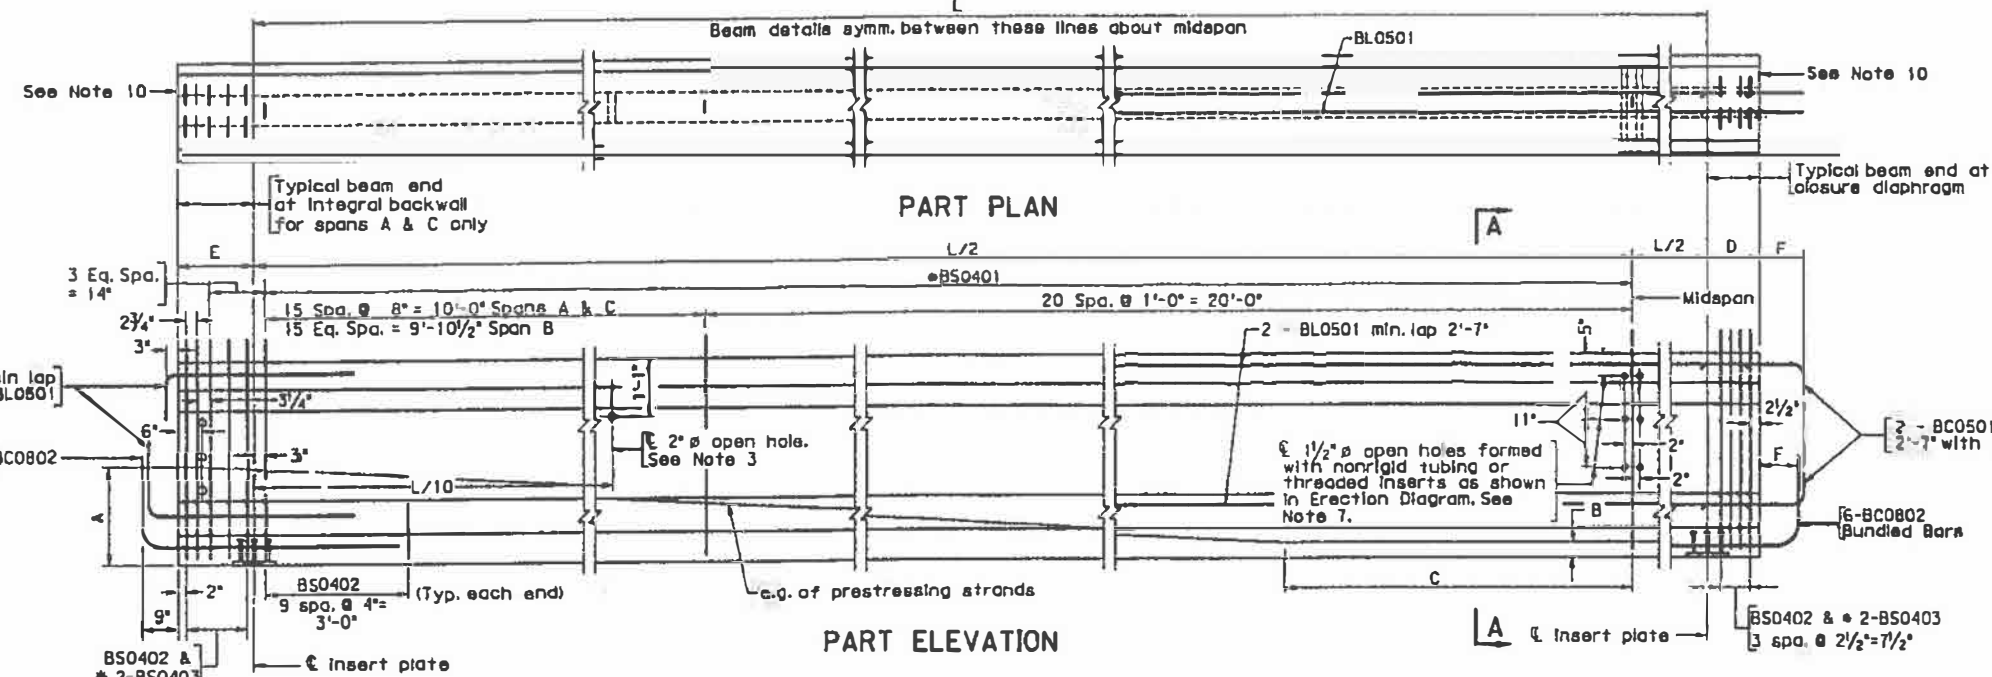

- Notes:
- 1) At end diaphragm use 1" deep recesses around local groups with 2" minimum edge clearance and fill with p applied mortar immediately after clipping strands. An epoxy mortar covering the ends of strands with a minimum thickness of 1/8" may be used as an alternate. Strands should be before mortar is applied. After mortar is allowed to cure entire end of beam shall be covered with epoxy type
 - 2) For reinforcing steel, prestressing strands and dimensions shown in the exterior beam, see interior beam.
 - 3) Beams shall have 2" open holes formed with nonrigid on stream crossings. Holes may be slightly shifted to forcing bars and strands.
 - 4) Threaded insert, when embedded shall develop full strength. 1/2" threaded bolt (ASTM A307).
 - 5) All prestressing strands shall be low-relaxation, grade 2 uncoated.
 - 6) For details of insert plate, see sheet 11.
 - 7) For location of closure and intermediate diaphragms, see Diagram on sheet 8.
 - 8) The Contractor, after a written approval from the Engineer use different prestressing strand arrangement provide the total prestressing force and its c.g. are the same on the plans.
 - 9) 2 - 1/2" strands stressed to 1000 lbs. may be substituted - 5 bars.
 - 10) At closure diaphragm and integral backwall, end strand 1" from beam after clipping. End of beam shall be reinforced in accordance with Section 405.05 of the Road and Bridge Specifications.
 - 11) Top of beam to be roughened to a full amplitude of
 - 12) All reinforcing bar dimensions except for bending diagram centers of bars.
 - 13) 3/4" inserts for telephone conduit supports not shown sheet 13 for details.

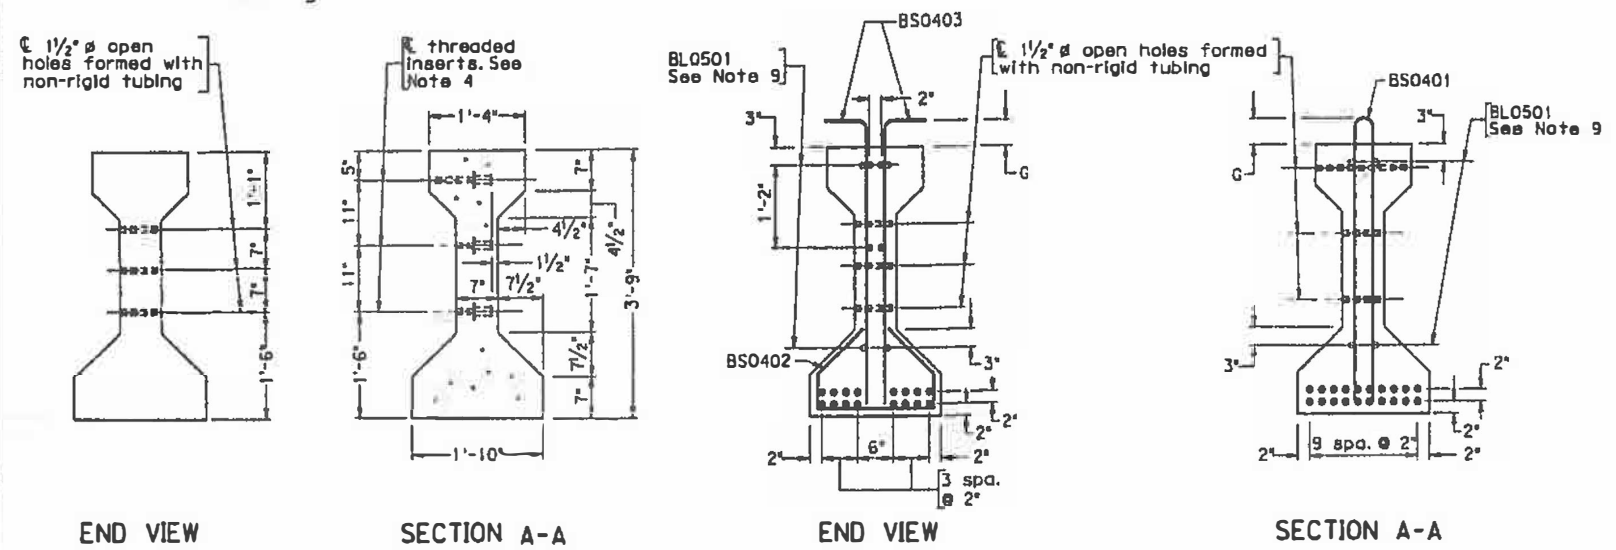

Mark	No.	Size	Ler
BS0401	1704	#4	8'
BS0402	688	#4	4'
BS0403	416	#4	4'
BL0501	192	#5	32
BC0501	192	#5	4'
BC0802	288	#8	8'

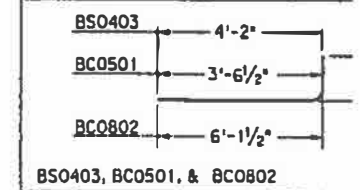

BS0403, BC0501, & BC0802

BS0401: 3 1/2"

BS0402: 8"

Dimensions in Bending Diagrams of bars.



Reinforcing bars shown on the are for beams shown on this sheet BS0401 or BS0403 may be slightly directed by the Engineer to close inserts.

Reinforcing bars BS0401 and BS0402 galvanized. All other reinforcing epoxy coated except all BC series non-epoxy coated.

Beams	ANTICIPATED DEAD LOAD DEFLECTION**				
	At a		At b		
	Δc1	Δc2	Δc1	Δc2	
Spans A & C	Beams 2 thru 7	3/16"	1/16"	3/16"	1/16"
	Beams 1 & 8	3/16"	1/16"	3/16"	1/16"
Span B	Beams 2 thru 7	3/16"	0	3/16"	0
	Beams 1 & 8	3/16"	0	3/16"	0

DEAD LOAD DEFLECTION DIAGRAM
** Deflection shown are actual deflections without multipliers.

DIMENSION TABLE											
Beam	Prestr. force per strand lb.	No. and size of strands/beam	Net camber N in.	A ft.-in.	B in.	C ft.-in.	D in.	E in.	F in.	G in.	L ft.-in.
Spans A & C	30,980	20 - 1/2" φ	7/8"	9 3/8"	3"	6'-3"	9 1/2"	19"	8 3/8"	6 1/4"	60'-6"
Span B	30,980	20 - 1/2" φ	7/8"	9 3/8"	3"	6'-2"	9 1/2"	—	8 3/8"	6 1/4"	60'-3"











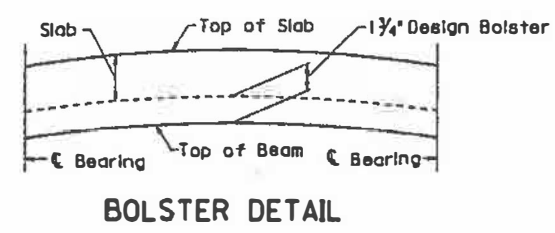
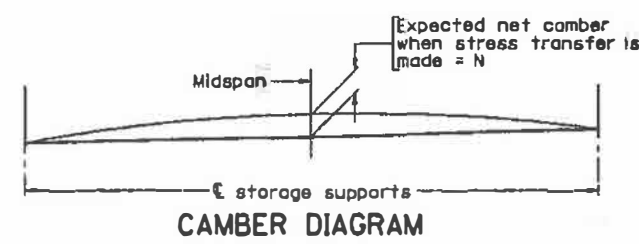


PRESTRESSED CONCRETE TYPE III

No.	Description	Date	Designed: ***	Date	Plan No.
	Revisions		Drawn: ---		
			Checked: ---		

Not to Scale

FHWA REGION	STATE	FEDERAL AID ROUTE	PROJECT	STATE	PROJECT

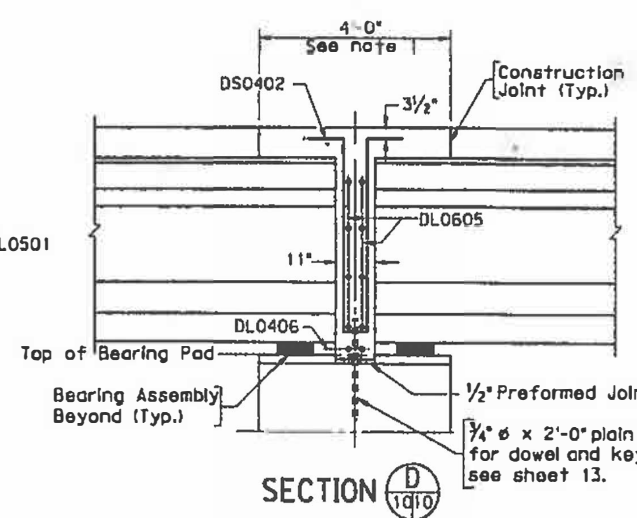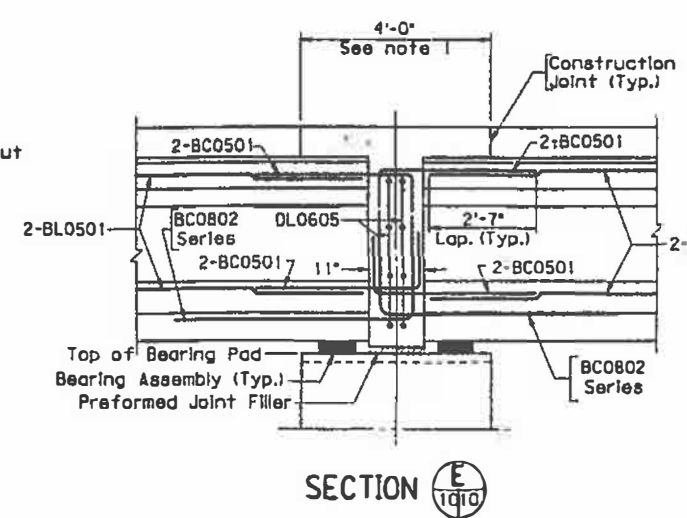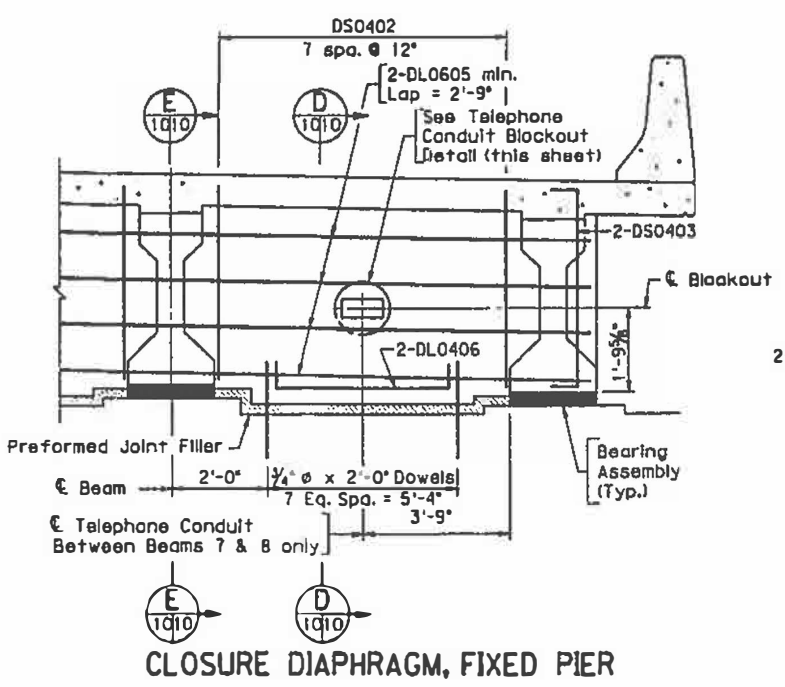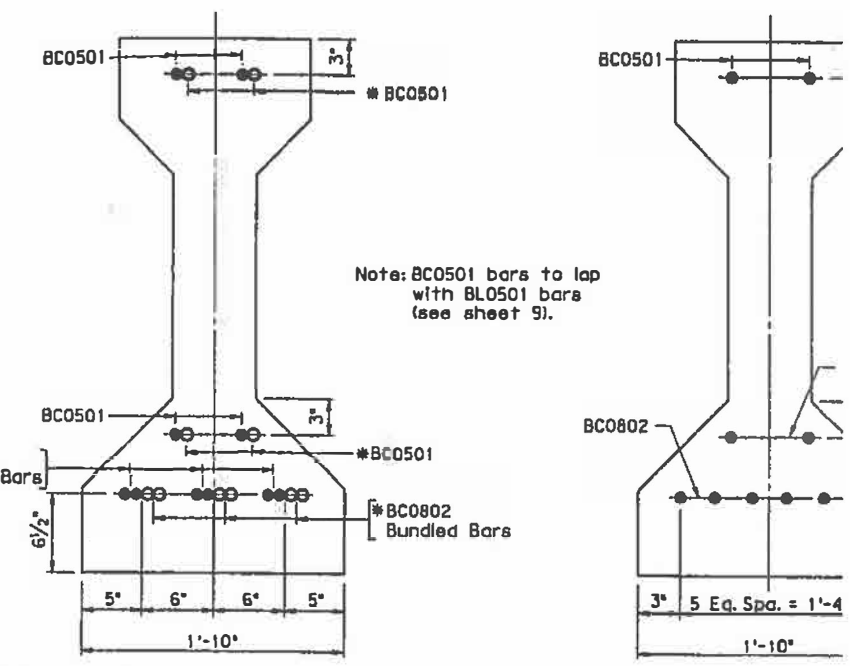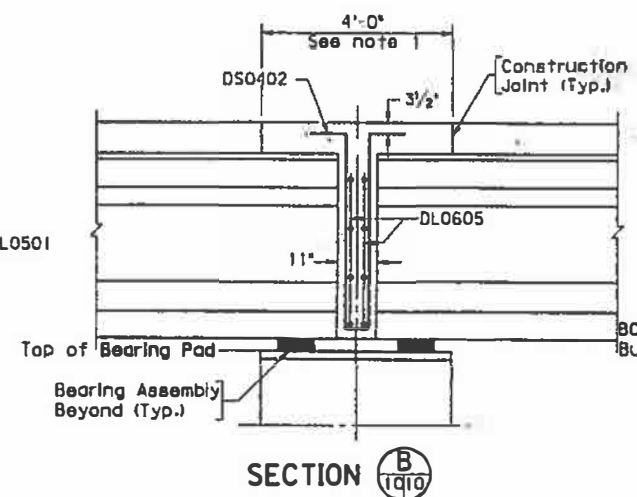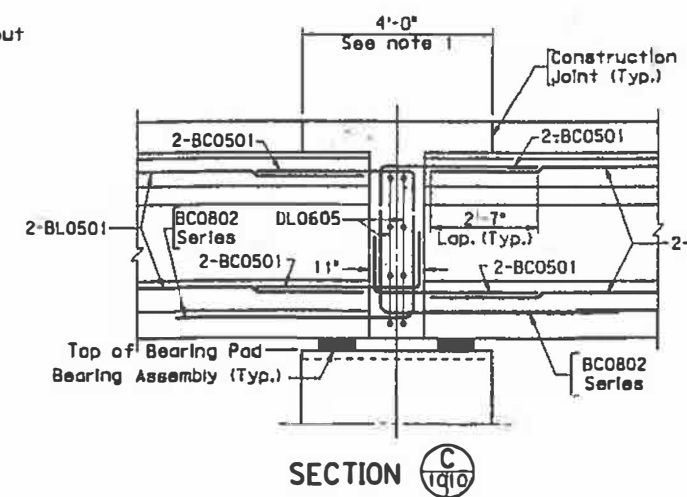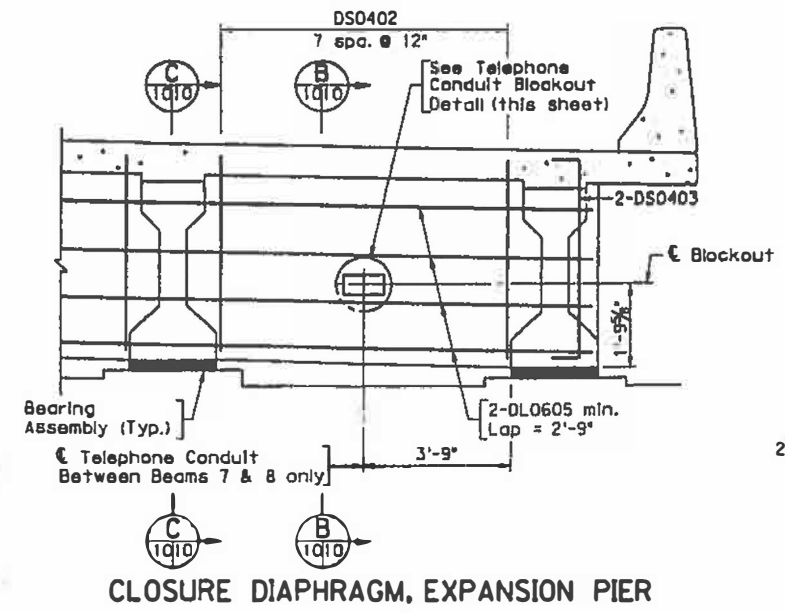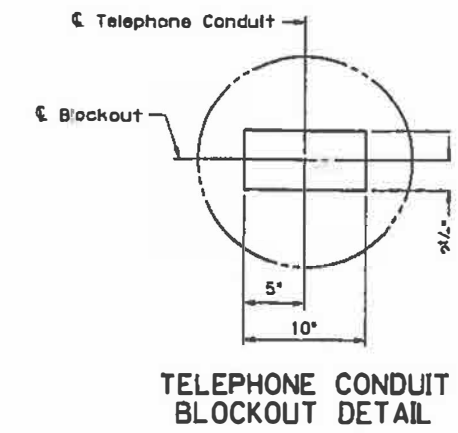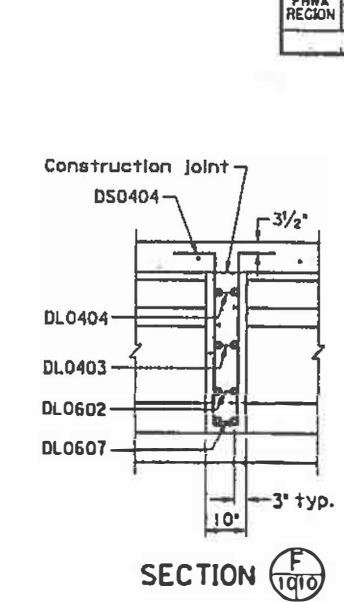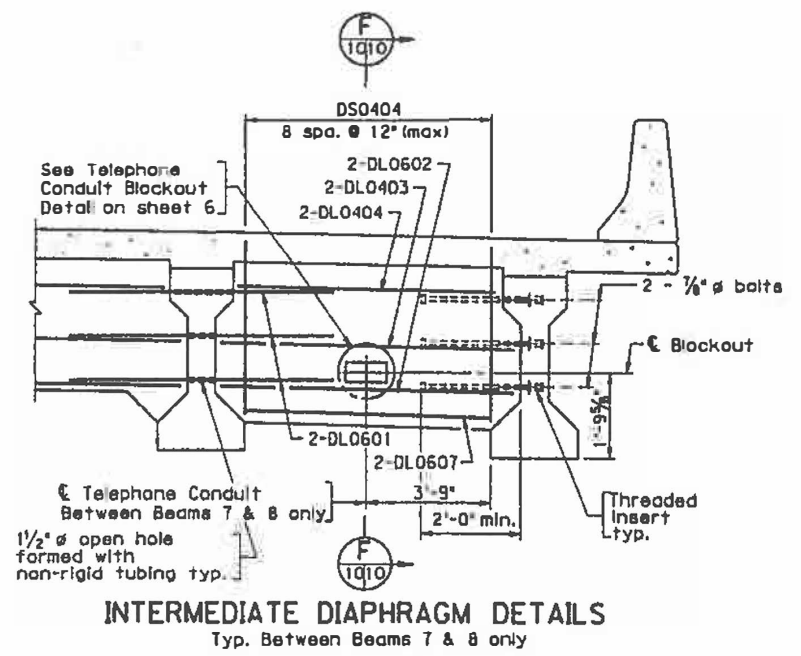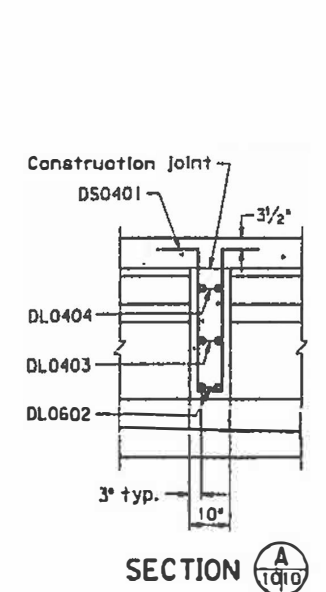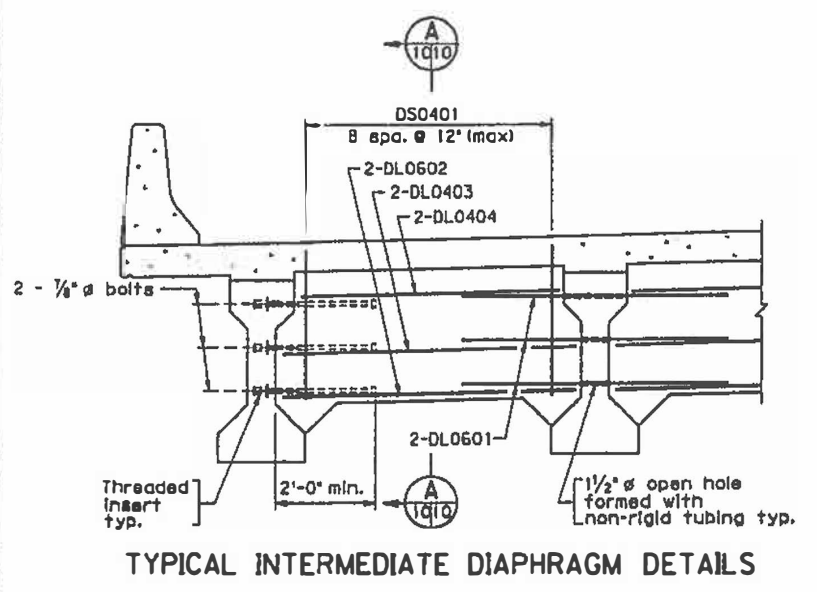

* O Indicates BC bars from beam in adjacent span


BEAM END AT CLOSURE DIAPHRAGMS

- Notes:
1. This portion of the slab shall be cast with the closure d
 2. For details of bearing pads and bearing pad assemblies see
 3. Reinforcing steel in diaphragms shall be adjusted to clear conduit blockout.

No.	Description	Date	Designed:	Date	Plan No.

Not to Scale (unless otherwise noted)

INTERMEDIATE AND CLOSURE DIAPHRAGM DETAILS

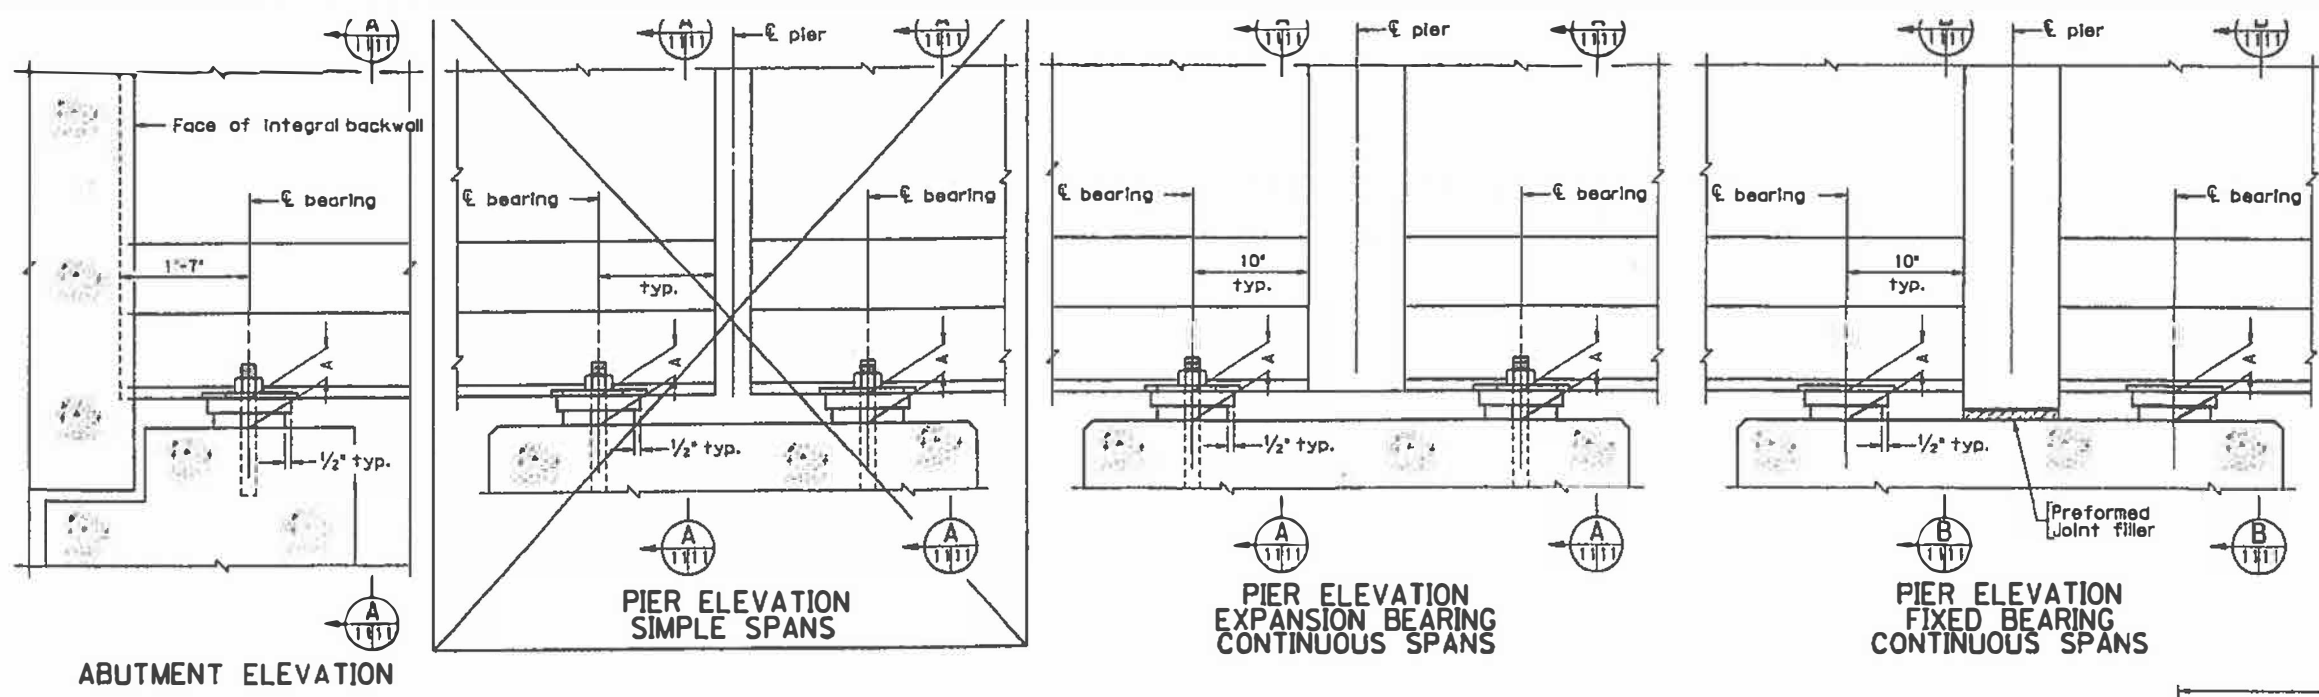

Notes:

Material: Elastomer - 50 durometer hardness.
Shim - ASTM A36 or A570 mild steel.





Elastomeric bearings shall be molded as a single unit.
Bevel sole plates to grade. Minimum 3/4" thickness.

Insert plate shall provide uniform bearing over its entire area. Insert plate is 1" wider than sole plate.


In welding insert plate to sole plate, ample time shall be between weld passes to prevent heat damage to the sole plate and elastomeric pad. Elastomer shall not be at temperatures higher than 400° F.

For closure diaphragm details, see sheet 10.

For designation of fixed or expansion bearings, see elev on front sheet.

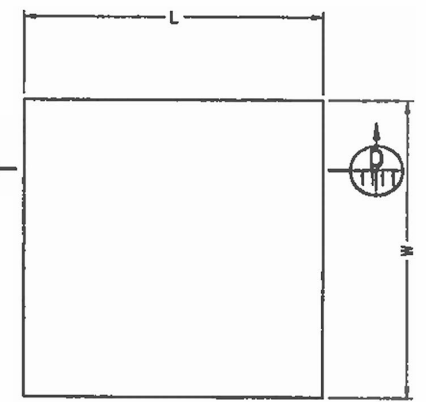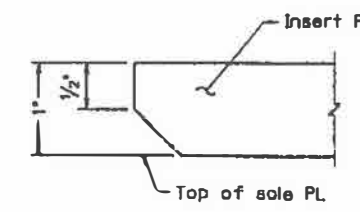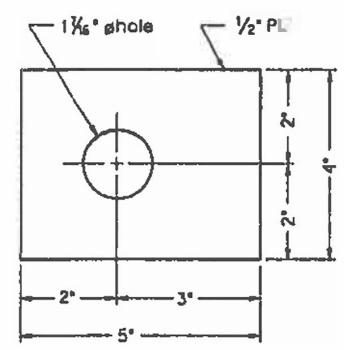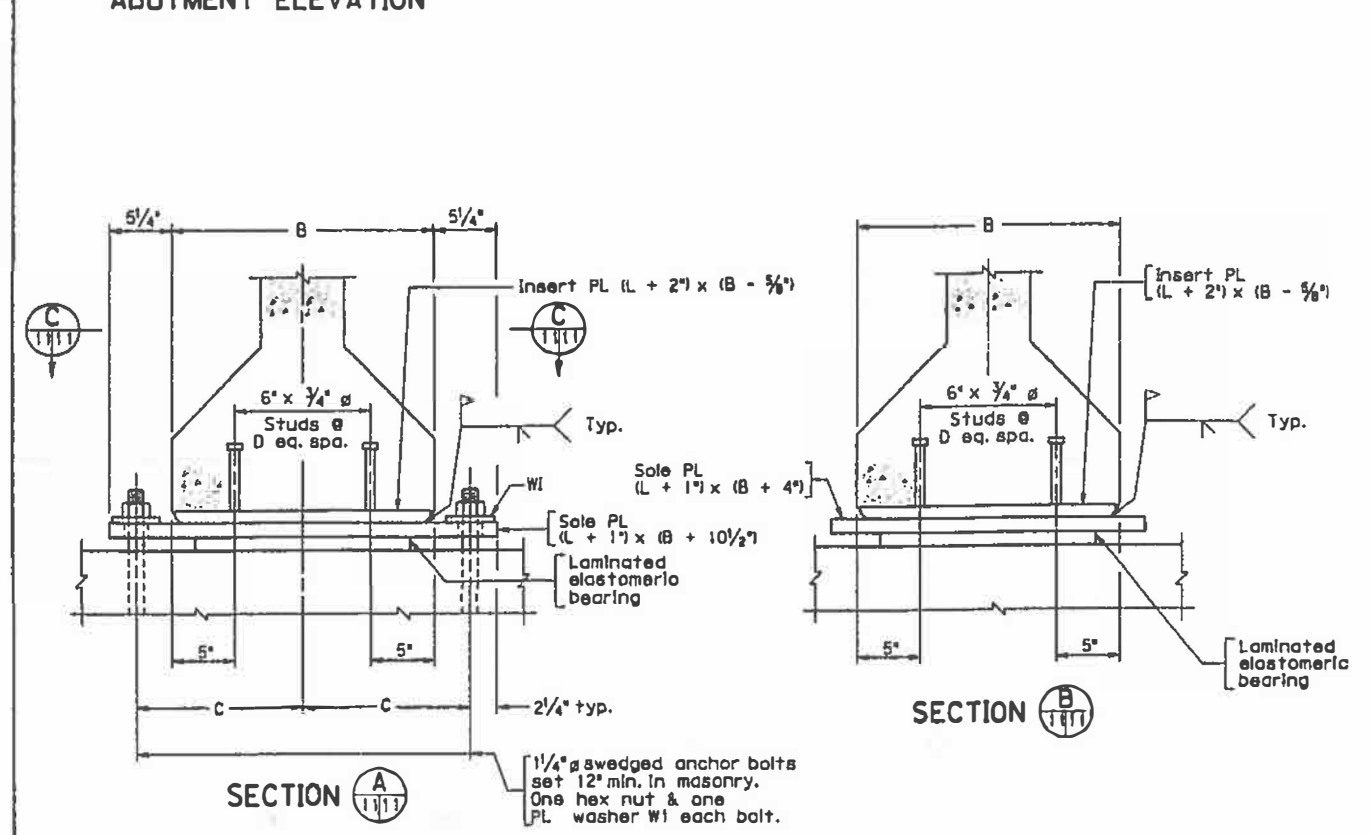

Beam Type	B	C	D
II	1'-6"	1'-0"	1
III	1'-10"	1'-2"	1
IV	2'-2"	1'-4"	2
V	2'-4"	1'-5"	3
VI	2'-4"	1'-5"	3

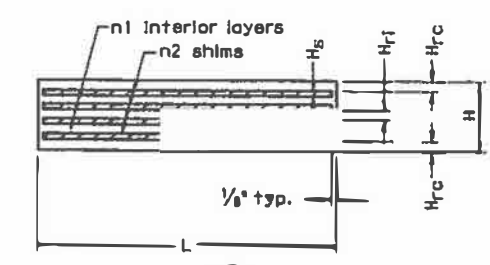

LAMINATED ELASTOMERIC BEARING

Span	Abut.	Pier	Beam Type	A	Laminated Elastomeric Bearing						Grade %
					W	L	H	H _{rc}	n1 @ H _{r1}	n2 @ H _g	
A	A	—	III	2 1/8"	16	11	1 1/8"	0.2500	2 @ 0.3519	3 @ 0.1196	1.6
A	—	1	III	2 3/8"	16	11	1 3/8"	0.2500	2 @ 0.3519	3 @ 0.1196	1.0
B	—	1	III	2 3/8"	16	11	1 3/8"	0.2500	2 @ 0.3519	3 @ 0.1196	1.0
B	—	2	III	2 7/8"	17	10	2 1/8"	0.2500	3 @ 0.3614	4 @ 0.1196	0.5
C	—	2	III	2 7/8"	17	10	2 1/8"	0.2500	3 @ 0.3614	4 @ 0.1196	0.5
C	B	—	III	3 1/8"	17	11	2 3/8"	0.2693	4 @ 0.3877	5 @ 0.1196	0

All dimensions in table are in inches.


PRESTRESSED CONCRETE BEARING DETAIL

No.	Description	Date	Designed:	Date	Plan No.
	Revisions		Drawn:		
			Checked:		


BBD-8 MOD 7-15-96

*Open deflection joint
1'-3" deep


ROUTE	PROJECT	ROUTE	PROJECT
-------	---------	-------	---------

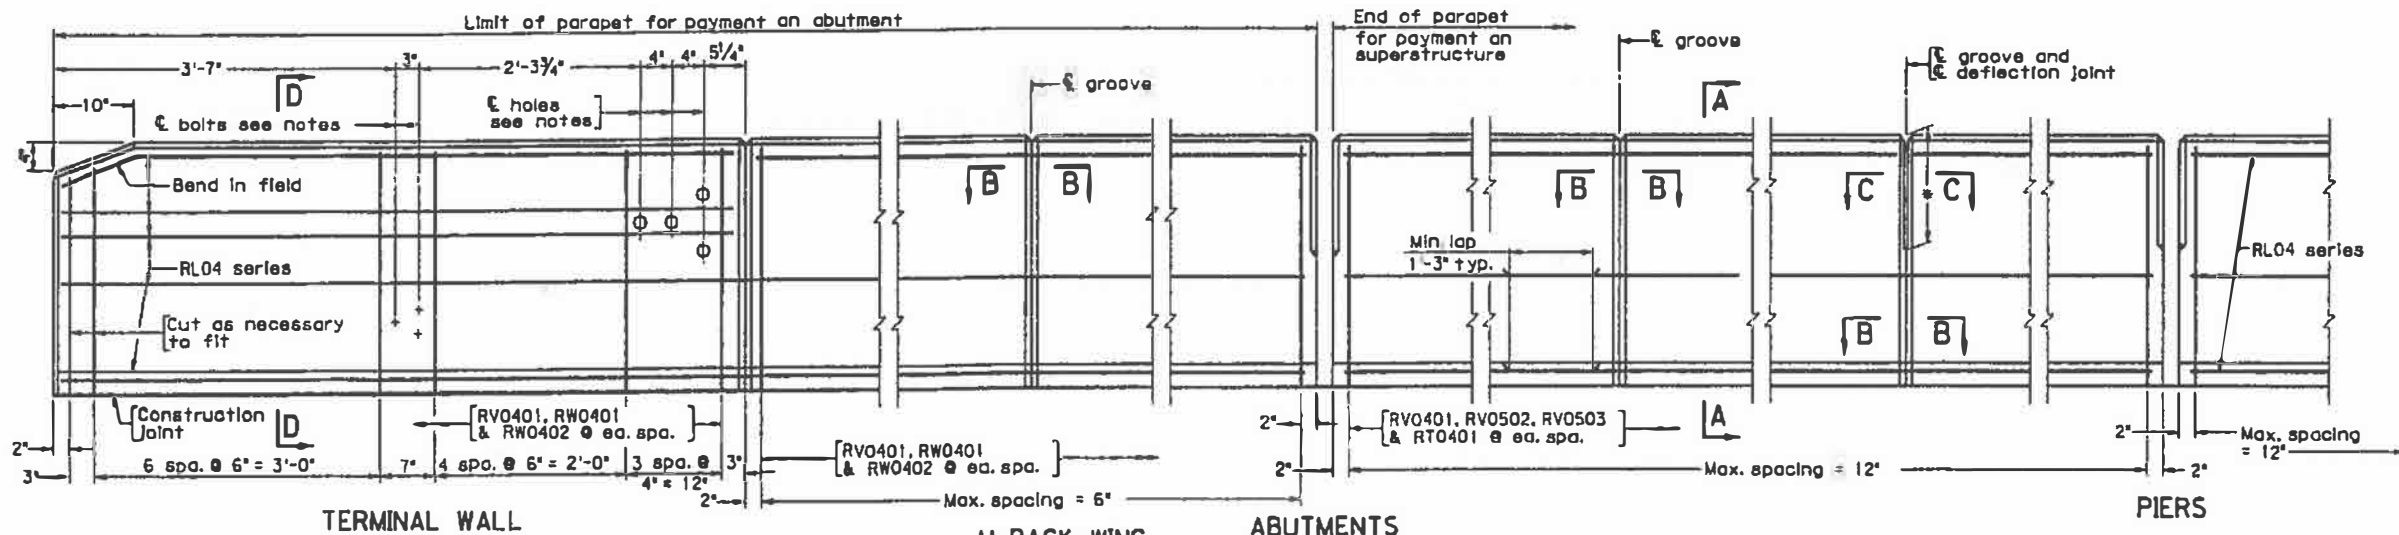


ELEVATION
Scale: 1" = 1'-0"

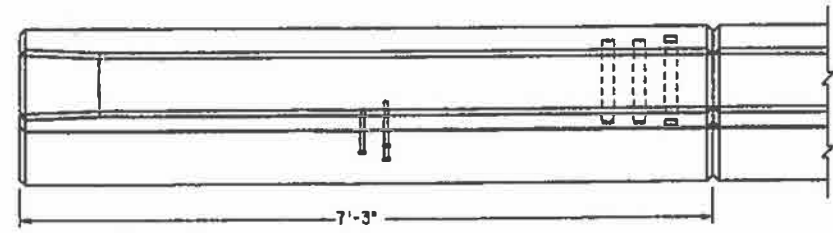

PART PLAN
Scale: 1" = 1'-0"

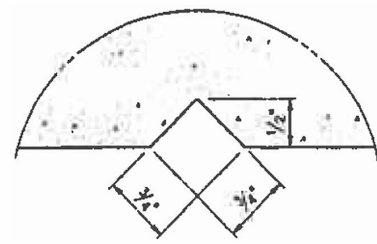


SECTION B-B
Full Scale
Groove detail for both sides of parapet

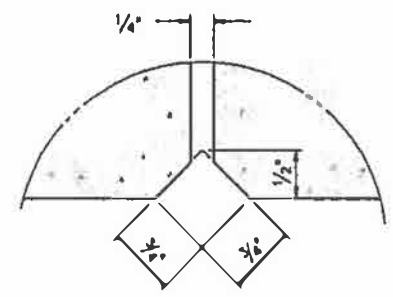


SECTION C-C
Full Scale
Deflection joint detail for both sides of parapet


REINFORCING STEEL SCHEDULE					
RV0401	RV0502	RV0503	RW0401	RW0402	RL04

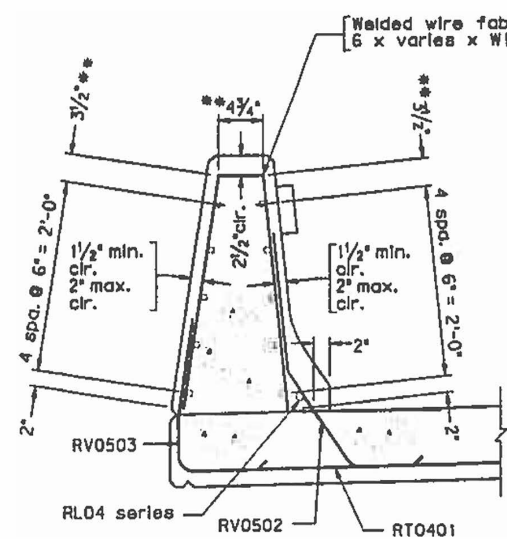


SECTION A-A
ALTERNATE REINFORCING STEEL
Scale 1" = 1'-0"

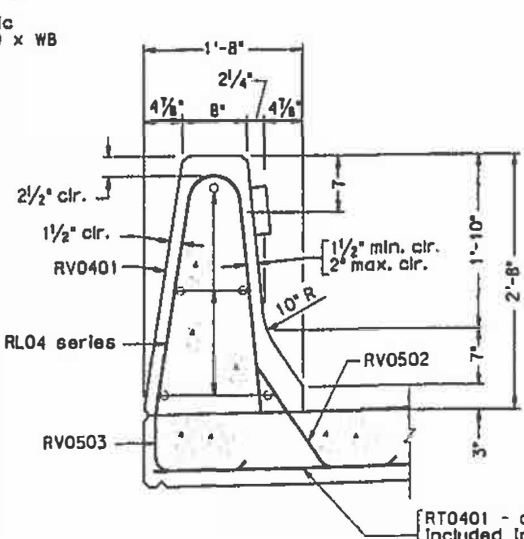


SECTION A-A
Scale: 1" = 1'-0"
Gross concrete quantities (C.Y.) = Ln. ft. x 0.105
All concrete above roadway slab

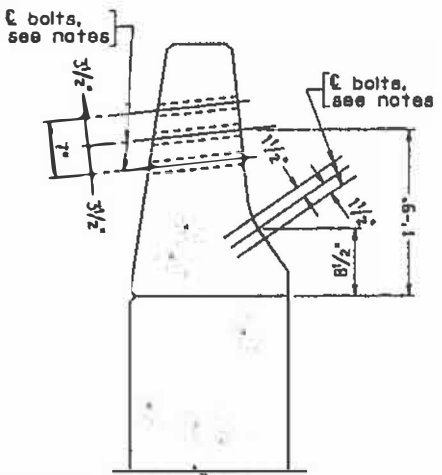

SECTION D-D
Scale: 1" = 1'-0"
Reinforcing steel not shown

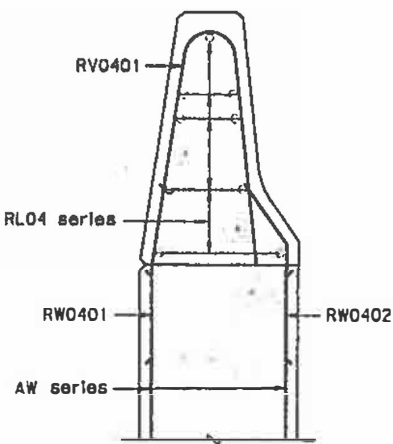

SECTION D-D
Scale: 1" = 1'-0"
Holes and bolts not shown. For details not shown, see Section A-A.

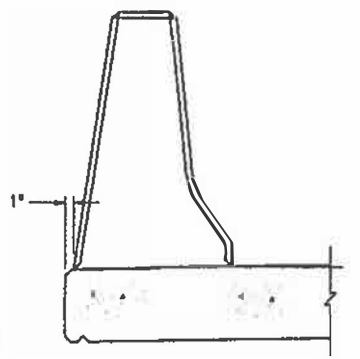

SECTION THRU JOINTS FOR EXTRUSION ONLY
Scale: 1" = 1'-0"

NOTES:

Rounded edges with 1" radius may be used in lieu of top of parapet.

Reinforcing bars RV0502 and RV0503 shall be galvanized. A reinforcing bar shall be epoxy coated.

Detail shown at pier is applicable when joint is in slab. If is continuous over pier, use groove and deflection joint.

Spacing of grooves to be approximately 8'-0". If lighting is used (see Bridge Conduit System), groove shall be spaced approximately 4'-0" from light standard. Spacing of deflection joints shall not exceed three groove spaces.

Barrier delineator size, color, and spacing to be in accordance with the Specifications. Cost of delineator to be included in price bid for parapet. Reflective surface of barrier delineator to be facing oncoming traffic.

The Contractor shall determine all dimensions and details necessary for installation.

All concrete shall be Class A4.

For details of wingwall below construction joint, see abutment sheet.

Terminal walls are detailed to take guardrail attachment.

Holes, where shown, shall be formed with sleeves of 1 1/2" nominal pipe.

Bolts, where shown, shall be 3/8" dia. expansion anchor bolts to be drilled and installed when rub rails attached.

For extruded parapets: During extrusion, open joints at and piers shall be formed by the use of lubricated plate or other means so that uniformity of the opening and channel is maintained. Dimension of 1" (as shown in Section thru Joint Extrusion Only) is additional deck slab that shall be cast. Contractor's expense. Dimension(s) to face of curb shall not exceed.

Dimensions in bending diagram are out to out of bars, except as shown.

Mark	No.	Size	Length	Pin Ø	Lacc
RT0401		#4	3'-0"	—	Slab
RV0401		#4	5'-2"	4 1/2"	Parapet
RV0502		#5	3'-10"	3 3/4"	Parapet
RV0503		#5	2'-4"	3 3/4"	Parapet
RW0401		#4	2'-0"	3"	Terminal W
RW0402		#4	2'-5"	3"	Terminal W
RL04		#4	—	—	Parapet

Cost of all bars listed in schedule to be included in price bid for

No.	Description	Date	Designed	Date	Plan No.
			Drawn: ...		
			Checked:		

2-01-99
CADD
BPB-3A

- ① 4" F.R.E. duct
- ② 4" galv. steel duct
- ③ 4" PVC-B duct
- ④ PVC-galv. adaptor
- ⑤ Galv.-F.R.E. adaptor
- ⑥ F.R.E. exp. joint
- ⑦ F.R.E. look ring

***Limit of telephone conduit in bridge contract when approach slabs or drainage aprons are not used shall be the extension of the conduit a minimum of one foot behind back of backwall.

REGION	ROUTE	PROJECT	ROUTE	PROJECT

NOTES:

Glass fiber reinforced epoxy (FRE) duct shall comply with D2310 and ASTM D2996, and shall be RTRP-III, except as noted herein.

Inside diameter shall be 4.00" minimum, wall thickness shall be minimum.

Duct performance shall not be impaired by exposure to ultraviolet radiation. Duct shall have fire resistance which equals requirements of U.L. 651 - Section 17.

Joints shall be positive locking, (threaded bell and spigot, sleeve bonded bell and spigot, or driven tapered bell spigot).

Expansion joints shall be sliding sleeve type, with or without rings, with provision for minimum of 6" expansion travel.

Lock rings shall be split FRE duct, minimum of 3" long, 0.010" minimum thickness, glued in place after installation of conduit.

Threaded couplings shall be used on steel conduit.


Steel fittings and rods shall be galvanized in accordance with ASTM A153.

Support angles shall be galvanized in accordance with ASTM A153.

Hanger details shown are designed to support as many as 12 ducts. Dead loads used were as follows: Cables = 8.5 lbs./ft., Conduit = 0.8 lbs./ft.


Underground installation of PVC-B duct shall be in accordance with Road and Bridge Standards ECI-1 except the minimum spacing between ducts shall be 1/4".

Contractor shall space supports for the telephone conduit such that the 3/4" inserts for the H.S. bolts will not interfere with the draped strands in the prestressed concrete.

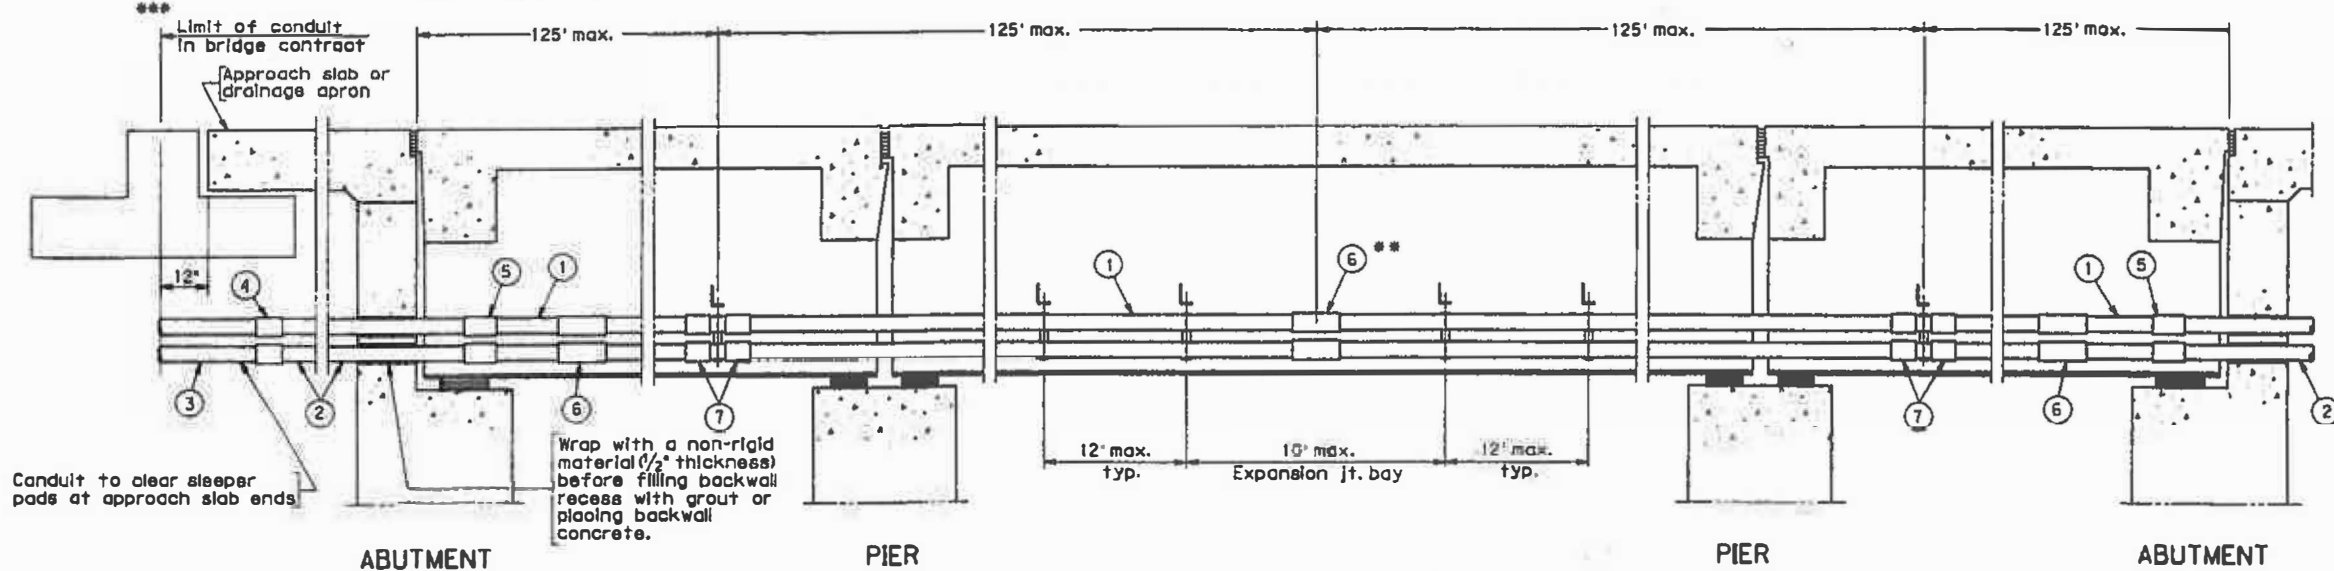


SHORT SPAN BRIDGES
Max. span L = 200'

** Not required on bridges under 250' total length.

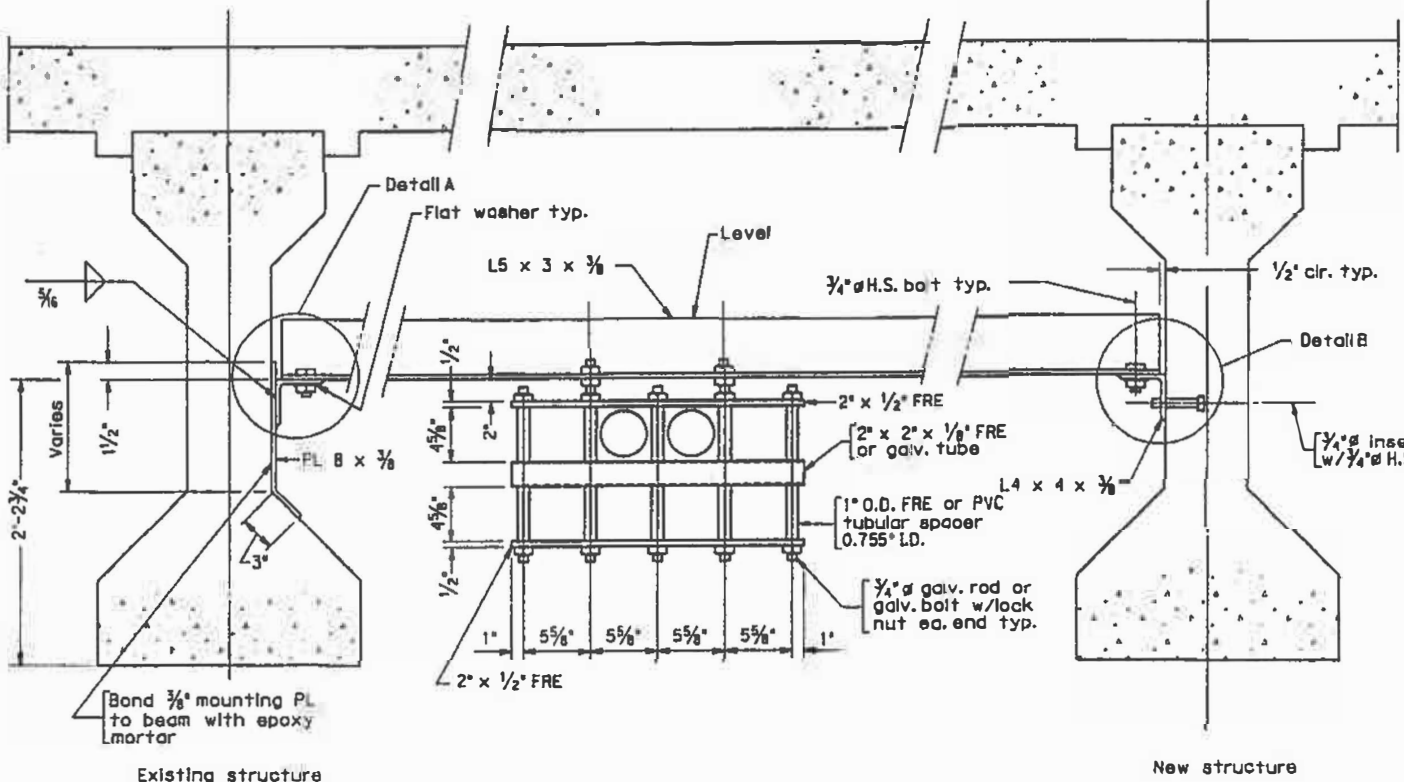


TYPICAL SUPPORT DETAIL

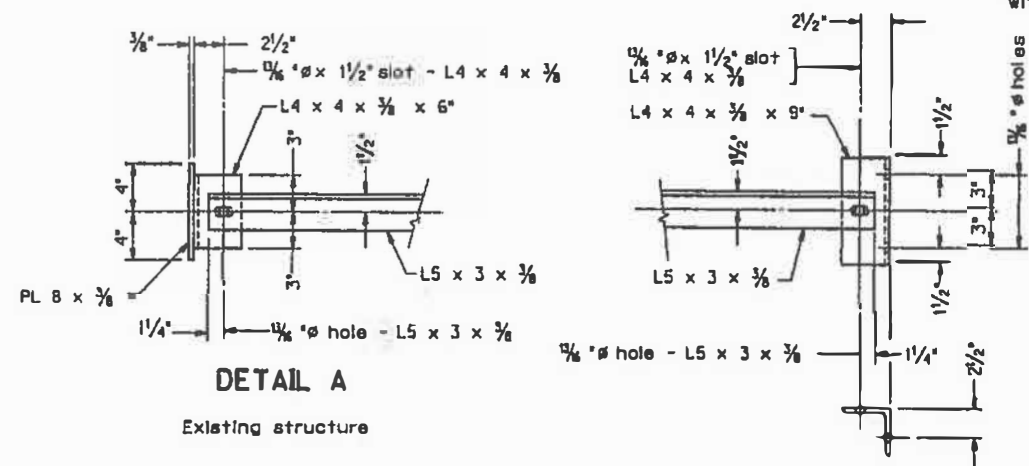


DETAIL A
Existing structure

DETAIL B
New structure

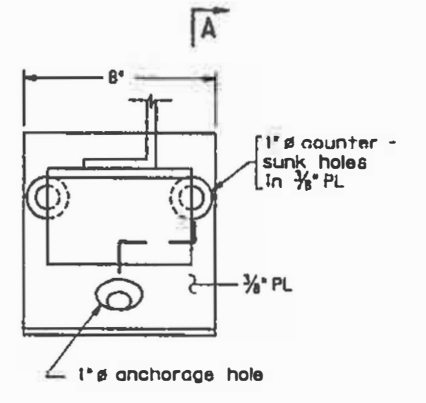


ELEVATION

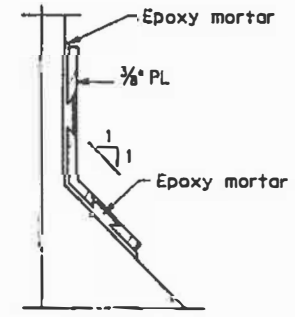

SECTION A-A

CONDUIT FORMATIONS

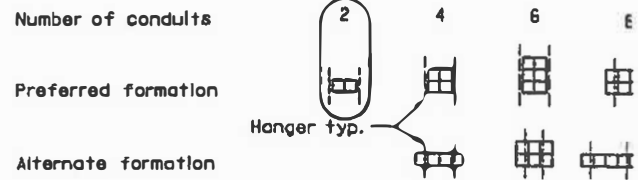


TELEPHONE CONDUIT


No.	Description	Date	Designed:	Date	Plan No.
			G. Henderson		
			Drawn:		
			Checked:		

CADD 7-1-93
BTC-7 MOD.


- Notes:
1. When finishing concrete between and beyond pier surface to drain from pier to edge of oap.
 2. Piles to be driven to depths in accordance with Specifications 403.06 (e).
 3. For spacing of dowel bars, see sheet 10.
 4. The cost for dowel bars shall be included in the for substructure concrete.

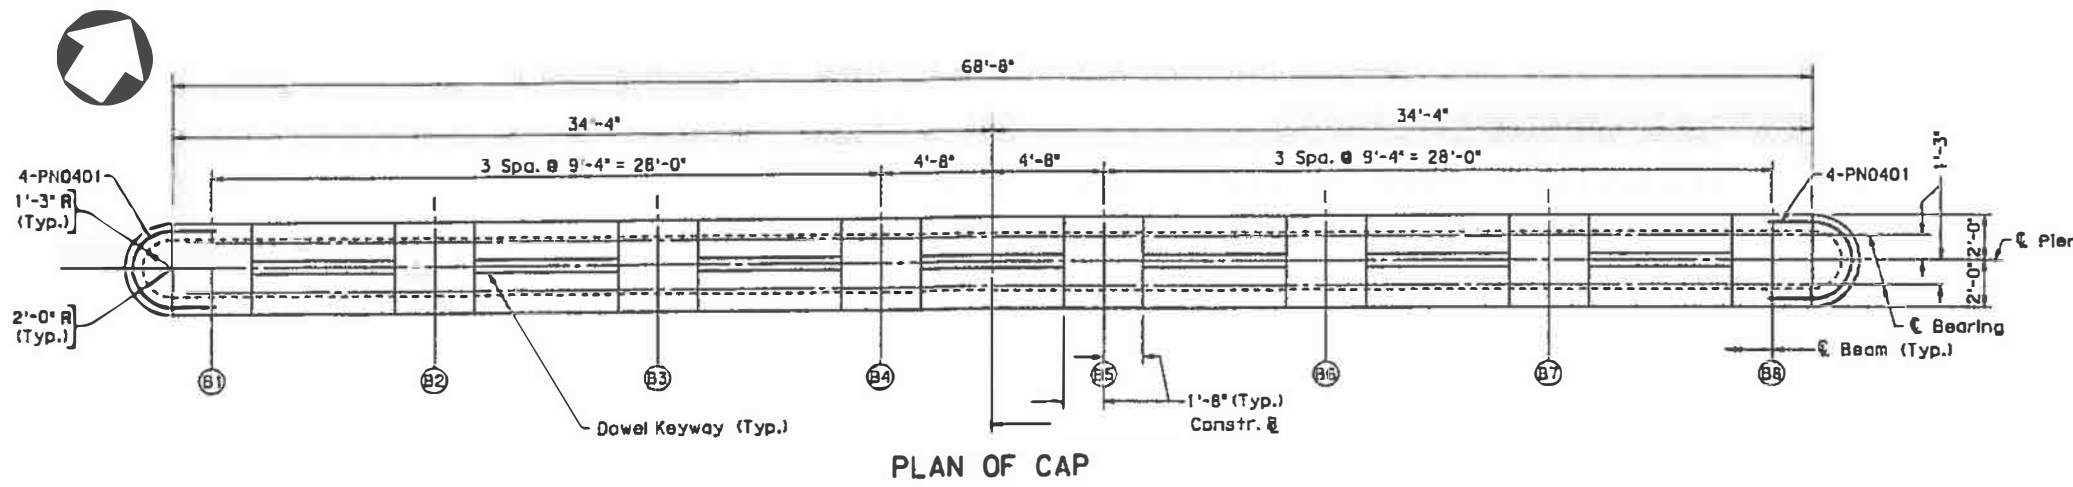


PLAN OF CAP

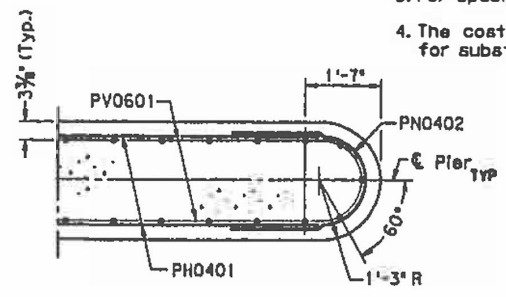


SECTION B
Scale: 1/2" = 1'-0"

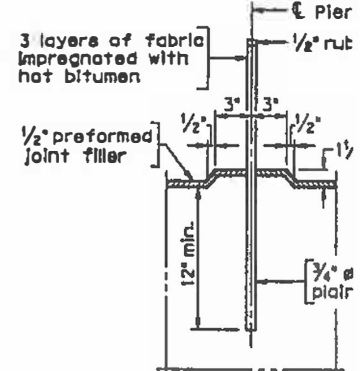


DOWEL DETAIL
Pier 1 Only - Typ. between
Scale: 1/2" = 1'-0"

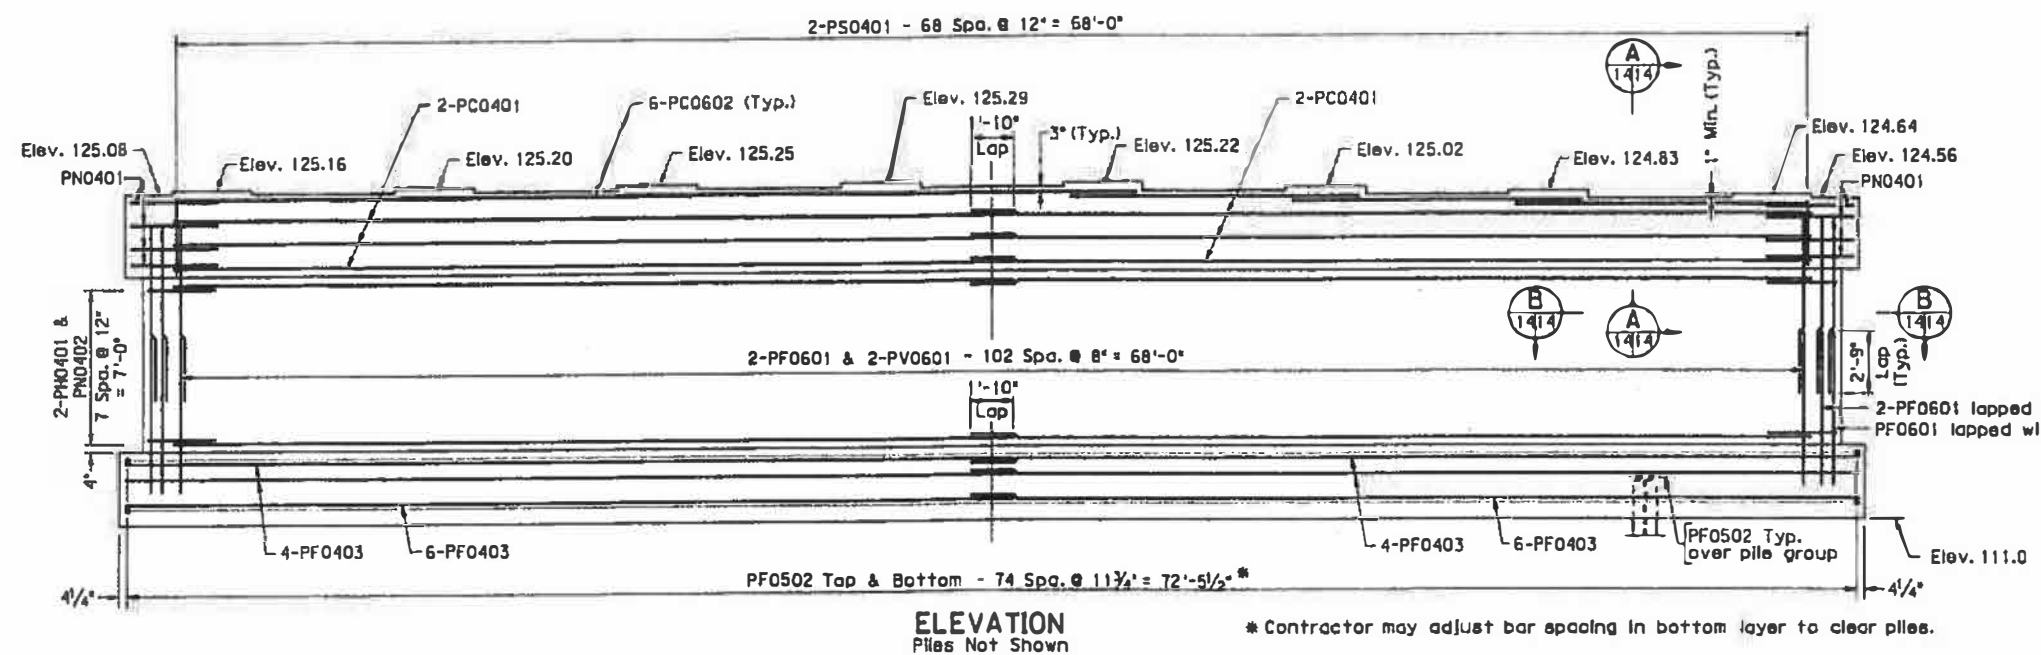


ELEVATION
Piles Not Shown

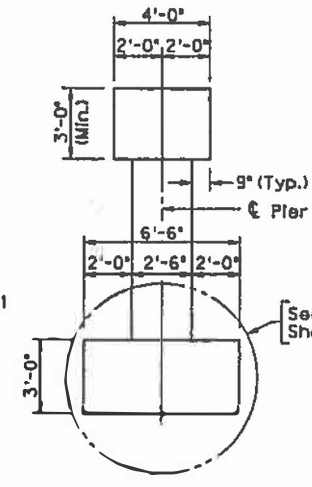

END VIEW
Piles Not Shown

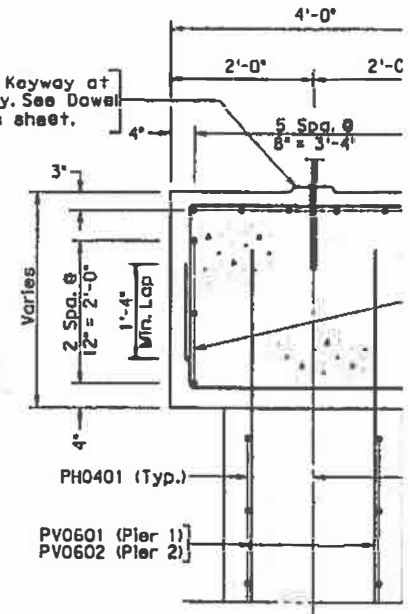

SECTION A
Scale: 3/4" = 1'-0"

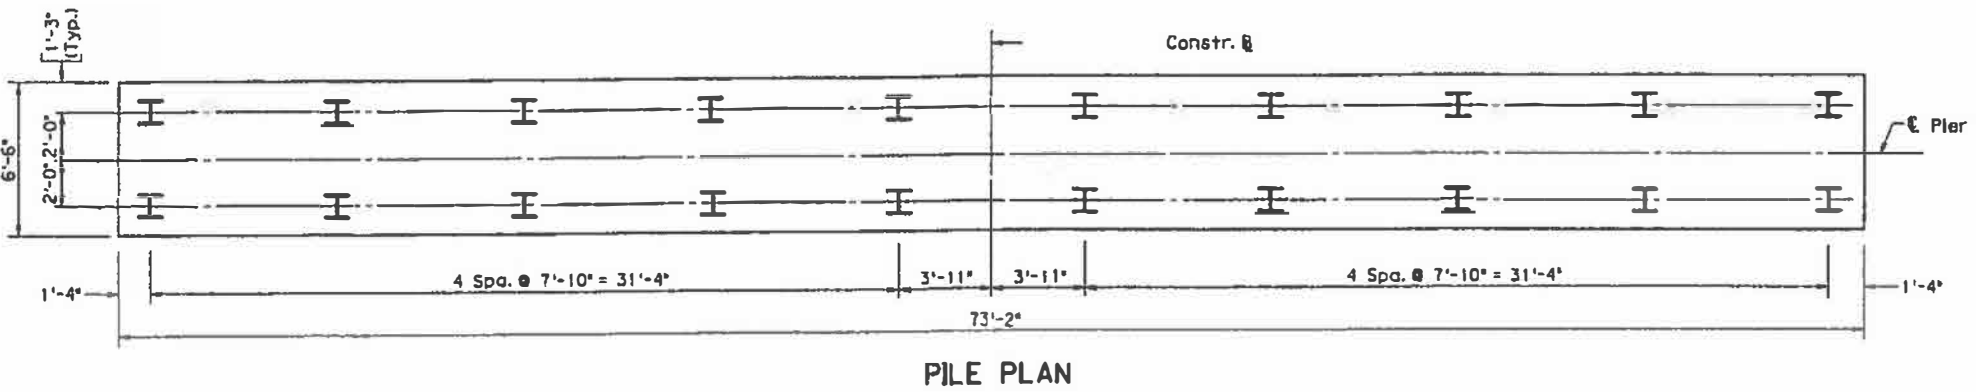


PILE PLAN


Scale: 1/4" = 1'-0" unless otherwise noted

PIER 1				
No.	Description	Date	Designed:	Date
			Drawn:	
			Checked:	
	Revisions			Plan No.


- Notes:
- When finishing concrete between and beyond pier surface to drain from pier to edge of cap.
 - Piles to be driven to depths in accordance with Specifications 403.06 (e).

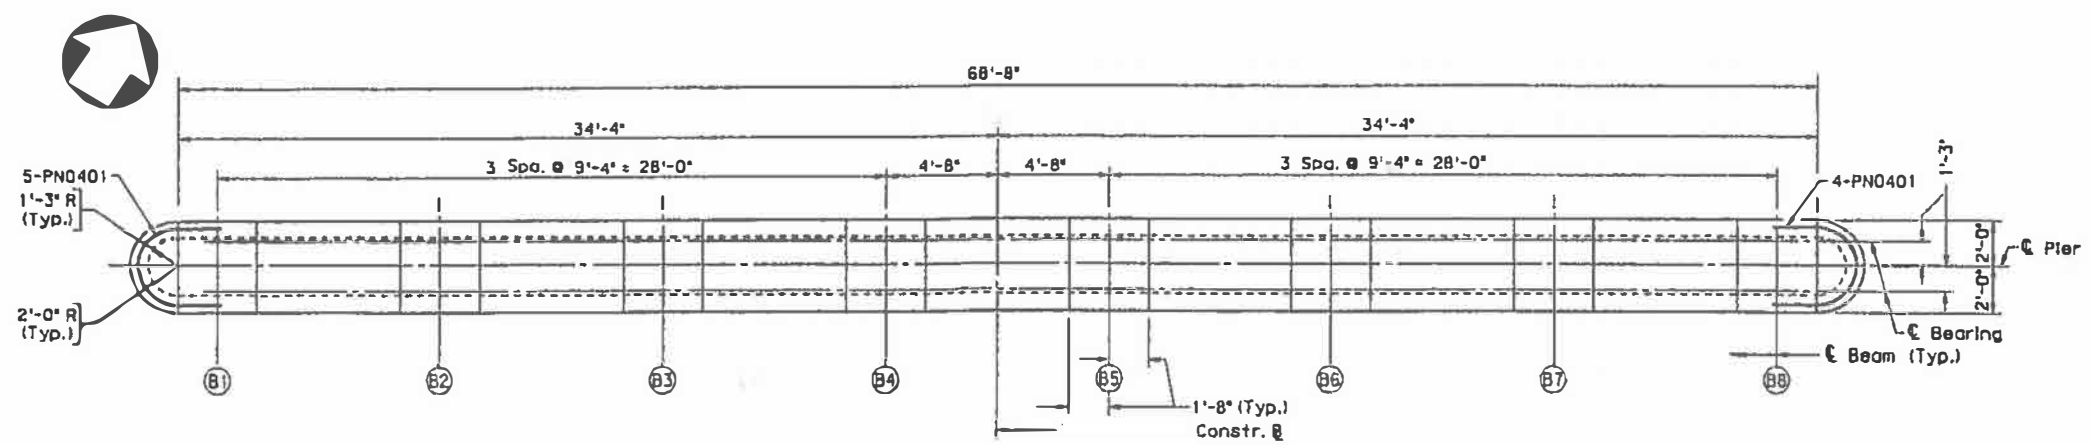


PLAN OF CAP

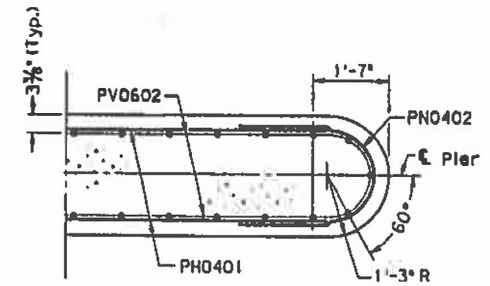


SECTION B (15/15)
Scale: 1/2" = 1'-0"

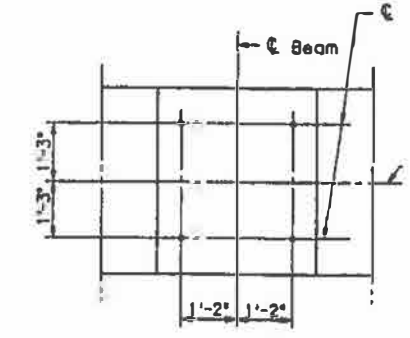


TYPICAL ANCHOR BOLT LA
Scale: 1/2" = 1'-0"

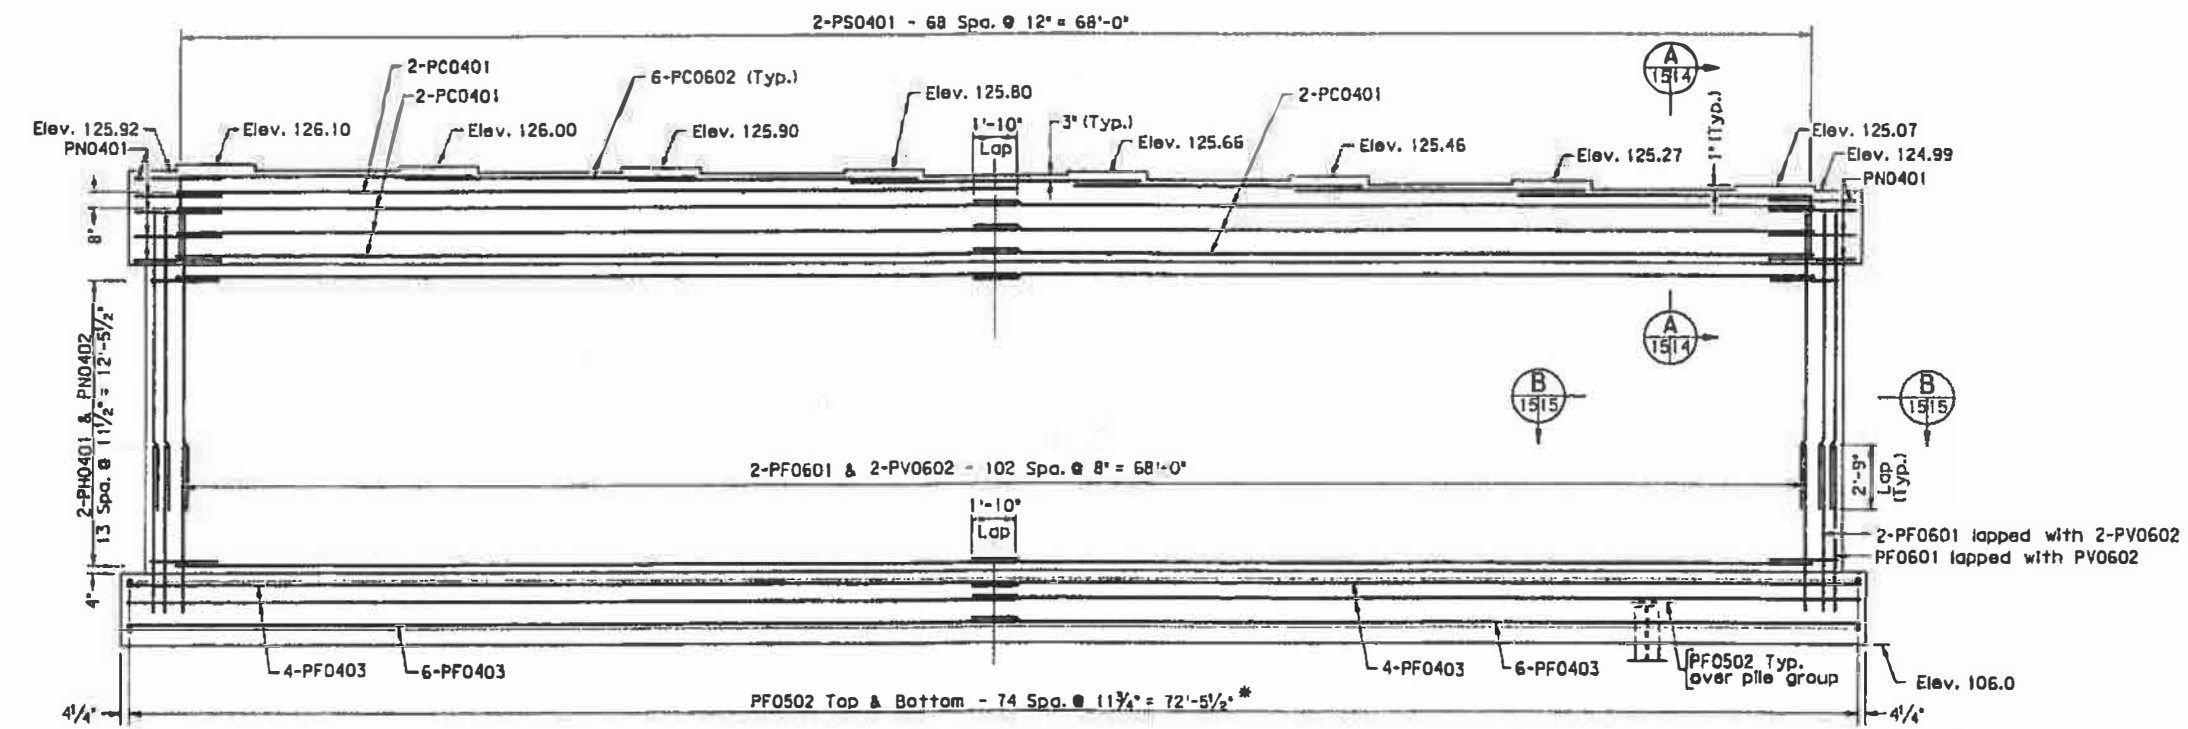


ELEVATION
Piles Not Shown

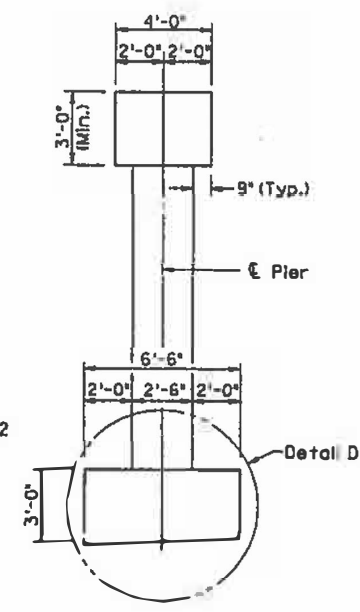

END VIEW
Piles Not Shown

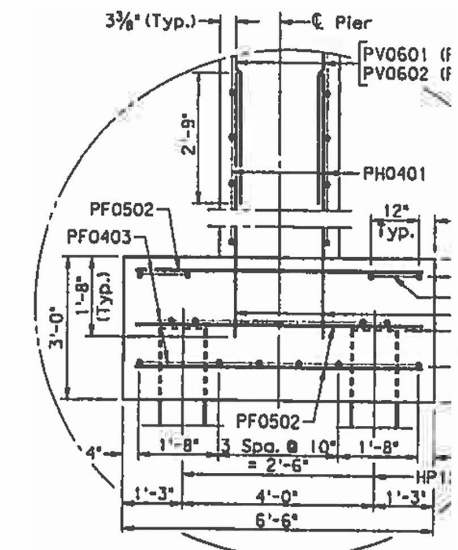

DETAIL D

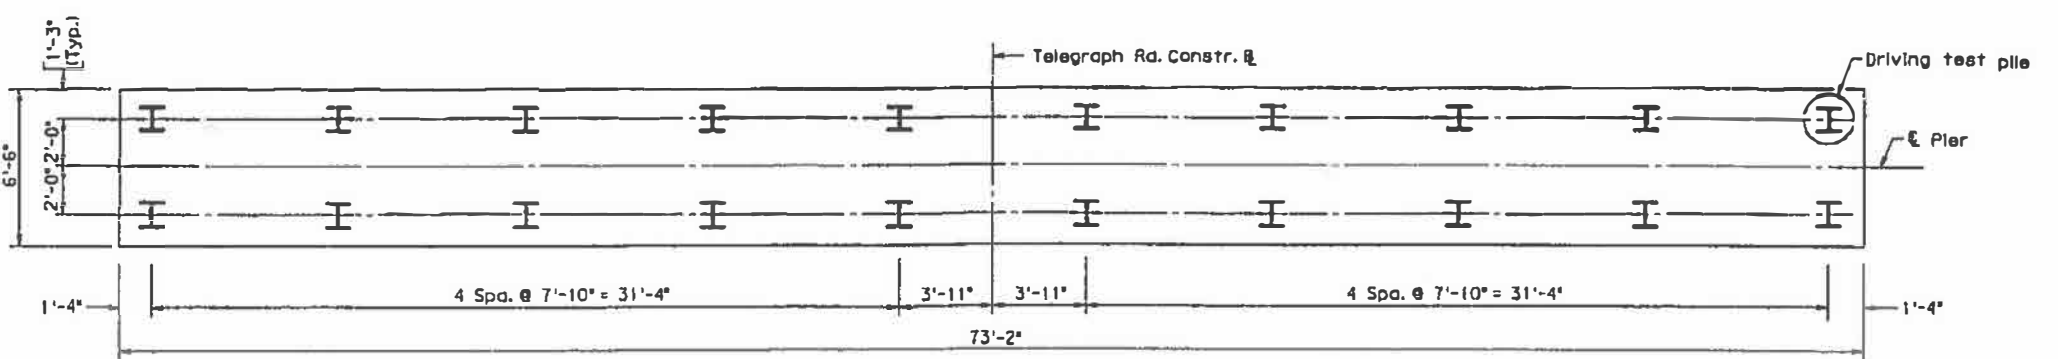


PILE PLAN


Scale: 1/4" = 1'-0" unless otherwise noted

PIER 2				
No.	Description	Date	Designed:	Date
			Drawn:	Plan No.
	Revisions		Checked:	

REGION	STATE	ROUTE	PROJECT	ROUTE	PROJECT
--------	-------	-------	---------	-------	---------

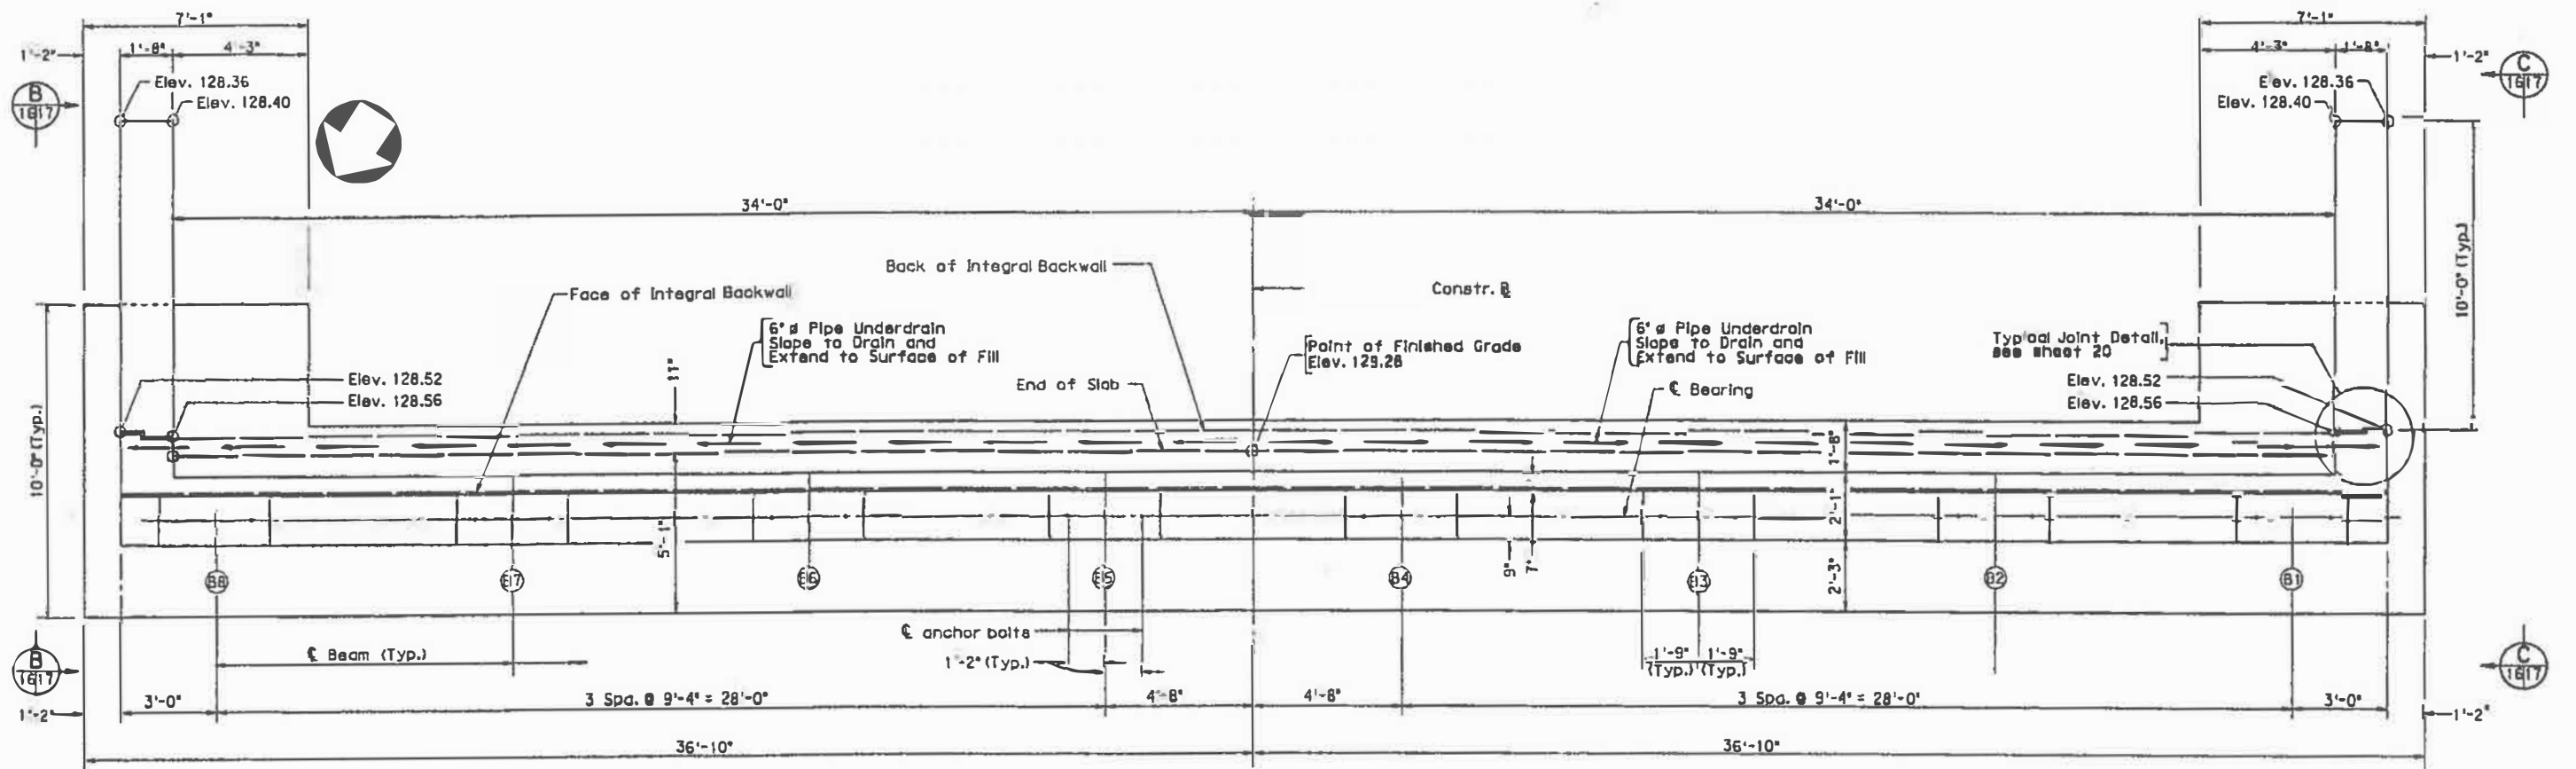


PLAN
Scale: 3/8" = 1'-0"

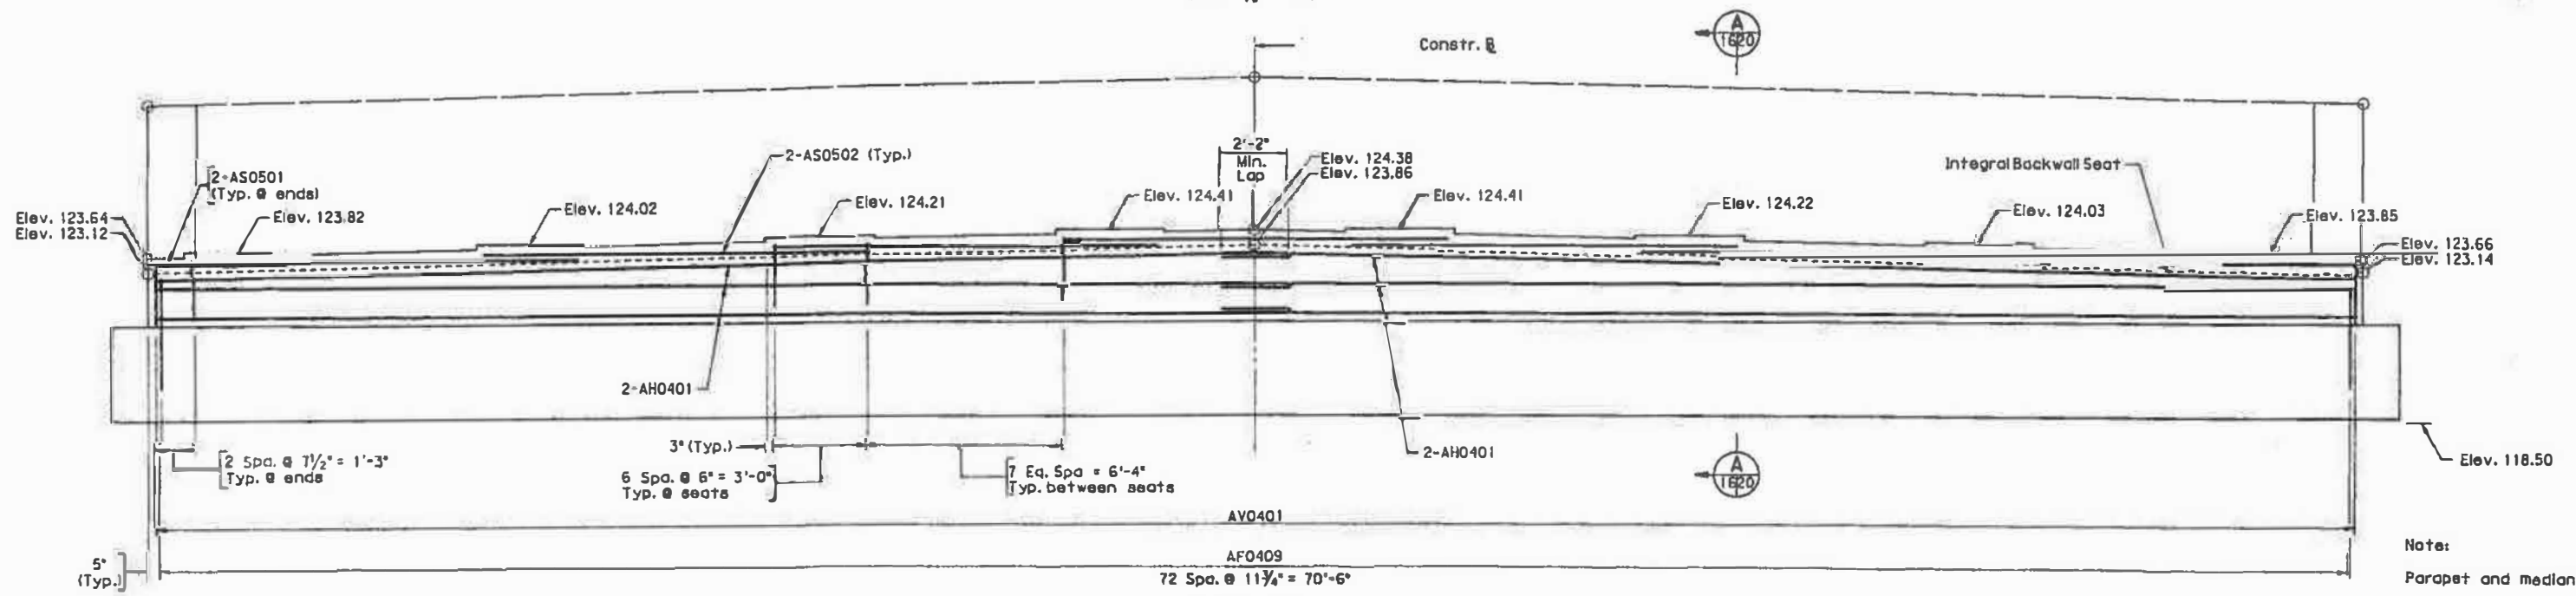


ELEVATION
Footing reinforcement and piles not shown
Scale: 3/8" = 1'-0"

No.	Description	Date	Designed:	Drawn:	Checked:	Date	Plan No.


**ABUTMENT A
PLAN & ELEVATION**

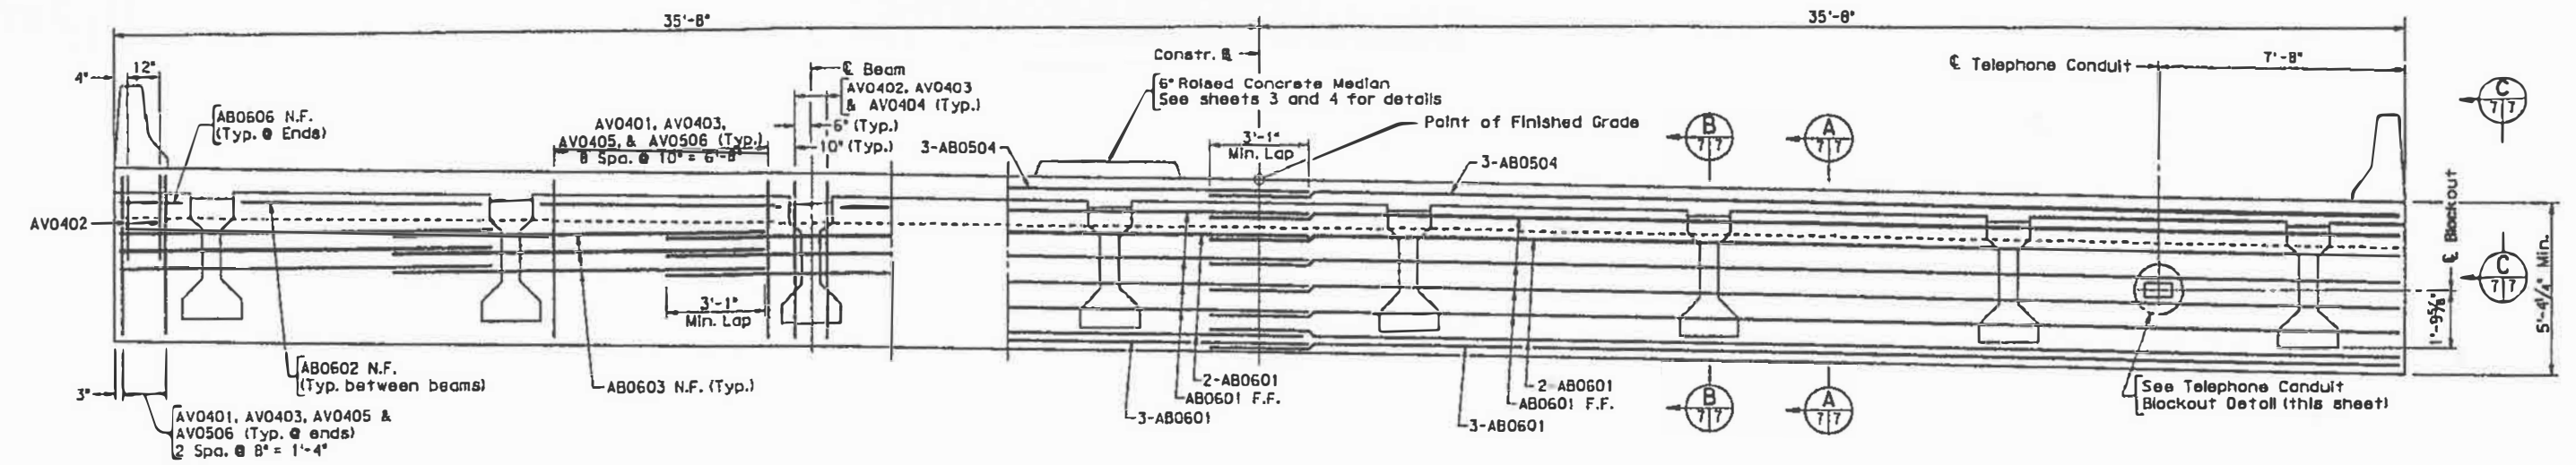


ELEVATION - INTEGRAL BACKWALL
Looking Ahead
Scale: 3/8" = 1'-0"

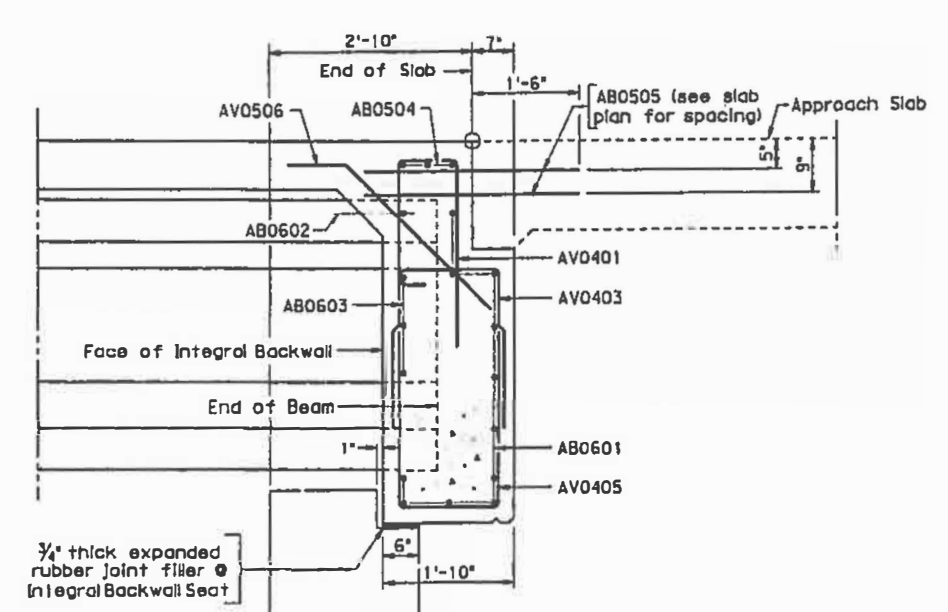


SECTION A
Scale: 3/4" = 1'-0"

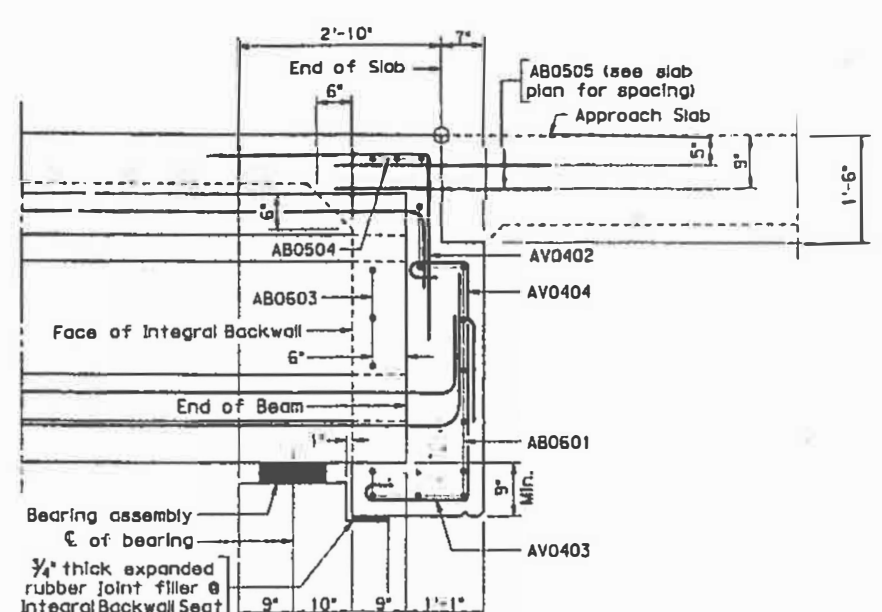

SECTION B
Scale: 3/4" = 1'-0"

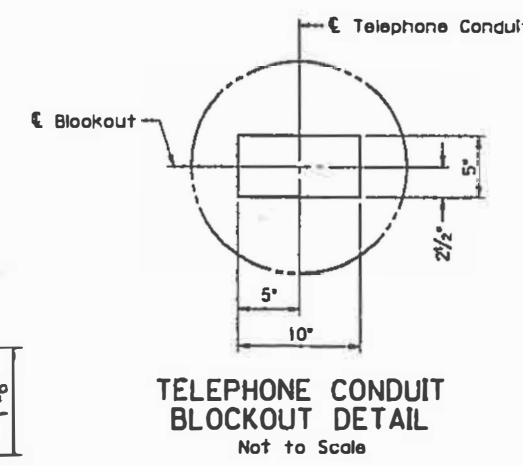

TELEPHONE CONDUIT BLOCKOUT DETAIL
Not to Scale

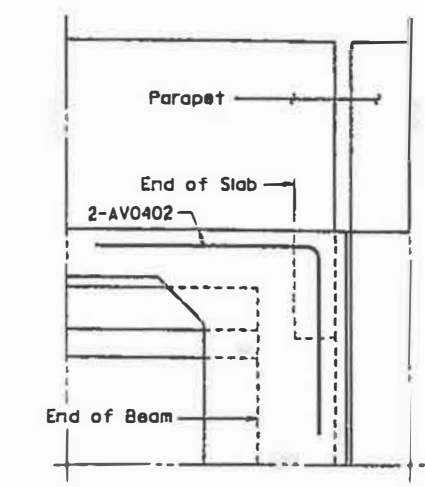


VIEW C
Scale: 3/4" = 1'-0"
For additional reinforcement, see Section A

Note:
Reinforcing steel in backwall shall be adjusted to clear tele conduit blockout.

Legend:
N.F. - Near Face
F.F. - Far Face

No.	Description	Date	Designed:	Date	Plan No.
	Revisions		Drawn:		
			Checked:		

**BACKWALL DETAIL
ABUTMENT B**

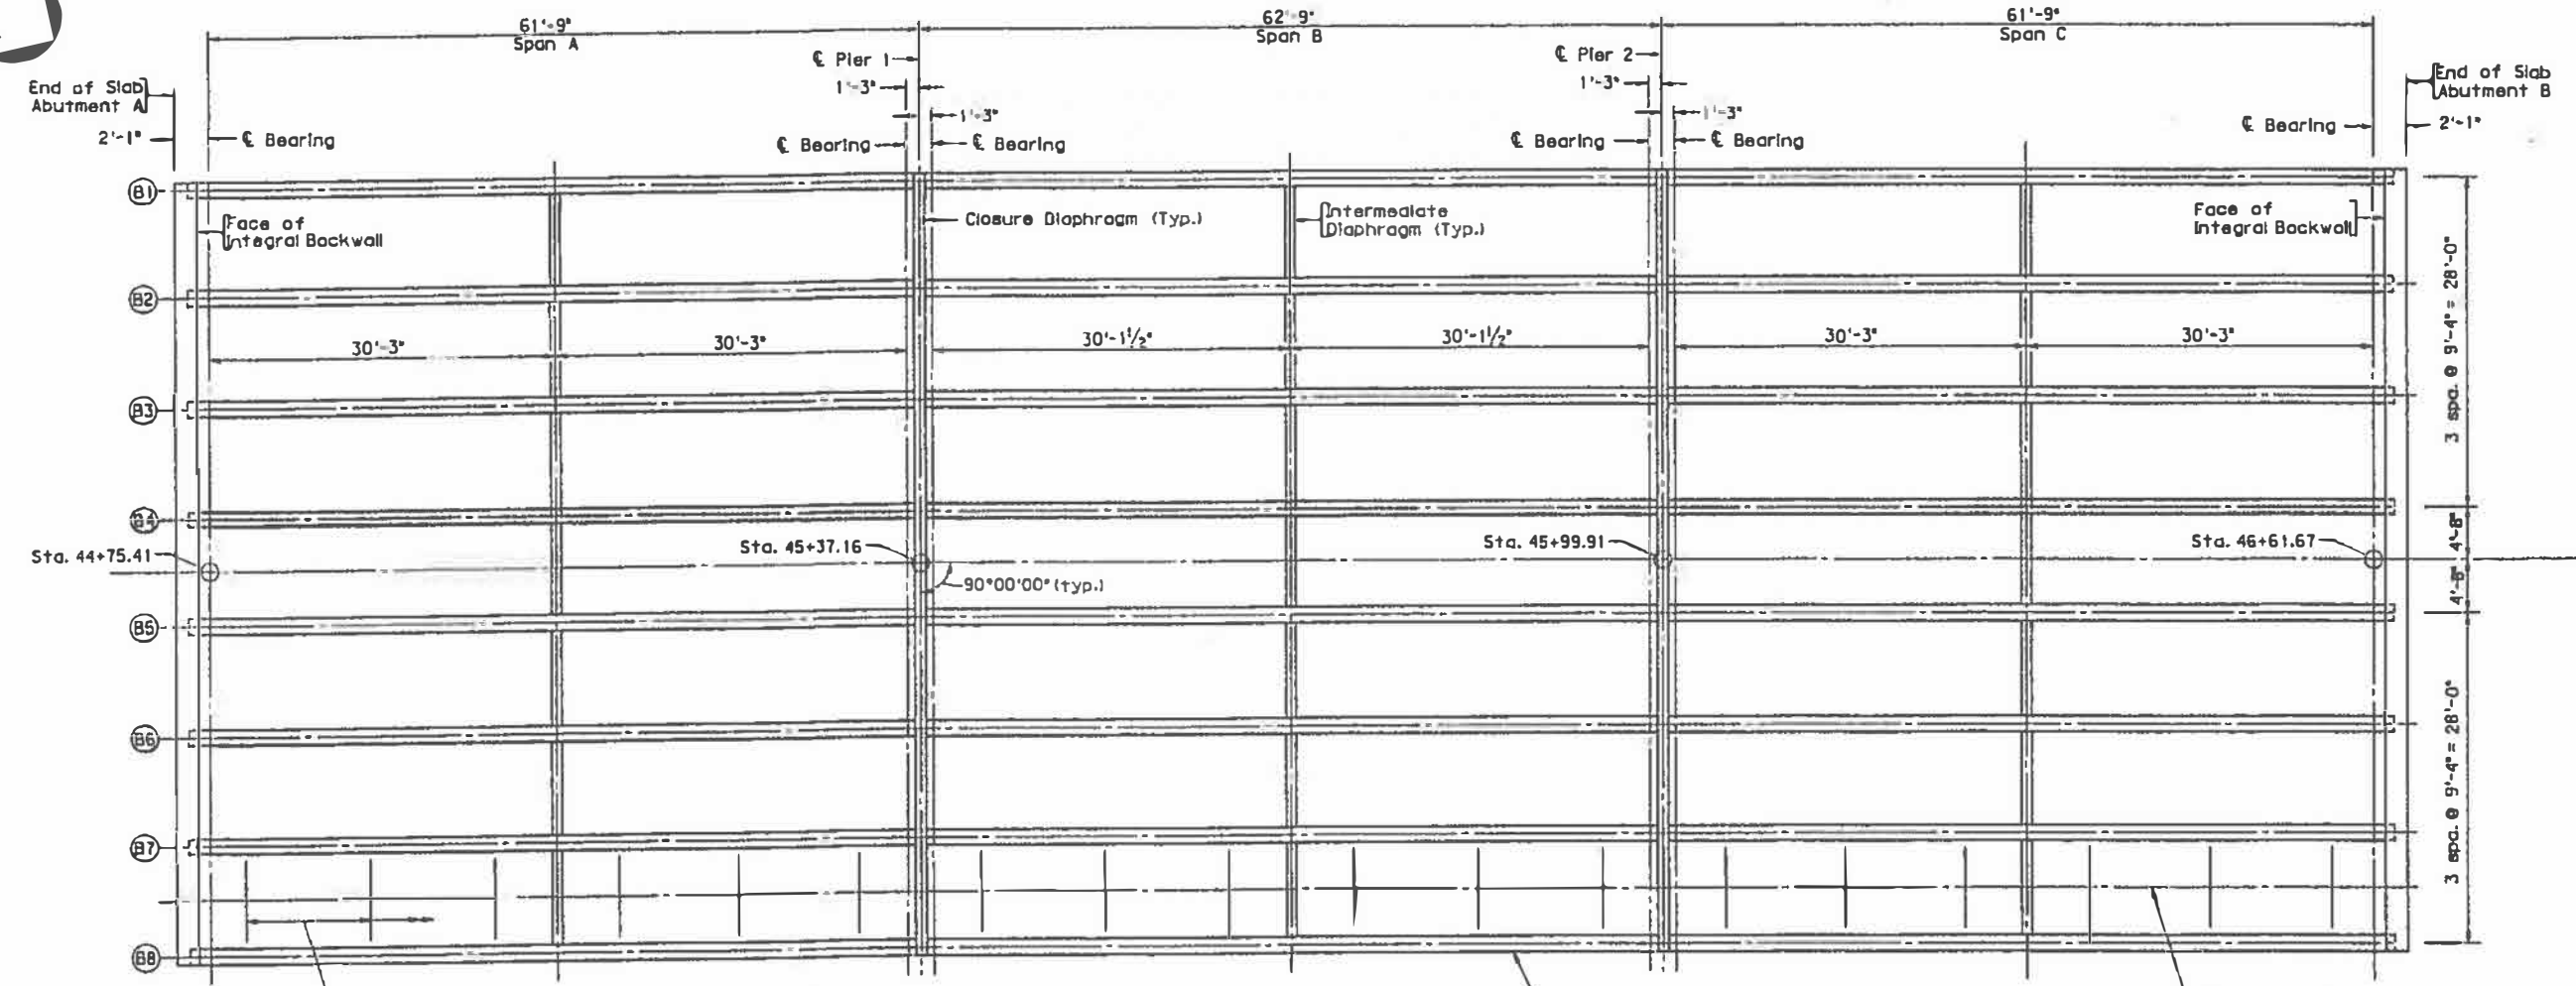

ERECTION DIAGRAM
Scale: 1/8" = 1'-0"


Span	Beam	Points				
		1	2	3	4	5
Span A	1	128.65	129.00	129.34	129.65	129.94
	2	128.84	129.16	129.45	129.73	129.98
	3	129.03	129.31	129.57	129.81	130.03
	4	129.22	129.46	129.69	129.90	130.08
	5	129.21	129.44	129.65	129.84	130.01
	6	129.02	129.25	129.46	129.65	129.81
	7	128.83	129.05	129.26	129.45	129.62
	8	128.63	128.86	129.07	129.26	129.43
Span B	1	129.98	130.25	130.50	130.72	130.93
	2	130.03	130.26	130.47	130.66	130.83
	3	130.07	130.26	130.44	130.60	130.74
	4	130.11	130.27	130.41	130.54	130.64
	5	130.03	130.18	130.30	130.41	130.49
	6	129.84	129.98	130.11	130.21	130.30
	7	129.65	129.79	129.91	130.02	130.10
	8	129.45	129.60	129.72	129.83	129.91
Span C	1	130.96	131.15	131.32	131.46	131.59
	2	130.86	131.01	131.14	131.25	131.34
	3	130.76	130.87	130.97	131.04	131.10
	4	130.65	130.73	130.79	130.83	130.85
	5	130.51	130.57	130.61	130.62	130.61
	6	130.31	130.37	130.41	130.41	130.36
	7	130.12	130.18	130.22	130.20	130.12
	8	129.92	129.98	130.03	129.99	129.87

Location	Live Load + I (Service Load)		Non-Composite DL (Service Load)		Composite DL (Service Load)		Release Stress at 0.4 L		Final Stress (Pos. Mom.)**				Final Stress (Neg. Mom.)				
	Max. M	Max. V	Max. M	Max. V	Max. M	Max. V	Top	Bottom	P/S+DL+LL		P/S+DL		P/S+DL+LL		P/S+DL		
	k-ft	k	k-ft	k	k-ft	k	psi	psi	psi	psi	psi	psi	psi	psi	psi	psi	
Span A & C																	
CL Brg. Abut A	Interior Beam	72.8	58.4	0.0	54.0	12.4	9.8	-----	-----	-60.8	626.5	-77.8	707.4	-242.2	1489.3	-118.4	900.4
	Exterior Beam	52.1	41.8	0.0	47.3	10.2	8.0	-----	-----	-61.9	644.5	-77.1	703.6	-229.4	1295.9	-118.7	865.5
Midspan	Interior Beam	682.3	33.7	840.4	1.5	116.3	2.9	-----	-----	1358.8	-210.1	1199.5	547.7	1157.6	746.7	1199.5	547.7
	Exterior Beam	488.2	24.1	726.4	0.7	95.5	2.3	-----	-----	1079.6	216.5	937.2	770.3	899.7	915.8	937.2	770.3
CL Brg. Pier 1	Interior Beam	-530.3	69.5	0.0	56.1	-161.3	15.5	-----	-----	-60.8	626.5	-77.8	707.4	-242.2	1489.3	-118.4	900.4
	Exterior Beam	-379.5	49.8	0.0	48.3	-132.4	12.7	-----	-----	-61.9	644.5	-77.1	703.6	-229.4	1295.9	-118.7	865.5
Span B																	
CL Brg. Pier 1	Interior Beam	-480.6	63.3	0.0	53.9	-145.2	12.6	-----	-----	-94.0	783.2	-114.4	880.0	-226.6	1413.9	-114.4	880.0
	Exterior Beam	-343.9	45.3	0.0	47.1	-119.3	10.3	-----	-----	-96.5	777.6	-114.6	848.3	-215.0	1238.5	-114.6	848.3
Midspan	Interior Beam	588.5	26.7	833.7	1.5	43.8	0.0	-----	-----	1307.0	-20.9	1169.6	632.7	1117.9	878.5	1169.6	632.7
	Exterior Beam	421.1	19.1	720.5	0.8	36.0	0.0	-----	-----	1031.2	364.4	908.4	842.1	862.2	1021.7	908.4	842.1
CL Brg. Pier 2	Interior Beam	-480.8	63.3	0.0	53.9	-145.2	12.6	-----	-----	-94.0	783.2	-114.4	880.0	-226.6	1413.9	-114.4	880.0
	Exterior Beam	-344.0	45.3	0.0	47.2	-119.3	10.3	-----	-----	-96.5	777.6	-114.6	848.3	-215.0	1238.5	-114.6	848.3

* Maximum Moments at End Spans may not be at midspan.
 ** Positive Moment does not include creep and shrinkage.

Note:
 Spacing of supports for the telephone conduit system is not shown. See telephone conduit for actual spacing.


- References:
1. For prestressed girder details, see sheet 9.
 2. For diaphragm details, see sheet 10.
 3. For bearing details, see sheet 11.
 4. For integral backwall details, see sheets 6 & 7.
 5. For telephone conduit details, see sheet 12.

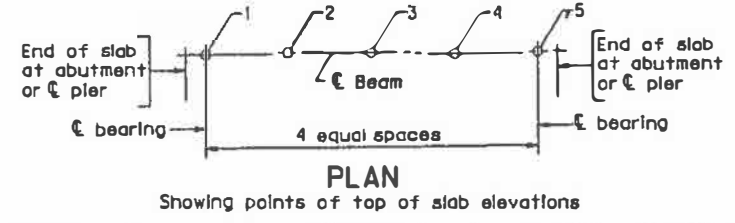



No.	Description	Date	Design Checked	Date	Plan No.
Revisions					

ERECTION DIAGR.


CADD PCB-3C MOD. 11-21-96

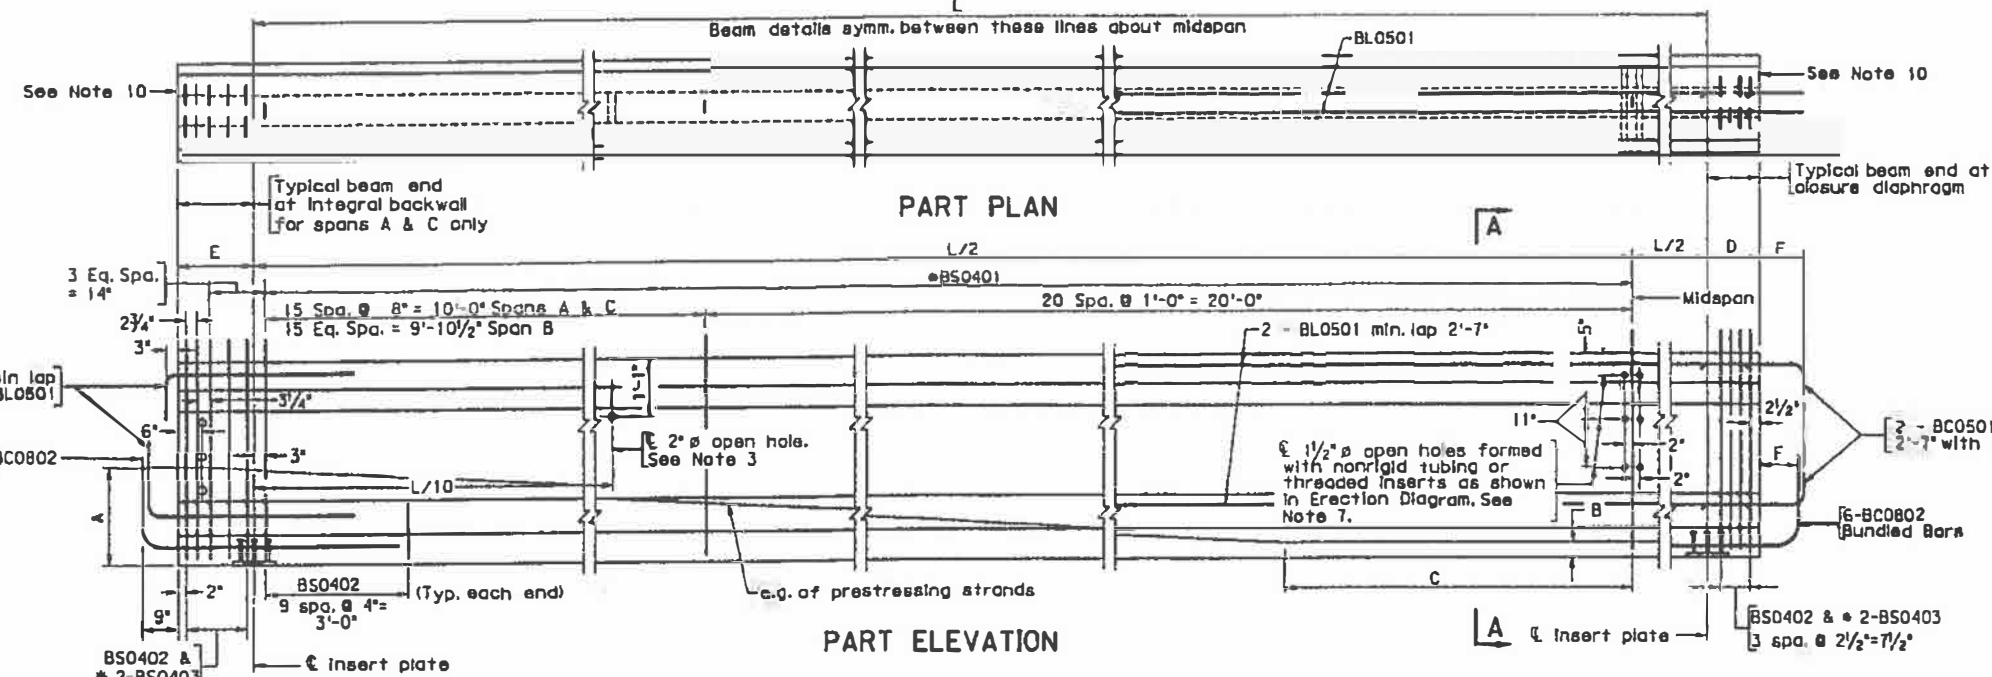

- Notes:
- 1) At end diaphragm use 1" deep recesses around local groups with 2" minimum edge clearance and fill with applied mortar immediately after clipping strands. An epoxy mortar covering the ends of strands with a minimum thickness of 1/8" may be used as an alternate. Strands should be clipped before mortar is applied. After mortar is allowed to cure entire end of beam shall be covered with epoxy type.
 - 2) For reinforcing steel, prestressing strands and dimensions shown in the exterior beam, see interior beam.
 - 3) Beams shall have 2" ø open holes formed with nonrigid or threaded inserts as shown in Erection Diagram. See Note 7.
 - 4) Threaded insert, when embedded shall develop full strength of 1/2" threaded bolt (ASTM A307).
 - 5) All prestressing strands shall be low-relaxation, grade 2 uncoated.
 - 6) For details of insert plate, see sheet 11.
 - 7) For location of closure and intermediate diaphragms, see Diagram on sheet 8.
 - 8) The Contractor, after a written approval from the Engineer, may use different prestressing strand arrangement provided the total prestressing force and its c.g. are the same on the plans.
 - 9) 2 - 1/2" ø strands stressed to 1000 lbs. may be substituted for 2 - 5 bars.
 - 10) At closure diaphragm and integral backwall, end strands shall be clipped 1" from beam after clipping. End of beam shall be reinforced in accordance with Section 405.05 of the Road and Bridge Specifications.
 - 11) Top of beam to be roughened to a full amplitude of 1/2" for deck slab concrete.
 - 12) All reinforcing bar dimensions except for bending diagram centers of bars.
 - 13) 3/4" ø inserts for telephone conduit supports not shown on sheet 13 for details.

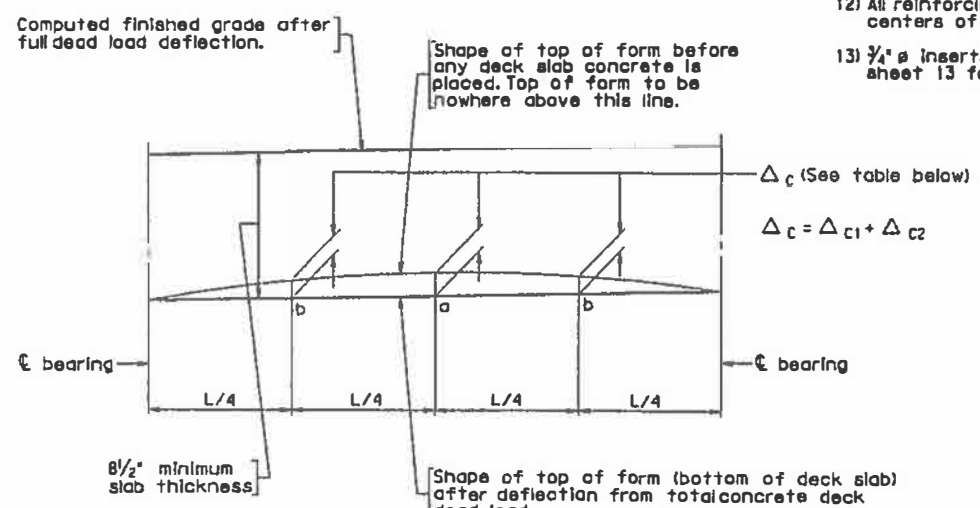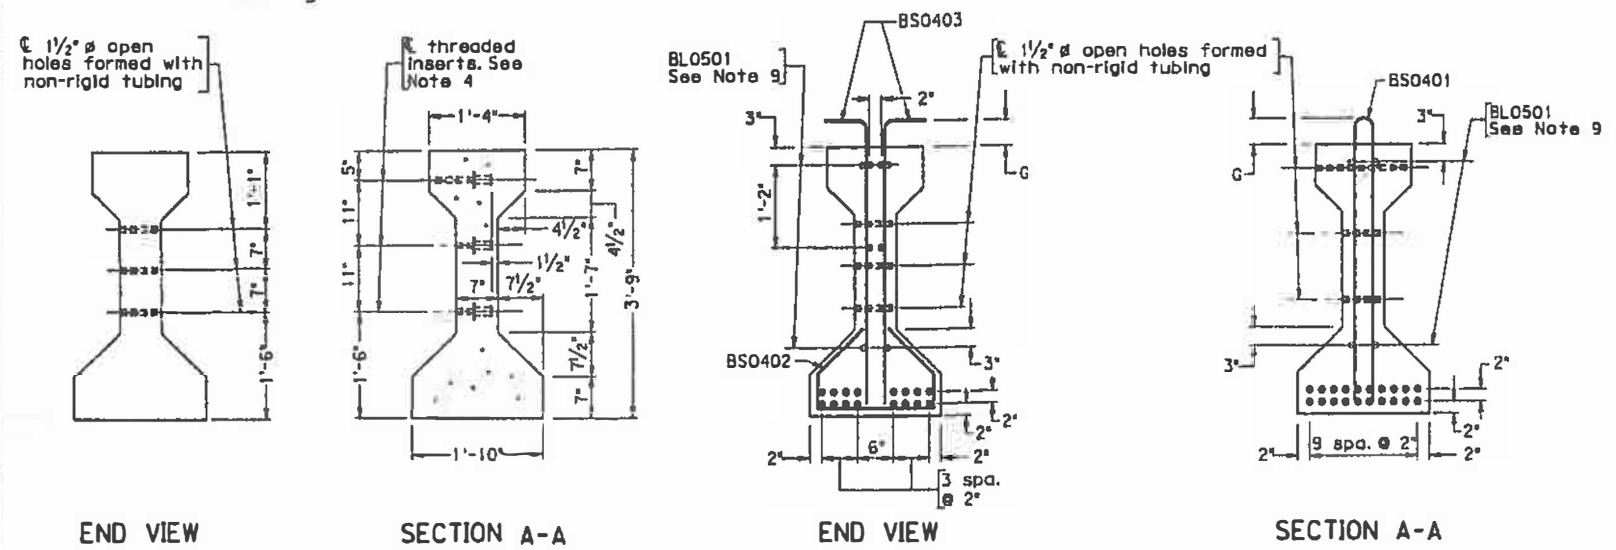

Mark	No.	Size	Len
BS0401	1704	#4	8'
BS0402	688	#4	4'
BS0403	416	#4	4'
BL0501	192	#5	32'
BC0501	192	#5	4'
BC0802	288	#8	8'

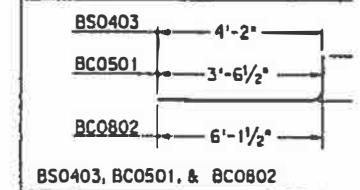

BS0403, BC0501, & BC0802



BS0401: 3 1/2"

BS0402: 8"

Dimensions in Bending Diagrams of bars.

Reinforcing bars shown on the are for beams shown on this sheet. BS0401 or BS0403 may be slightly directed by the Engineer to close inserts.

Reinforcing bars BS0401 and BS0402 are galvanized. All other reinforcing epoxy coated except all BC series non-epoxy coated.

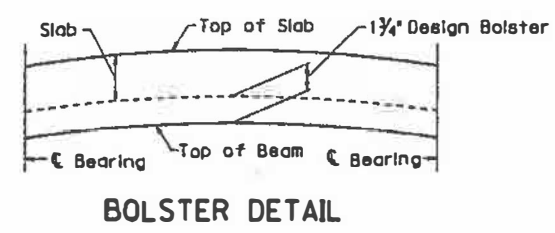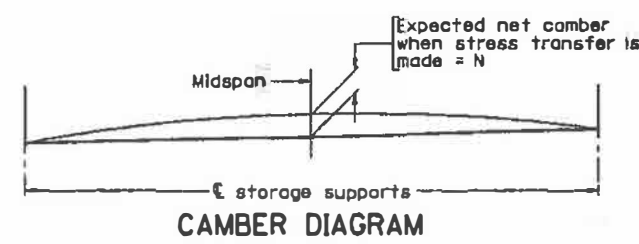

Beams	ANTICIPATED DEAD LOAD DEFLECTION**				
	At a		At b		
	Δ c1	Δ c2	Δ c1	Δ c2	
Spans A & C	Beams 2 thru 7	3/16"	1/16"	3/16"	1/16"
	Beams 1 & 8	3/16"	1/16"	3/16"	1/16"
Span B	Beams 2 thru 7	3/16"	0	3/16"	0
	Beams 1 & 8	3/16"	0	3/16"	0

DIMENSION TABLE											
Beam	Prestr. force per strand lb.	No. and size of strands/beam	Net camber N in.	A ft.-in.	B in.	C ft.-in.	D in.	E in.	F in.	G in.	L ft.-in.
Spans A & C	30,980	20 - 1/2" ø	7/8"	9 3/8"	3"	6'-3"	9 1/2"	19"	8 3/8"	6 1/4"	60'-6"
Span B	30,980	20 - 1/2" ø	7/8"	9 3/8"	3"	6'-2"	9 1/2"	—	8 3/8"	6 1/4"	60'-3"


DEAD LOAD DEFLECTION DIAGRAM

** Deflection shown are actual deflections without multipliers.



Not to Scale

PRESTRESSED CONCRETE TYPE III				
No.	Description	Date	Designed:	Date
			Drawn:	
			Checked:	
Revisions			Plan No.	




FHWA REGION	STATE	ROUTE	FEDERAL AID PROJECT ROUTE	STATE	PROJECT
-------------	-------	-------	---------------------------	-------	---------

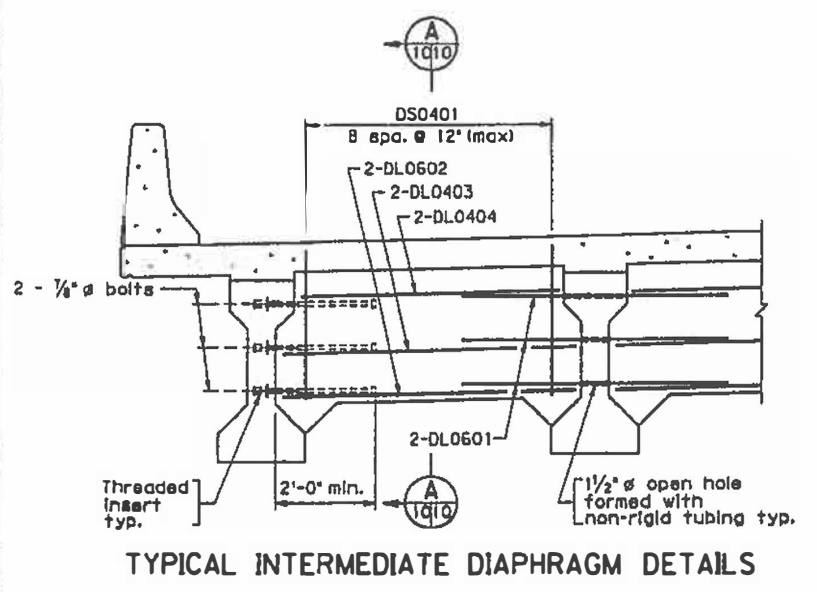




TYPICAL INTERMEDIATE DIAPHRAGM DETAILS

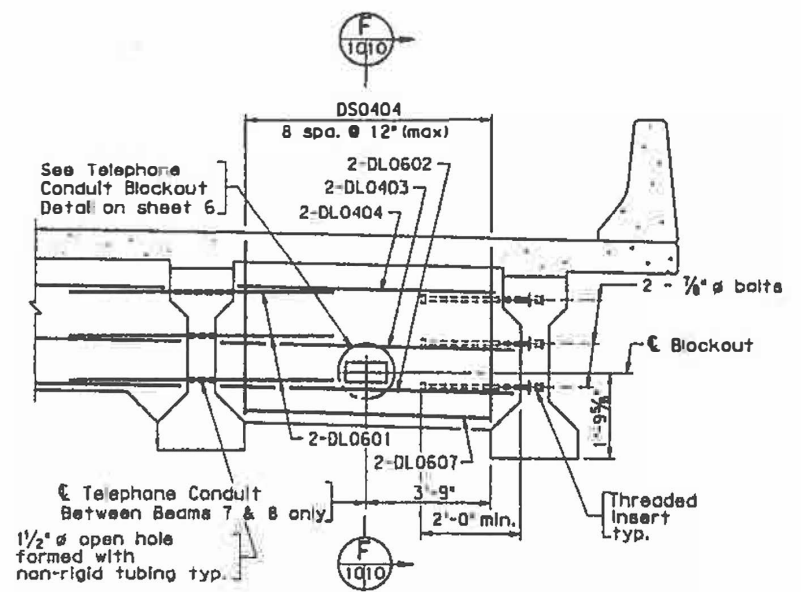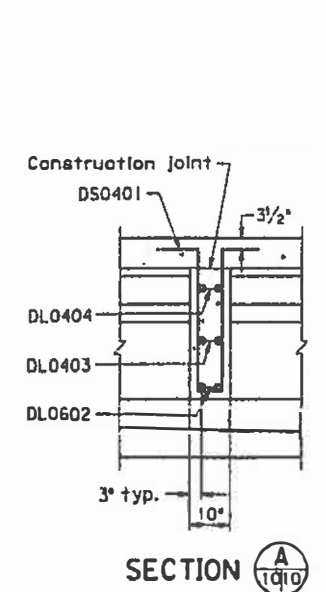


INTERMEDIATE DIAPHRAGM DETAILS
Typ. Between Beams 7 & 8 only

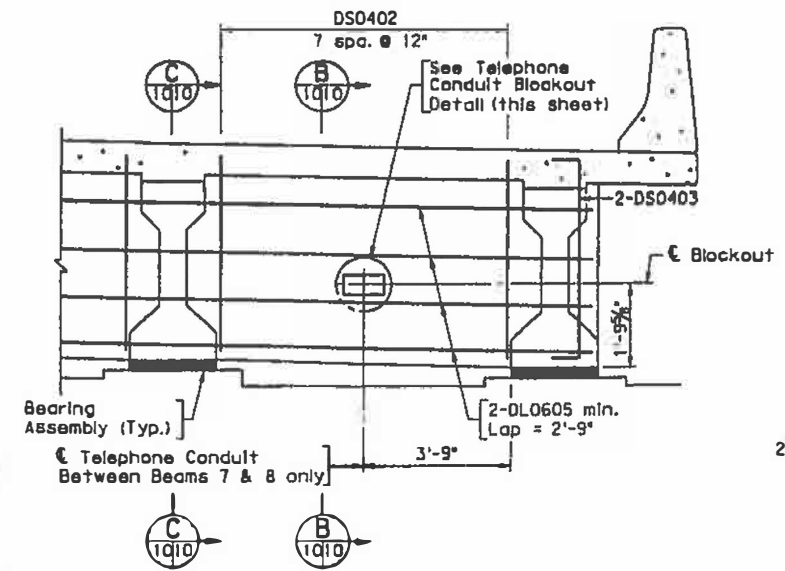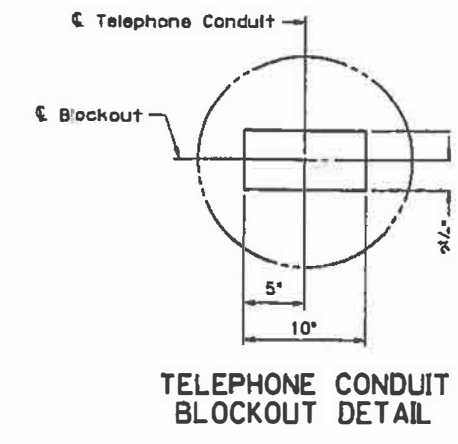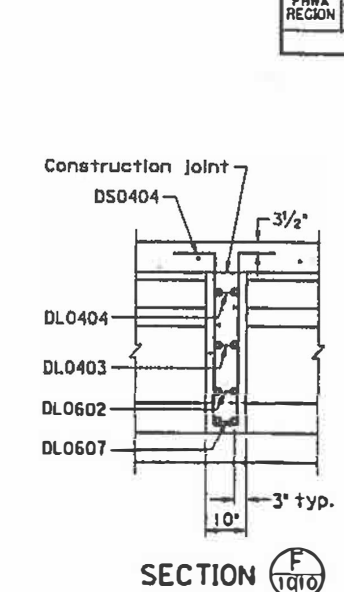



CLOSURE DIAPHRAGM, EXPANSION PIER

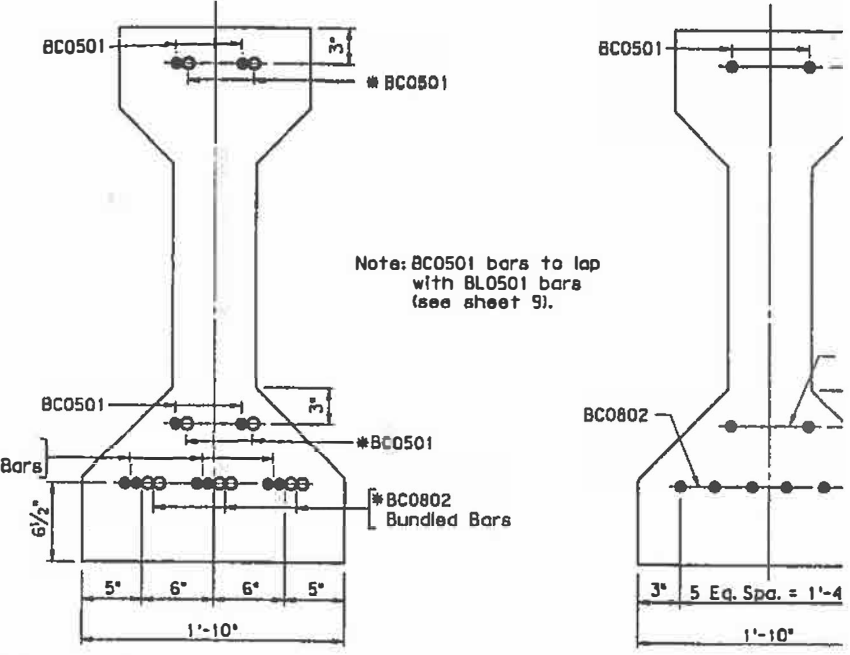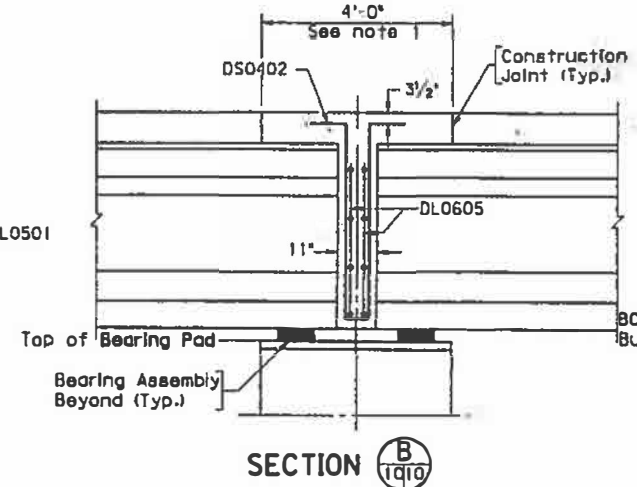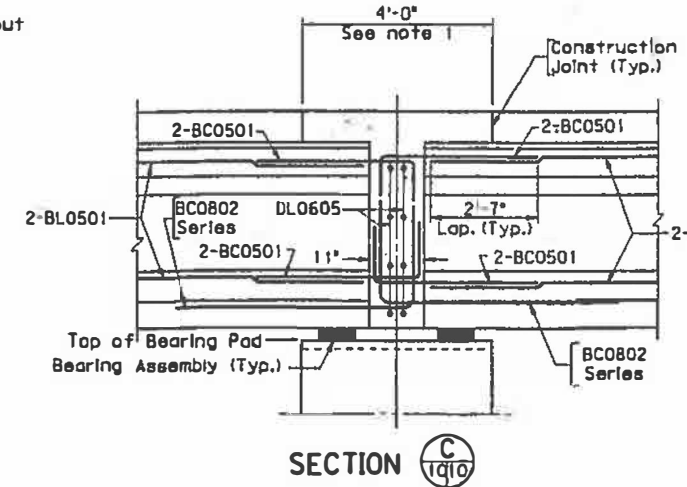

BEAM END AT CLOSURE DIAPHRAGMS

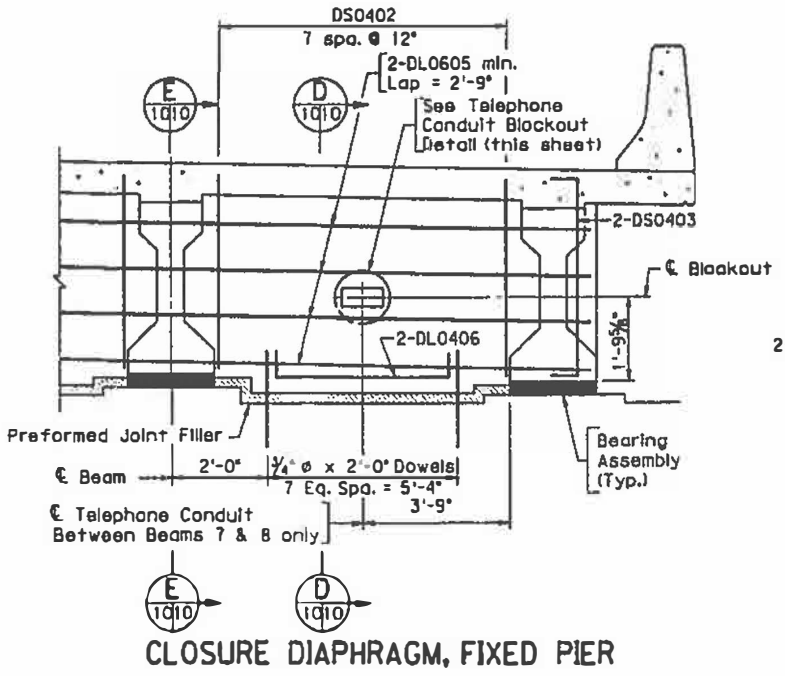

CLOSURE DIAPHRAGM, FIXED PIER

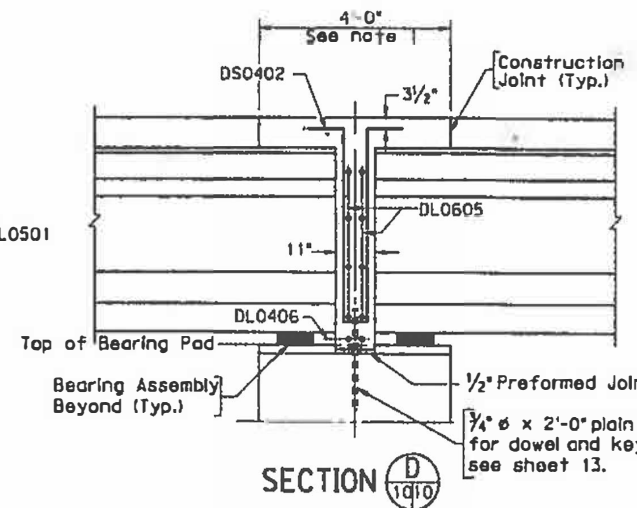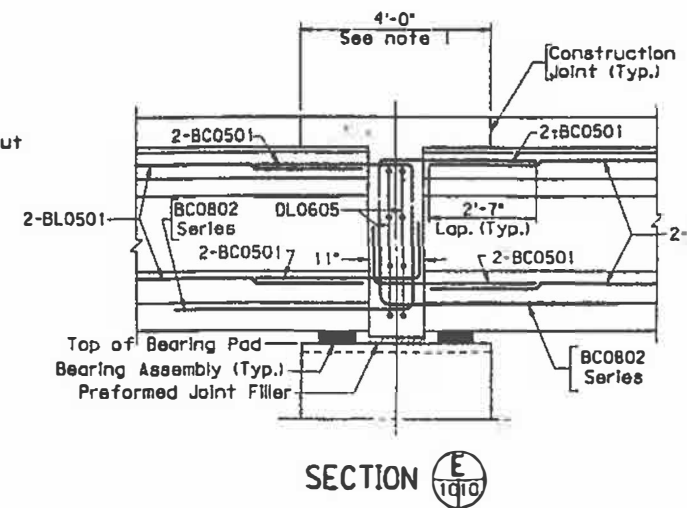


- Notes:
1. This portion of the slab shall be cast with the closure d
 2. For details of bearing pads and bearing pad assemblies see
 3. Reinforcing steel in diaphragms shall be adjusted to clear conduit blockout.

INTERMEDIATE AND CLOSURE DIAPHRAGM DETAILS					
No.	Description	Date	Designed:	Date	Plan No.

Not to Scale (unless otherwise noted)

REGION	ROUTE	PROJECT	ROUTE	PROJECT
--------	-------	---------	-------	---------

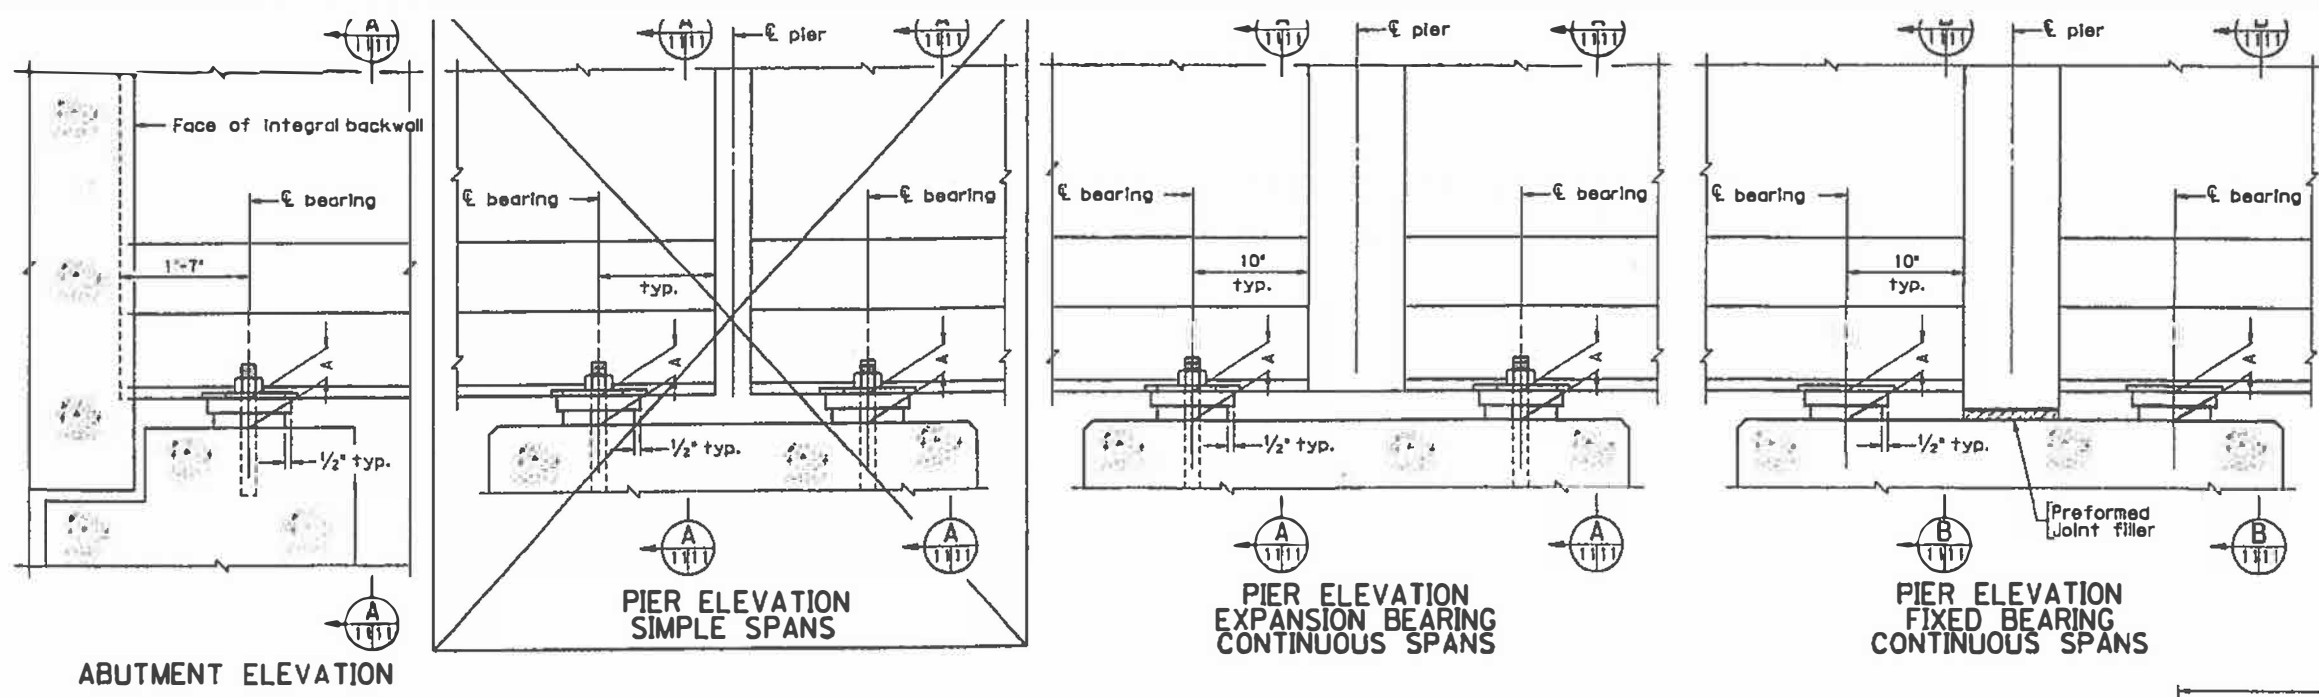

Notes:

Material: Elastomer - 50 durometer hardness.
Shim - ASTM A36 or A570 mild steel.

Elastomeric bearings shall be molded as a single unit.
Bevel sole plates to grade. Minimum 3/4" thickness.





Insert plate shall provide uniform bearing over its entire area. Insert plate is 1" wider than sole plate.

In welding insert plate to sole plate, ample time shall be between weld passes to prevent heat damage to the sole plate and elastomeric pad. Elastomer shall not be exposed to temperatures higher than 400° F.


For closure diaphragm details, see sheet 10.

For designation of fixed or expansion bearings, see elev on front sheet.


ABUTMENT ELEVATION

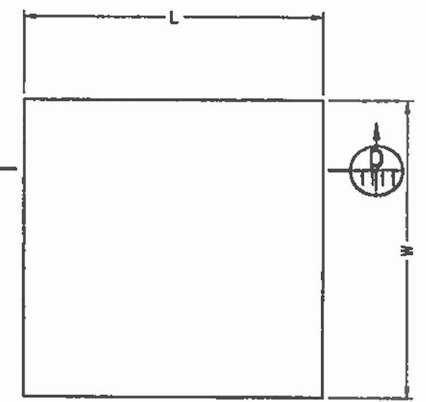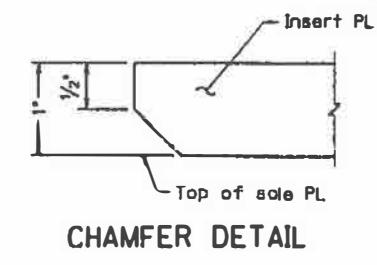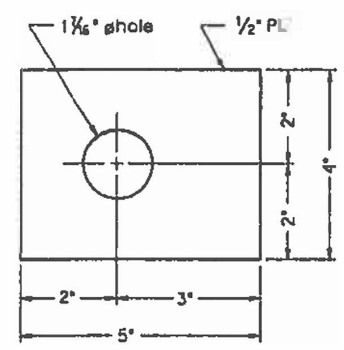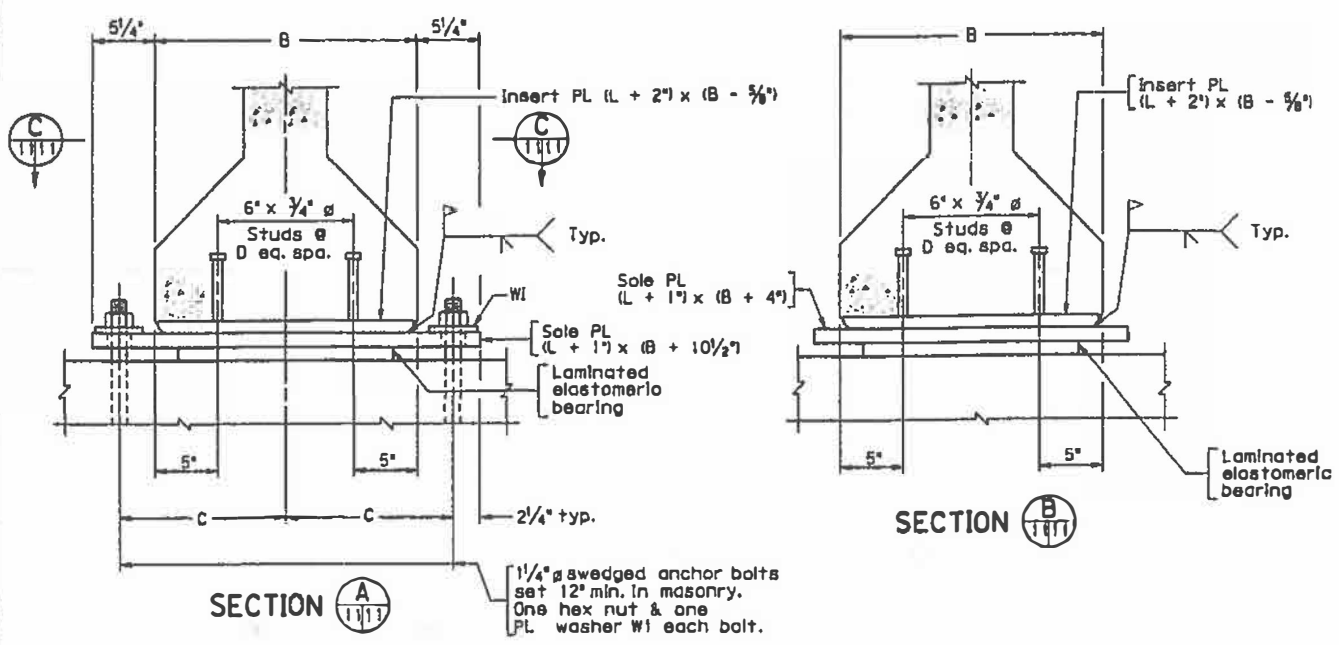

Beam Type	B	C	D
II	1'-6"	1'-0"	1
III	1'-10"	1'-2"	1
IV	2'-2"	1'-4"	2
V	2'-4"	1'-5"	3
VI	2'-4"	1'-5"	3

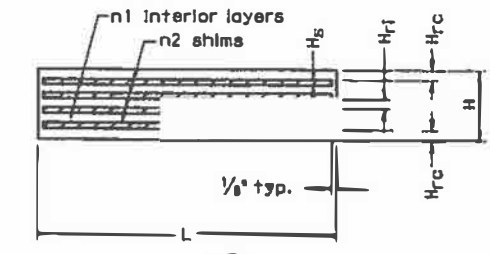

LAMINATED ELASTOMERIC BEARING

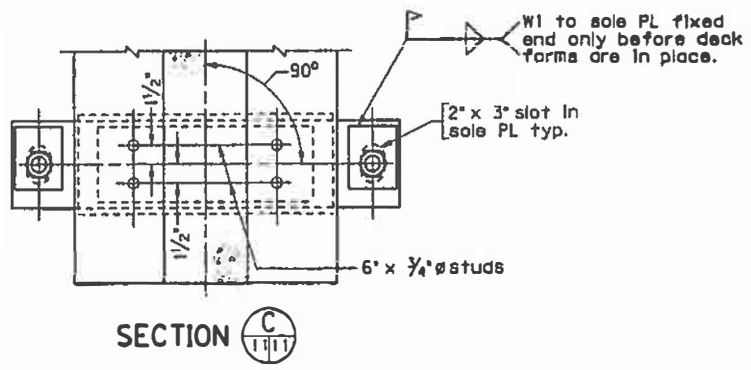


Span	Abut.	Pier	Beam Type	A	Laminated Elastomeric Bearing						Grade %
					W	L	H	H _{RC}	n1 @ H _{R1}	n2 @ H _{R2}	
A	A	—	III	2 3/8"	16	11	1 3/8"	0.2500	2 @ 0.3519	3 @ 0.1196	1.6
A	—	1	III	2 3/8"	16	11	1 3/8"	0.2500	2 @ 0.3519	3 @ 0.1196	1.0
B	—	1	III	2 3/8"	16	11	1 3/8"	0.2500	2 @ 0.3519	3 @ 0.1196	1.0
B	—	2	III	2 7/8"	17	10	2 1/8"	0.2500	3 @ 0.3614	4 @ 0.1196	0.5
C	—	2	III	2 7/8"	17	10	2 1/8"	0.2500	3 @ 0.3614	4 @ 0.1196	0.5
C	B	—	III	3 1/8"	17	11	2 3/8"	0.2693	4 @ 0.3877	5 @ 0.1196	0

All dimensions in table are in inches.


PRESTRESSED CONCRETE BEARING DETAIL				
No.	Description	Date	Designed:	Date
			Drawn:	
			Checked:	
				Plan No.

BBD-8 MOD 7-15-96


*Open deflection joint
1'-3" deep

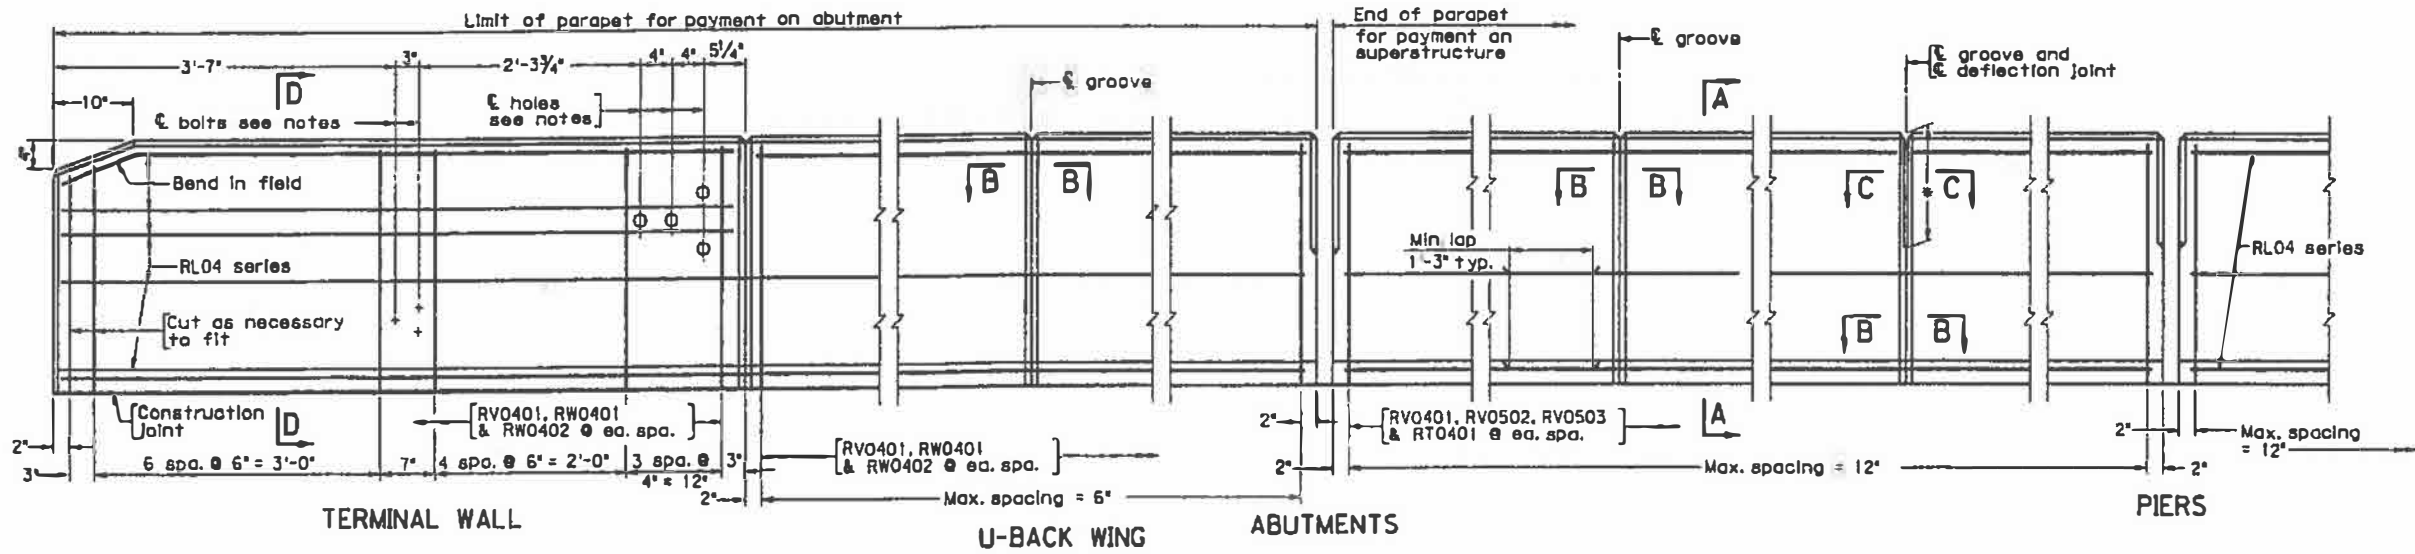


ELEVATION
Scale: 1" = 1'-0"

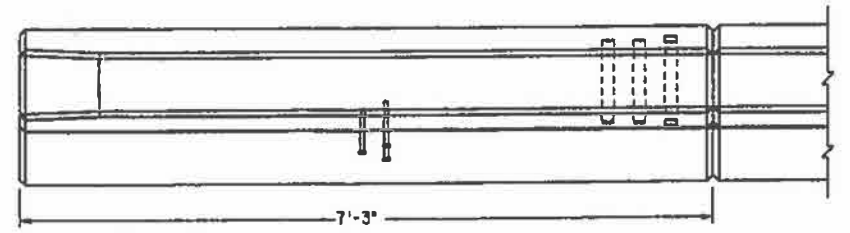

PART PLAN
Scale: 1" = 1'-0"

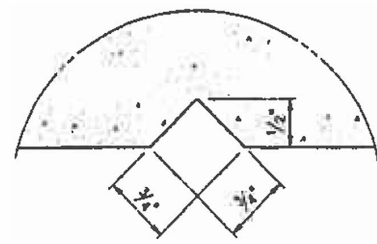

SECTION B-B
Full Scale
Groove detail for both sides of parapet

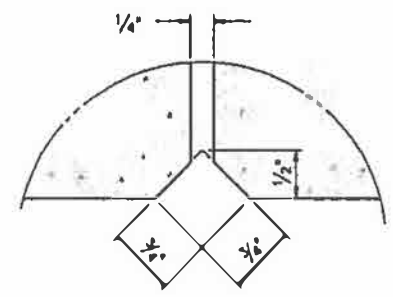


SECTION C-C
Full Scale
Deflection joint detail for both sides of parapet

REINFORCING STEEL SCHEDULE				
RV0401	RV0502	RV0503	RW0401	RW0402


Dimensions in bending diagram are out to out of bars, except as shown.

Mark	No.	Size	Length	Pin Ø	Lacc
RT0401		#4	3'-0"		Slab
RV0401		#4	5'-2"	4 1/2"	Parapet
RV0502		#5	3'-10"	3 3/4"	Parapet
RV0503		#5	2'-4"	3 3/4"	Parapet
RW0401		#4	2'-0"	3"	Terminal W
RW0402		#4	2'-5"	3"	Terminal W
RL04		#4			Parapet


Cost of all bars listed in schedule to be included in price bid

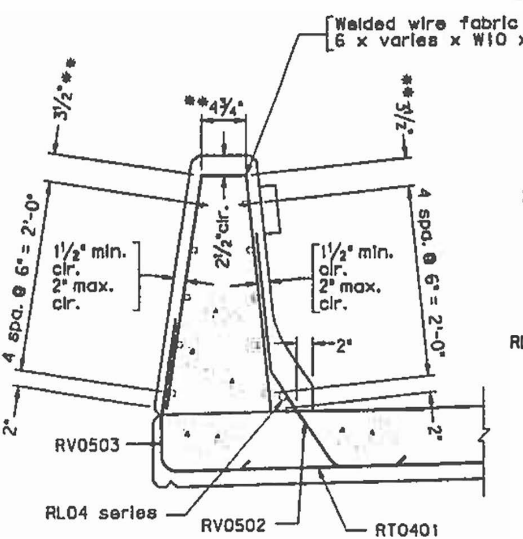


SECTION A-A
ALTERNATE REINFORCING STEEL
Scale 1" = 1'-0"

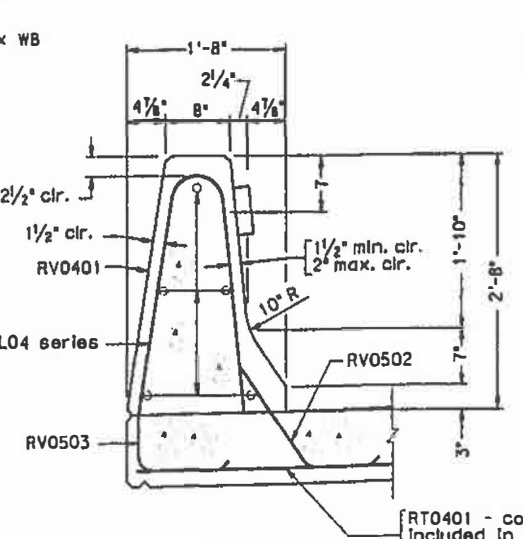


SECTION A-A
Scale: 1" = 1'-0"
Gross concrete quantities (C.Y.) = Lln. ft. x 0.105
All concrete above roadway slab

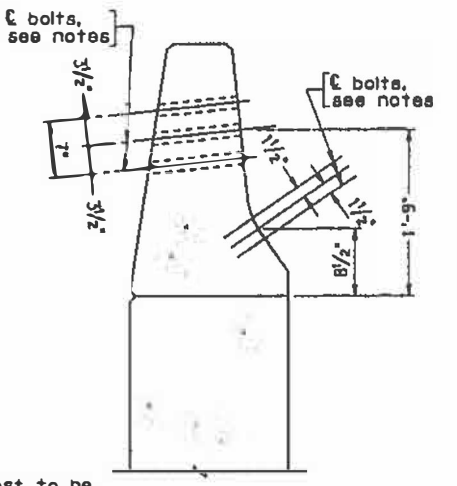

SECTION D-D
Scale: 1" = 1'-0"
Reinforcing steel not shown

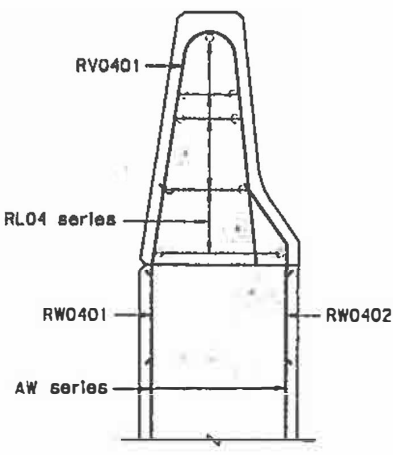

SECTION D-D
Scale: 1" = 1'-0"
Holes and bolts not shown. For details not shown, see Section A-A.

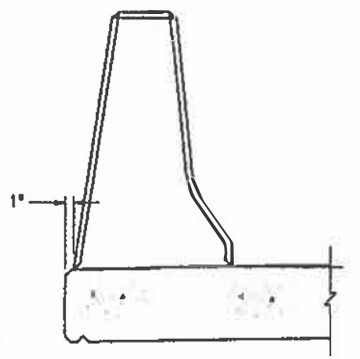

SECTION THRU JOINTS FOR EXTRUSION ONLY
Scale: 1" = 1'-0"

NOTES:

- Rounded edges with 1" radius may be used in lieu of be top of parapet.
- Reinforcing bars RV0502 and RV0503 shall be galvanized. A reinforcing bars shall be epoxy coated.
- Detail shown at pier is applicable when joint is in slab. If is continuous over pier, use groove and deflection joint.
- Spacing of grooves to be approximately 8'-0". If lighting is used (see Bridge Conduit System), groove shall be loca proximately 4'-0" from light standard. Spacing of def joints shall not exceed three groove spaces.
- Barrier delineator size, color, and spacing to be in accord with the Specifications. Cost of delineator to be includ price bid for parapet. Reflective surface of barrier delir all instances, to be facing oncoming traffic.
- The Contractor shall determine all dimensions and details sary for installation.
- All concrete shall be Class A4.
- For details of wingwall below construction joint, see abur sheet(s).
- Terminal walls are detailed to take guardrail attachment
- Holes, where shown, shall be formed with sleeves of 1 1/2" c nal pipe.
- Bolts, where shown, shall be 3/8" dia. expansion anchor bolts to be drilled and installed when rub rolls attached.
- For extruded parapets: During extrusion, open joints at and piers shall be formed by the use of lubricated plat other means so that uniformity of the opening and ch maintained. Dimension of 1" (as shown in Section thru Jol Extrusion Only) is additional deck slab that shall be cost tractor's expense. Dimension(s) to face of curb shall not duced.

2-01-99
CADD
BPB-3A

No.	Description	Date	Designed	Date	Plan No.
Revisions			Drawn:		
			Checked:		

CAST-IN-PLACE CONCRETE PARAPET (F

- ① 4" F.R.E. duct
- ② 4" galv. steel duct
- ③ 4" PVC-B duct
- ④ PVC-galv. adaptor
- ⑤ Galv.-F.R.E. adaptor
- ⑥ F.R.E. exp. joint
- ⑦ F.R.E. look ring

***Limit of telephone conduit in bridge contract when approach slabs or drainage aprons are not used shall be the extension of the conduit a minimum of one foot behind back of backwall.

REGION	ROUTE	PROJECT	ROUTE	PROJECT

NOTES:

Glass fiber reinforced epoxy (FRE) duct shall comply with D2310 and ASTM D2996, and shall be RTRP-2AD-III, except filed herein.

Inside diameter shall be 4.00" minimum, wall thickness shall minimum.

Duct performance shall not be impaired by exposure to radiation. Duct shall have fire resistance which equals requirements of U.L. 651 - Section 17.

Joints shall be positive locking, (threaded bell and spigot, sive bonded bell and spigot, or driven tapered bell spigot)

Expansion joints shall be sliding sleeve type, with or without rings, with provision for minimum of 6" expansion travel.

Lock rings shall be split FRE duct, minimum of 3' long, .010" minimum thickness, glued in place after installation of conduit.

Threaded couplings shall be used on steel conduit.


Steel fittings and rods shall be galvanized in accordance with ASTM A153.

Support angles shall be galvanized in accordance with ASTM A153.

Hanger details shown are designed to support as many ducts. Dead loads used were as follows: Cables = 8.5 lbs./ft. conduit, Conduit = 0.8 lbs./ft.


Underground installation of PVC-B duct shall be in accordance with Road and Bridge Standards ECI-1 except the minimum spacing between ducts shall be 1/4".

Contractor shall space supports for the telephone conduit such that the 3/4" inserts for the H.S. bolts will not interfere with the draped strands in the prestressed concrete.

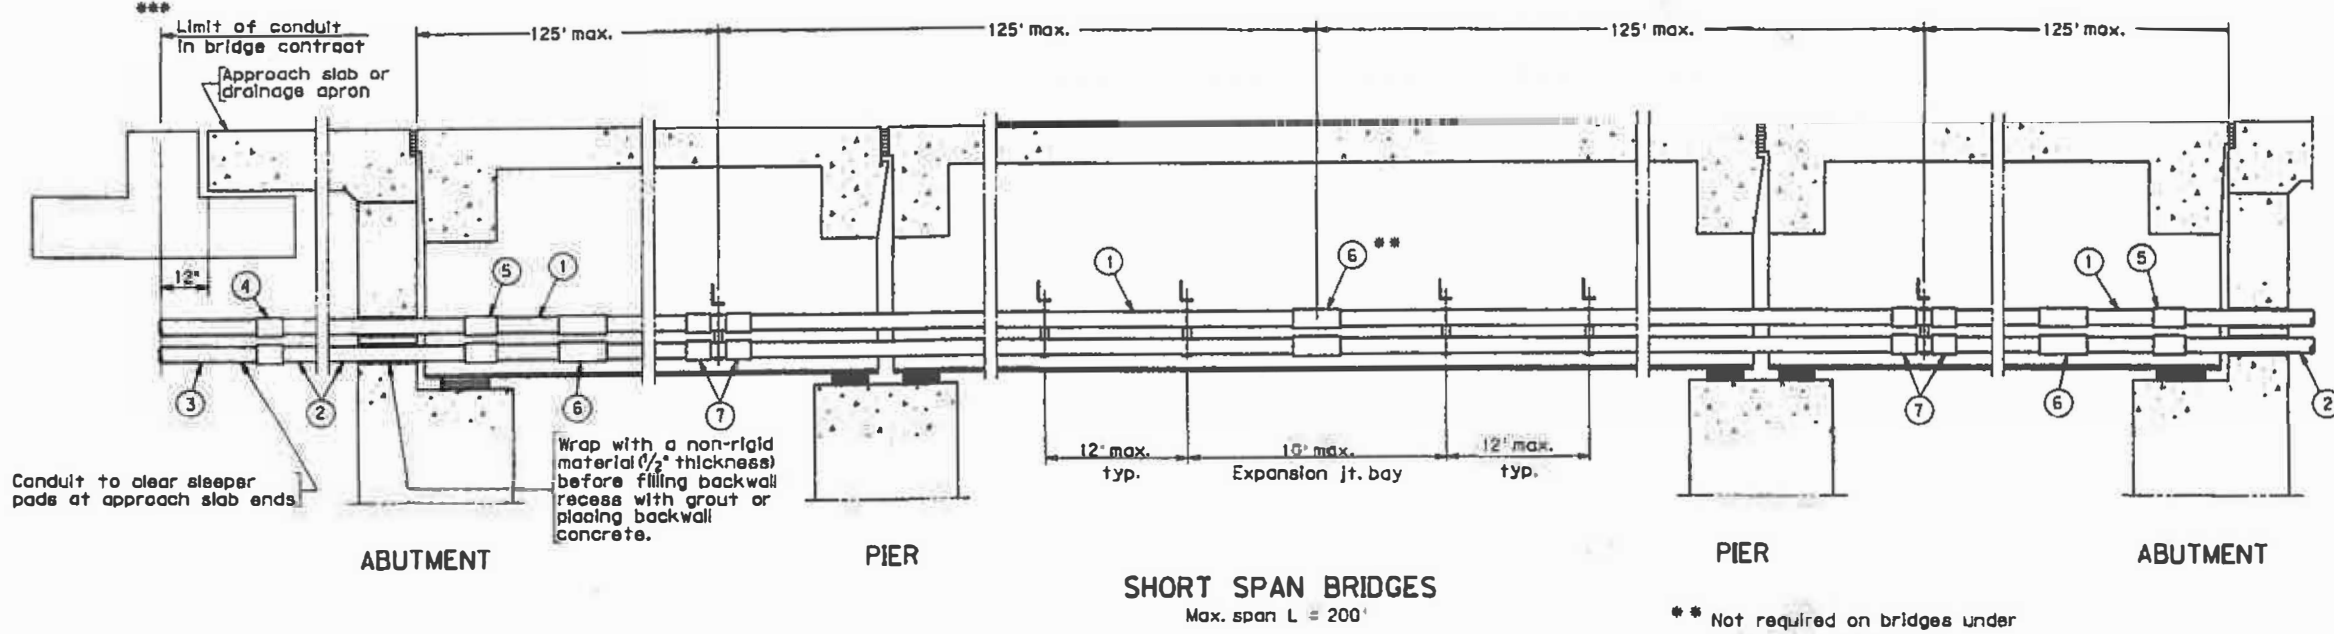


SHORT SPAN BRIDGES
Max. span L = 200'

** Not required on bridges under 250' total length.

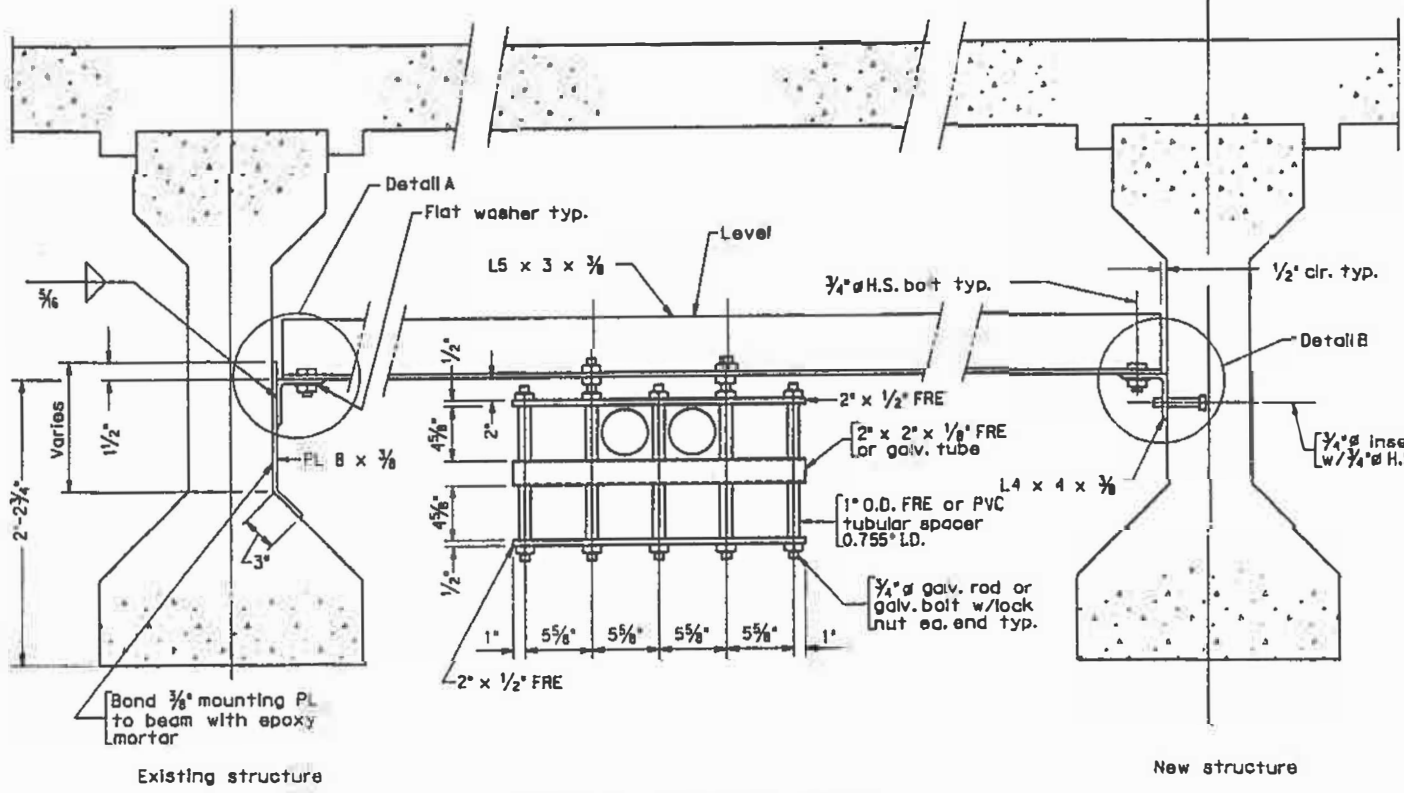


TYPICAL SUPPORT DETAIL

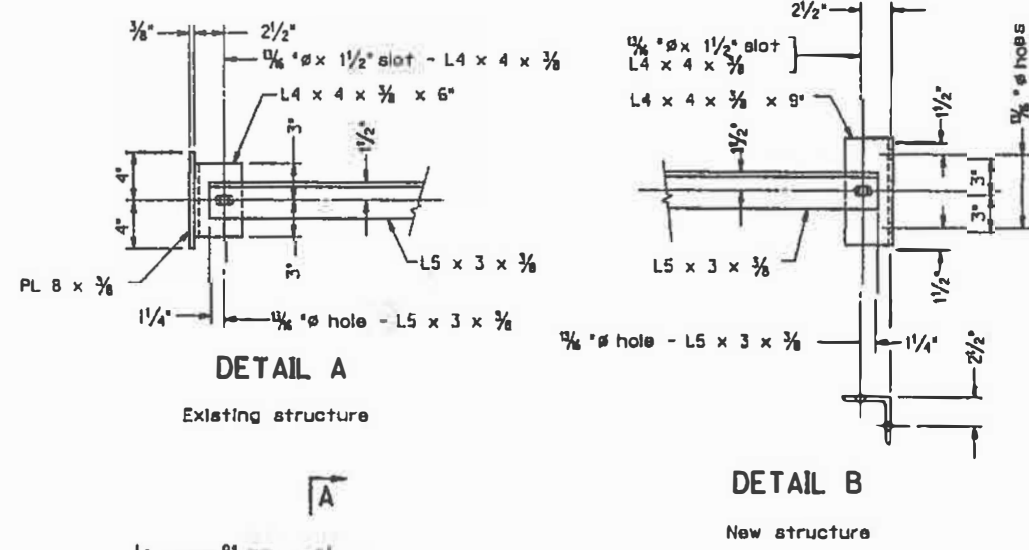


DETAIL A
Existing structure

DETAIL B
New structure

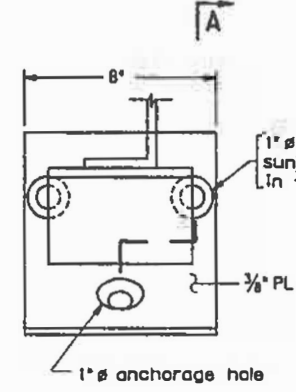


ELEVATION

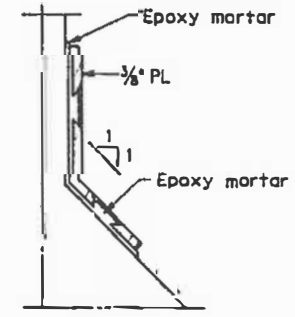

SECTION A-A

CONDUIT FORMATIONS

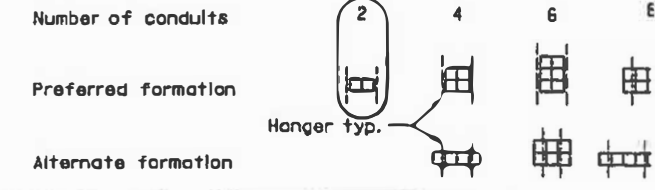


TELEPHONE CONDUIT

No.	Description	Date	Designed:	Date	Plan No.


CADD BTC-7 MOD. 7-1-93

Notes:


1. When finishing concrete between and beyond pier surface to drain from pier to edge of oap.
2. Piles to be driven to depths in accordance with Specifications 403.06 (e).
3. For spooling of dowel bars, see sheet 10.
4. The cost for dowel bars shall be included in the for substructure concrete.

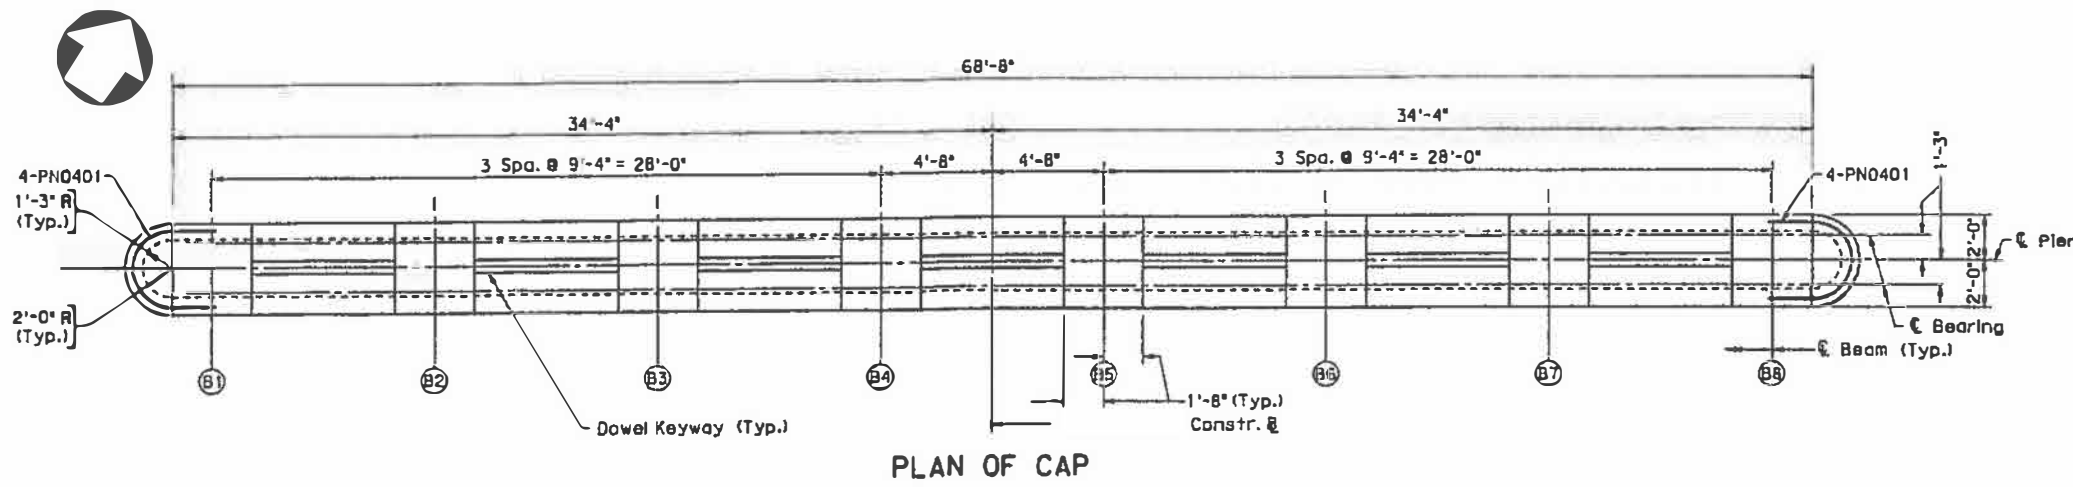


PLAN OF CAP

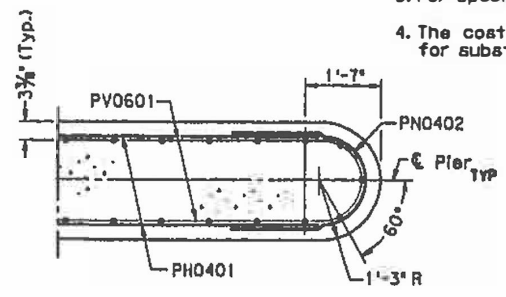


SECTION B
Scale: 1/2" = 1'-0"

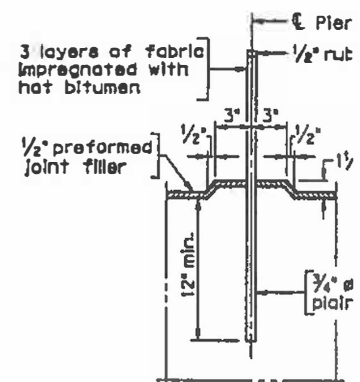


DOWEL DETAIL
Pier 1 Only - Typ. between
Scale: 1/2" = 1'-0"

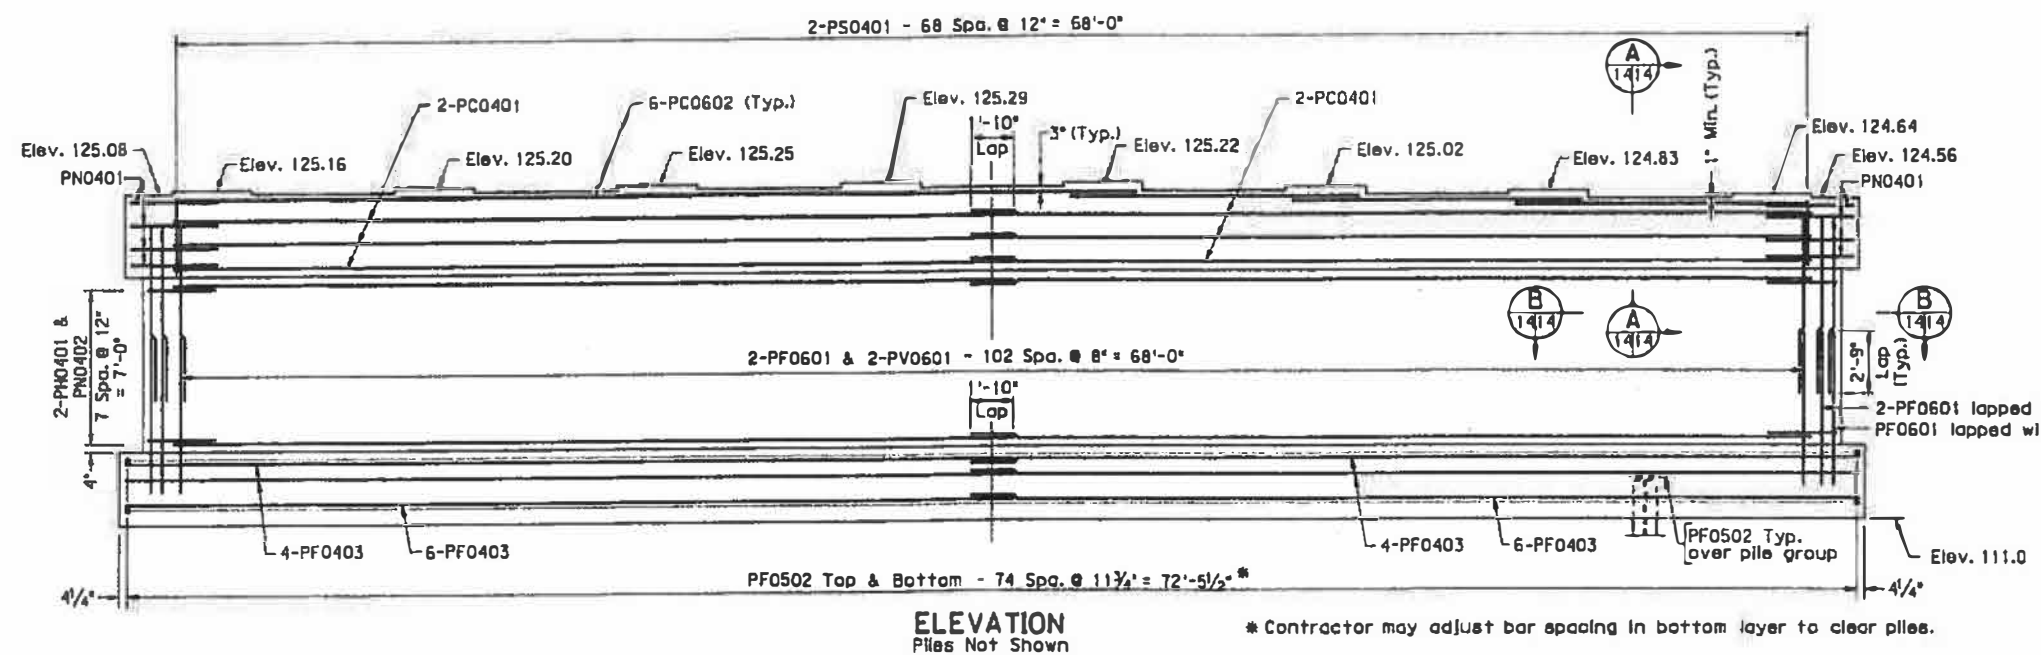


ELEVATION
Piles Not Shown

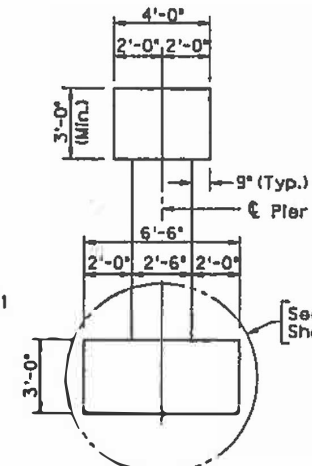

END VIEW
Piles Not Shown

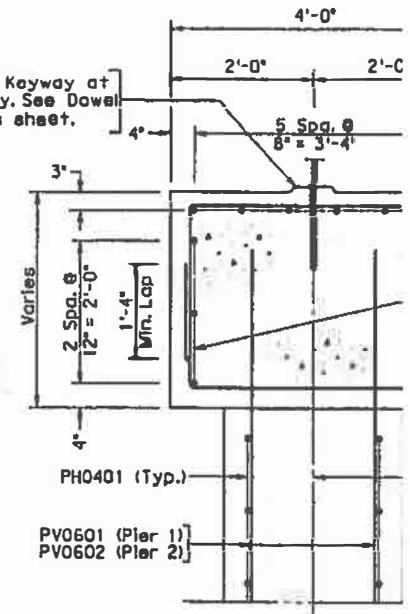

SECTION A
Scale: 3/4" = 1'-0"

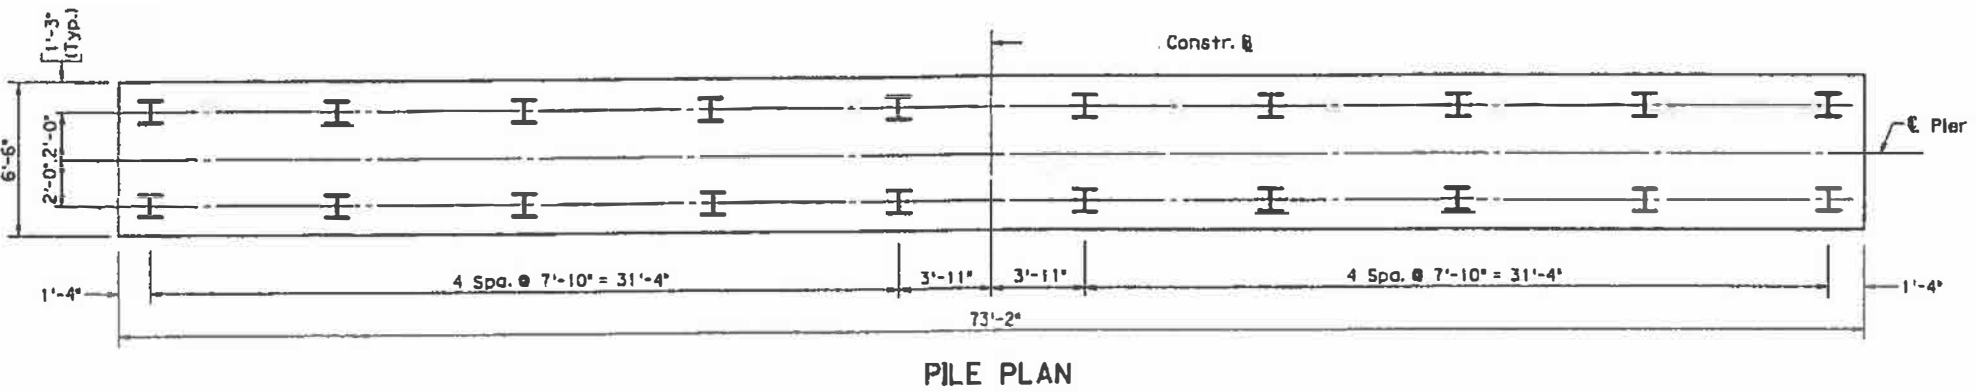


PILE PLAN


Scale: 1/4" = 1'-0" unless otherwise noted

				PIER 1	
No.	Description	Date	Designed:	Date	Plan No.
			Drawn:		
			Checked:		
Revisions					


- Notes:
1. When finishing concrete between and beyond pier surface to drain from pier to edge of cap.
 2. Piles to be driven to depths in accordance with Specifications 403.06 (e).

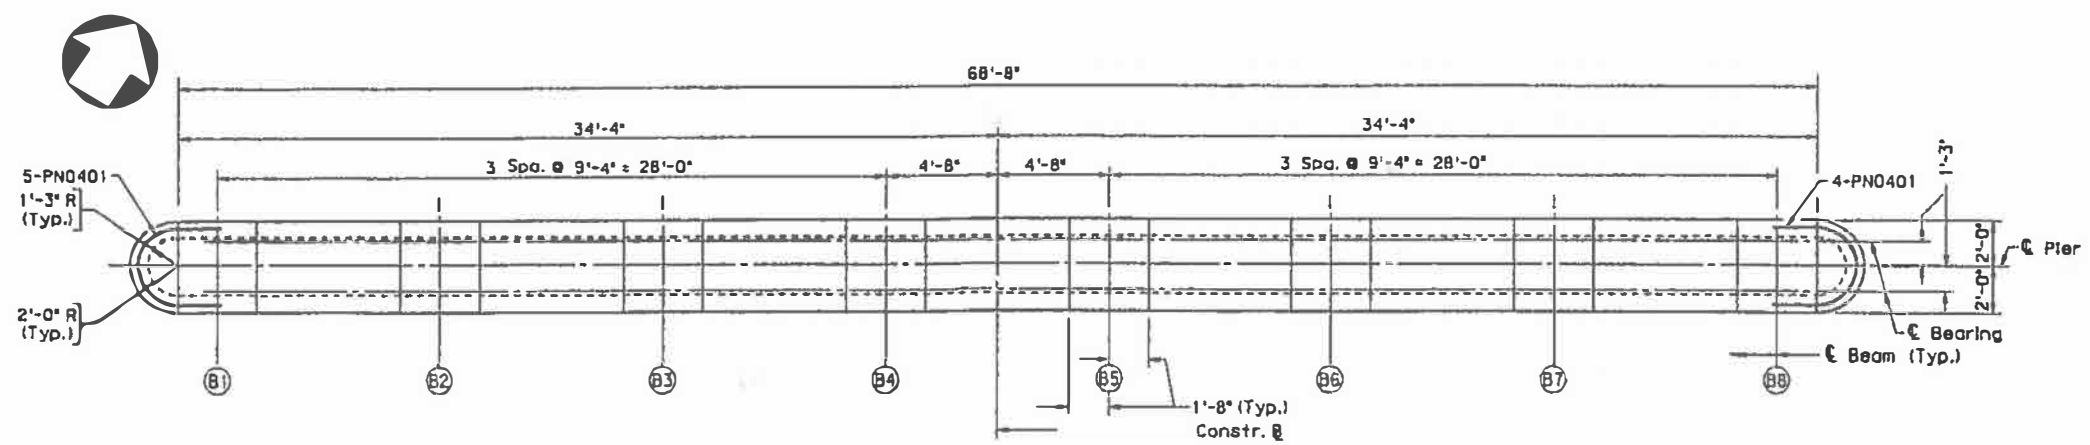


PLAN OF CAP

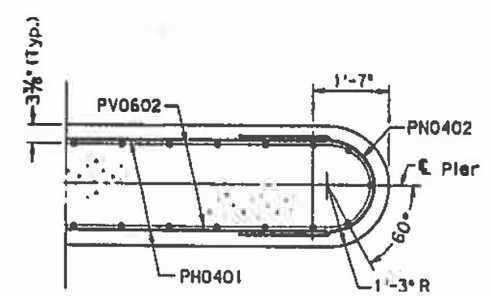


SECTION B (15/15)
Scale: 1/2" = 1'-0"

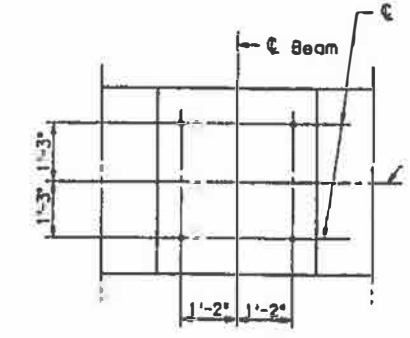



TYPICAL ANCHOR BOLT LA
Scale: 1/2" = 1'-0"

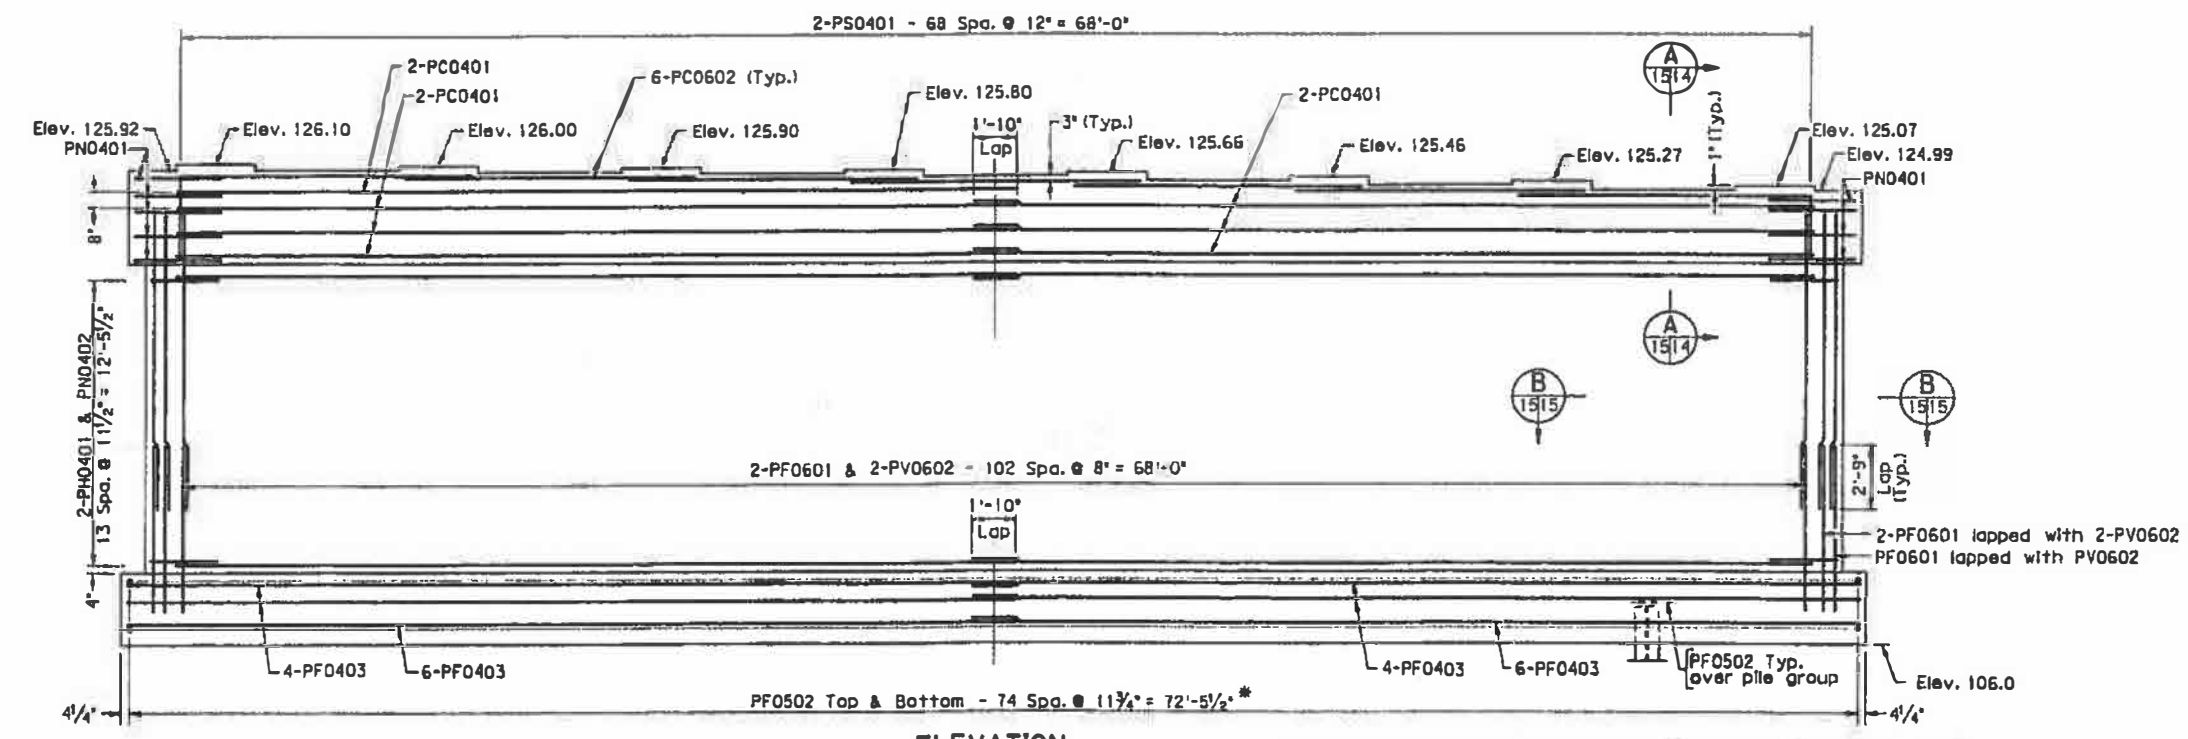

ELEVATION
Piles Not Shown

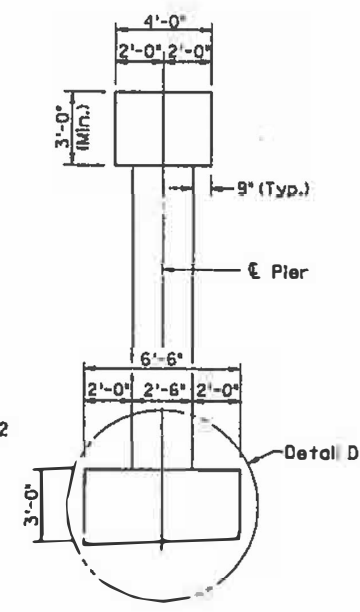



END VIEW
Piles Not Shown

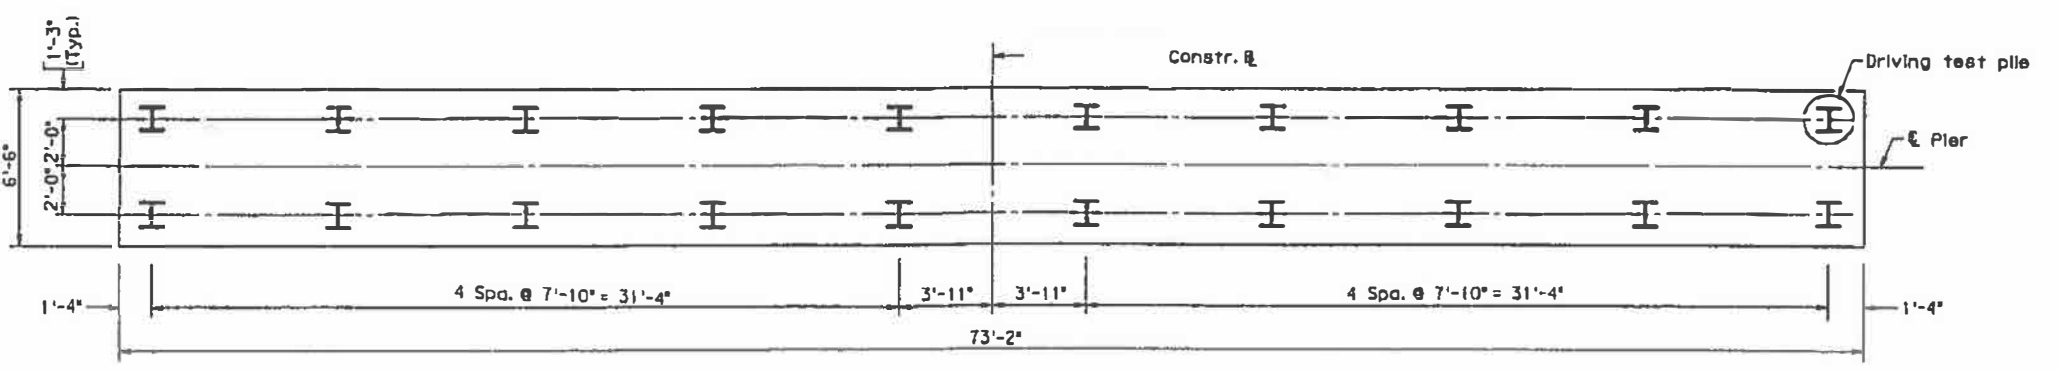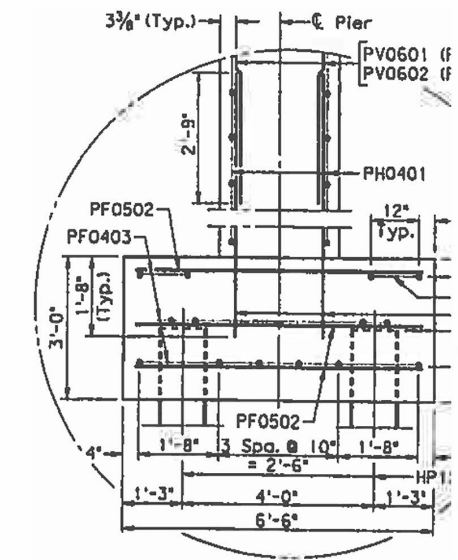

PILE PLAN

Scale: 1/4" = 1'-0" unless otherwise noted


PIER 2				
No.	Description	Date	Designed:	Date
			Drawn:	
			Checked:	
Revisions				

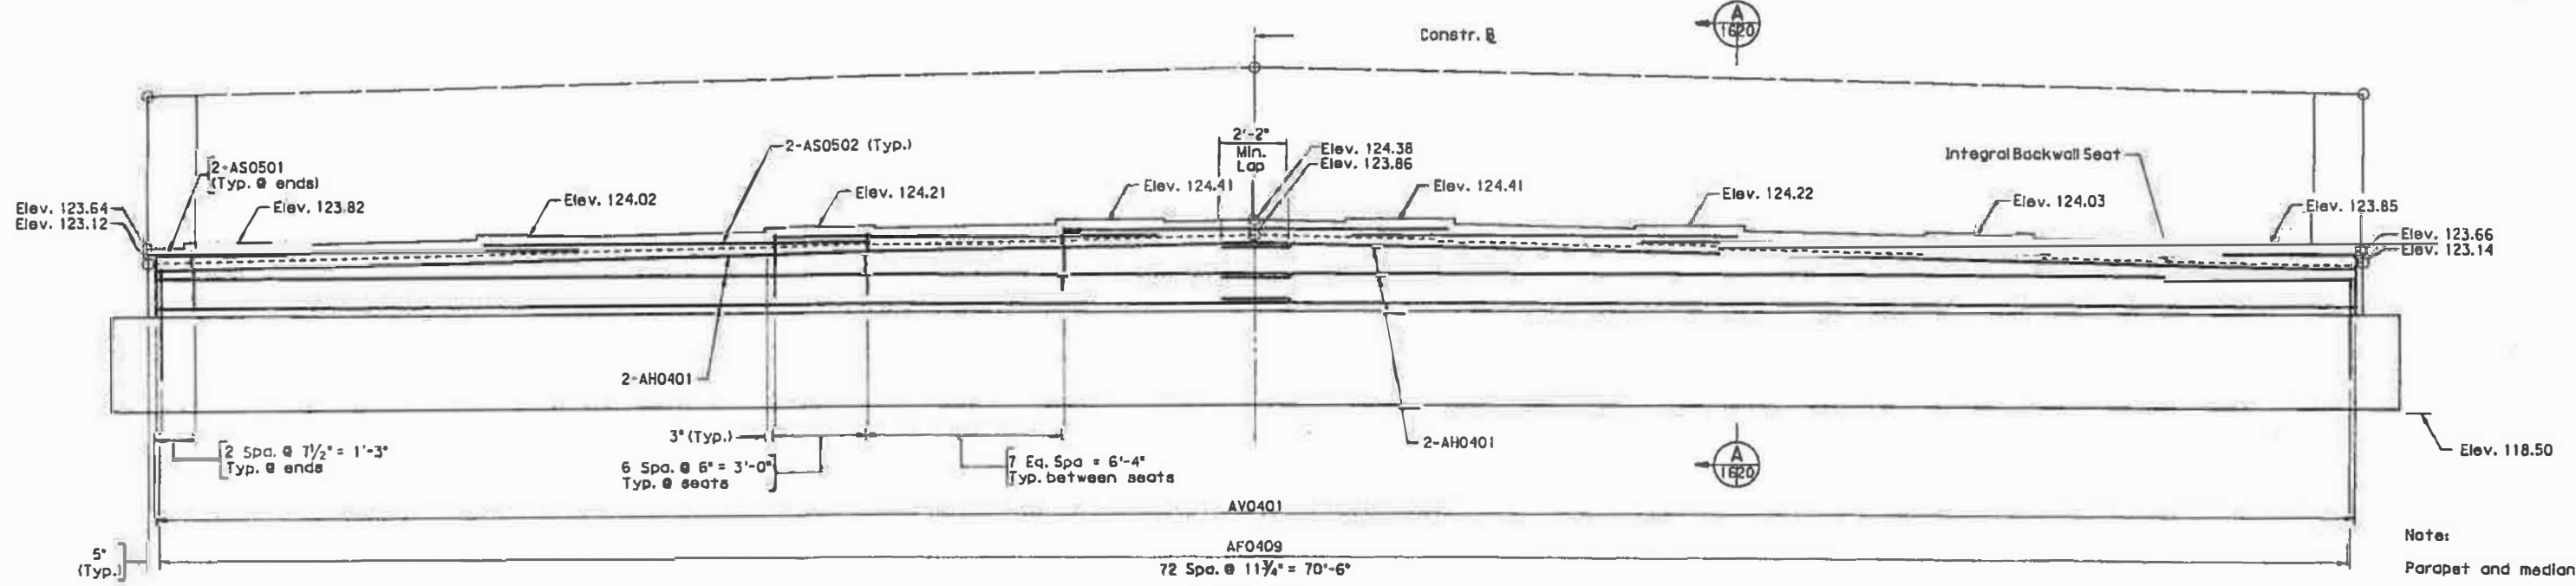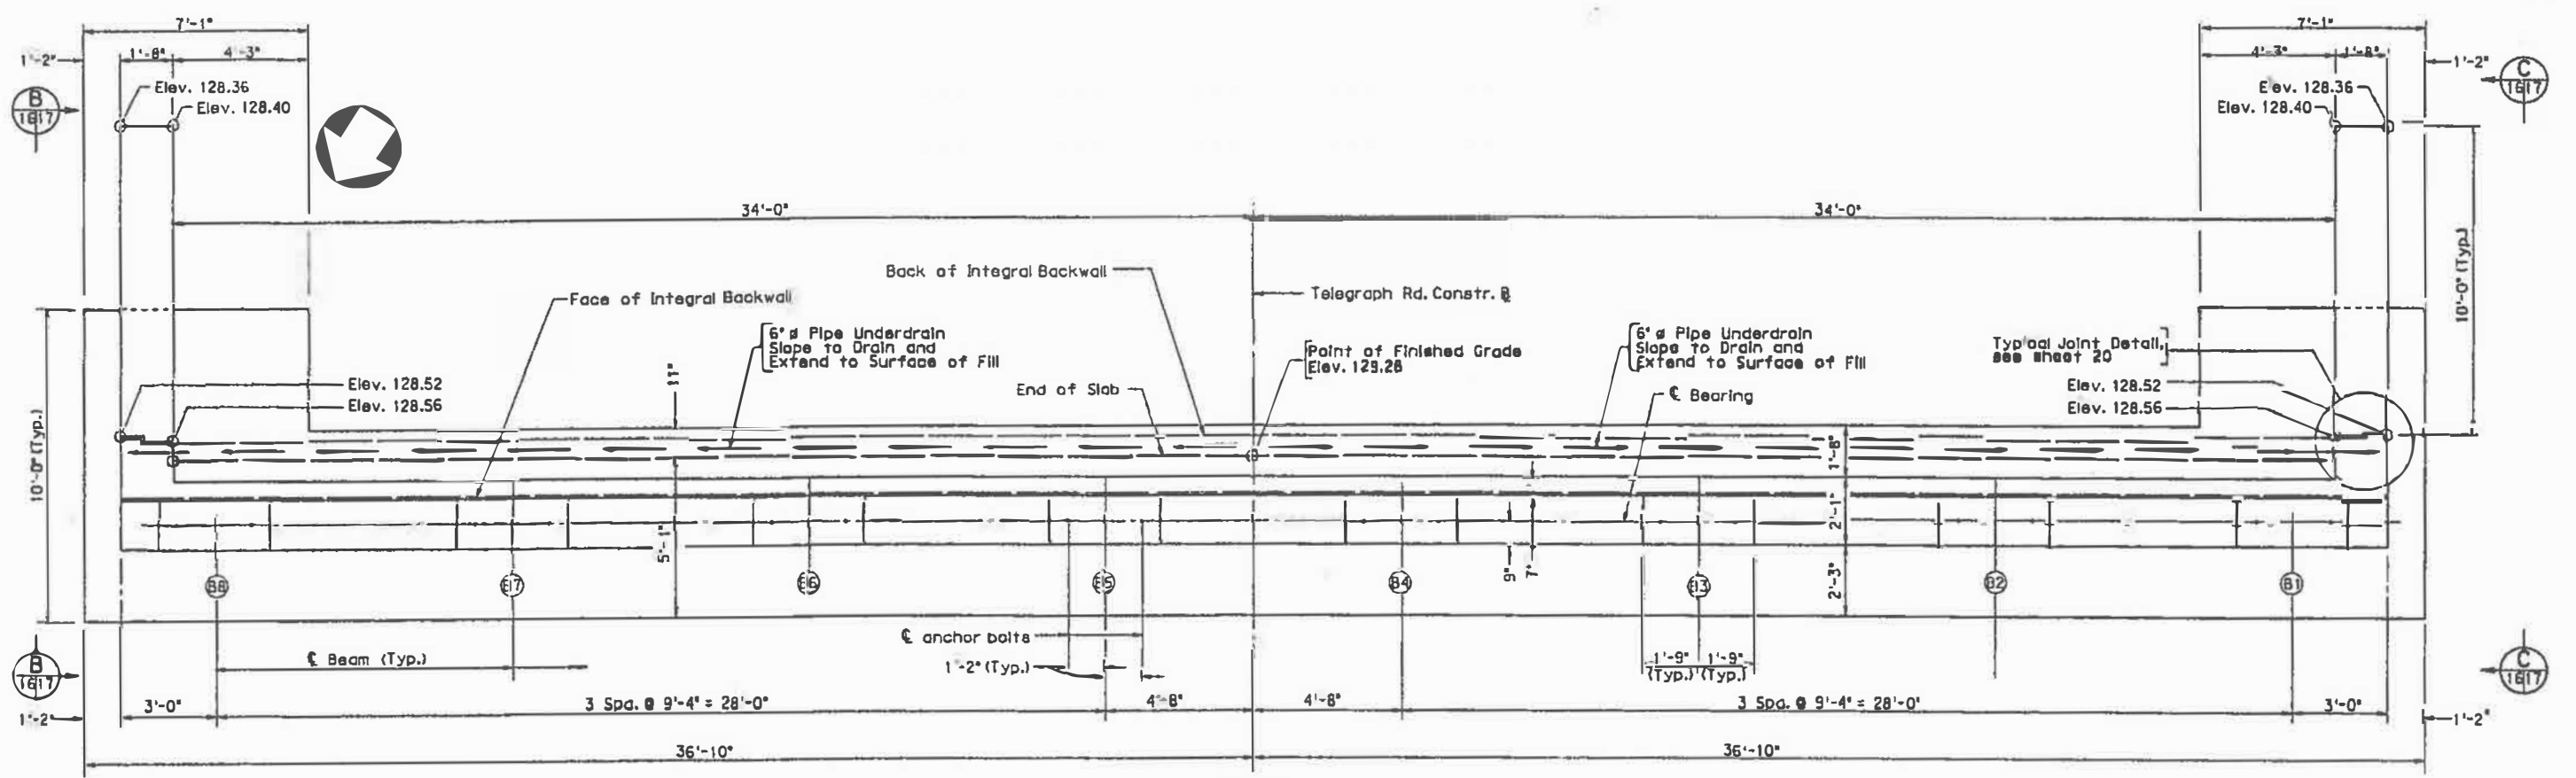


Footing reinforcement and piles not shown
Scale: 3/8" = 1'-0"

Note:
Parapet and median not shown

No.	Description	Date	Designed: ..	Date	Plan No.
	Revisions		Checked: ..		

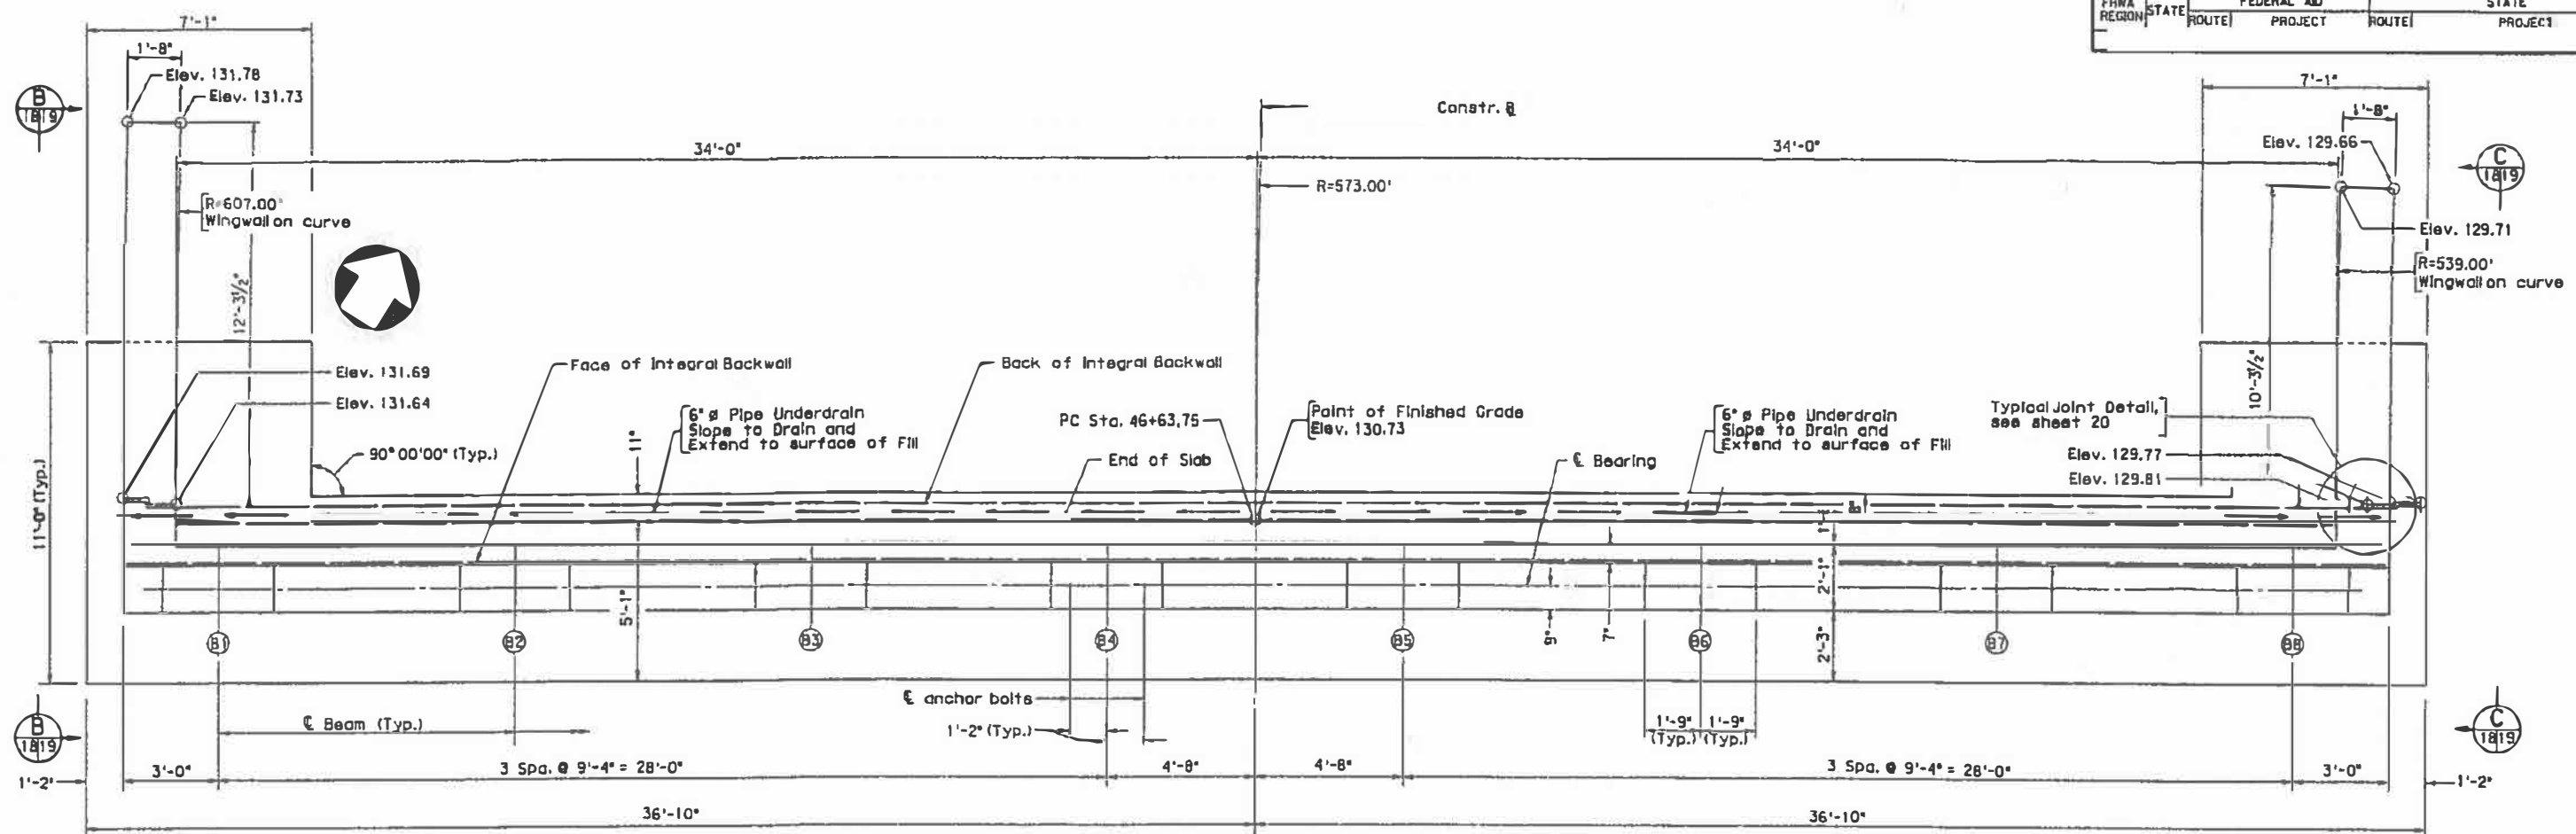

PLAN
Scale: 3/8" = 1'-0"

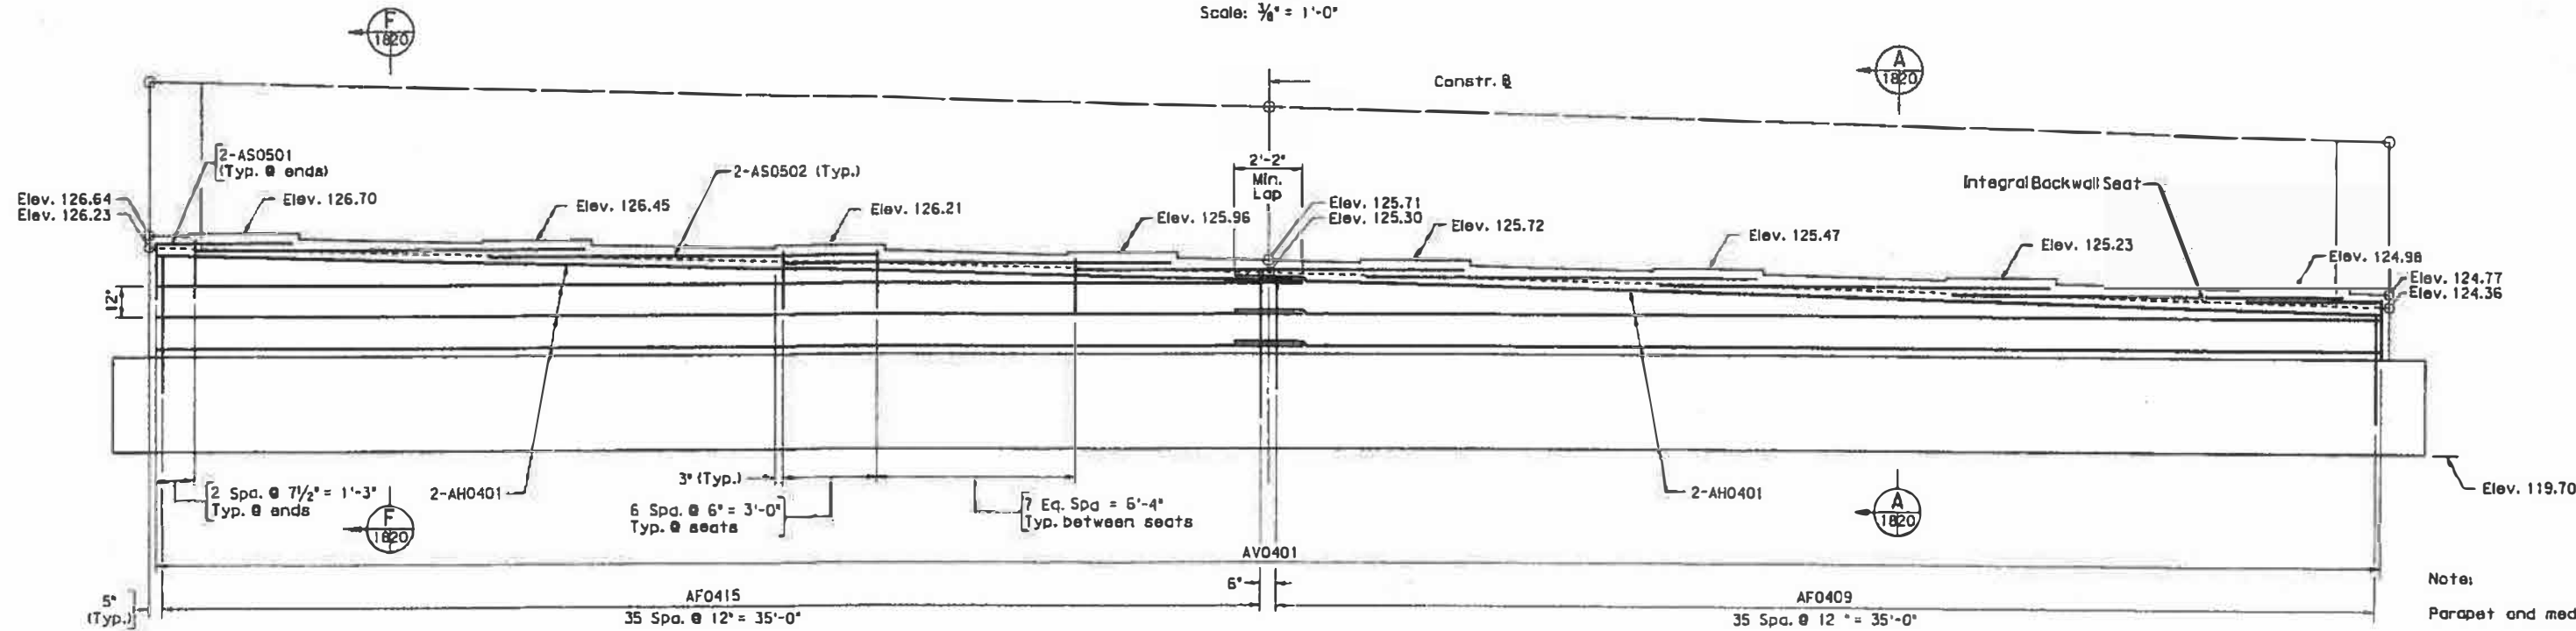


ELEVATION
Footing reinforcement and piles not shown
Scale: 3/8" = 1'-0"


Note:
Parapet and median

No.	Description	Date	Designed:	Date	Plan

**ABUTMENT E
PLAN & ELEVATION**

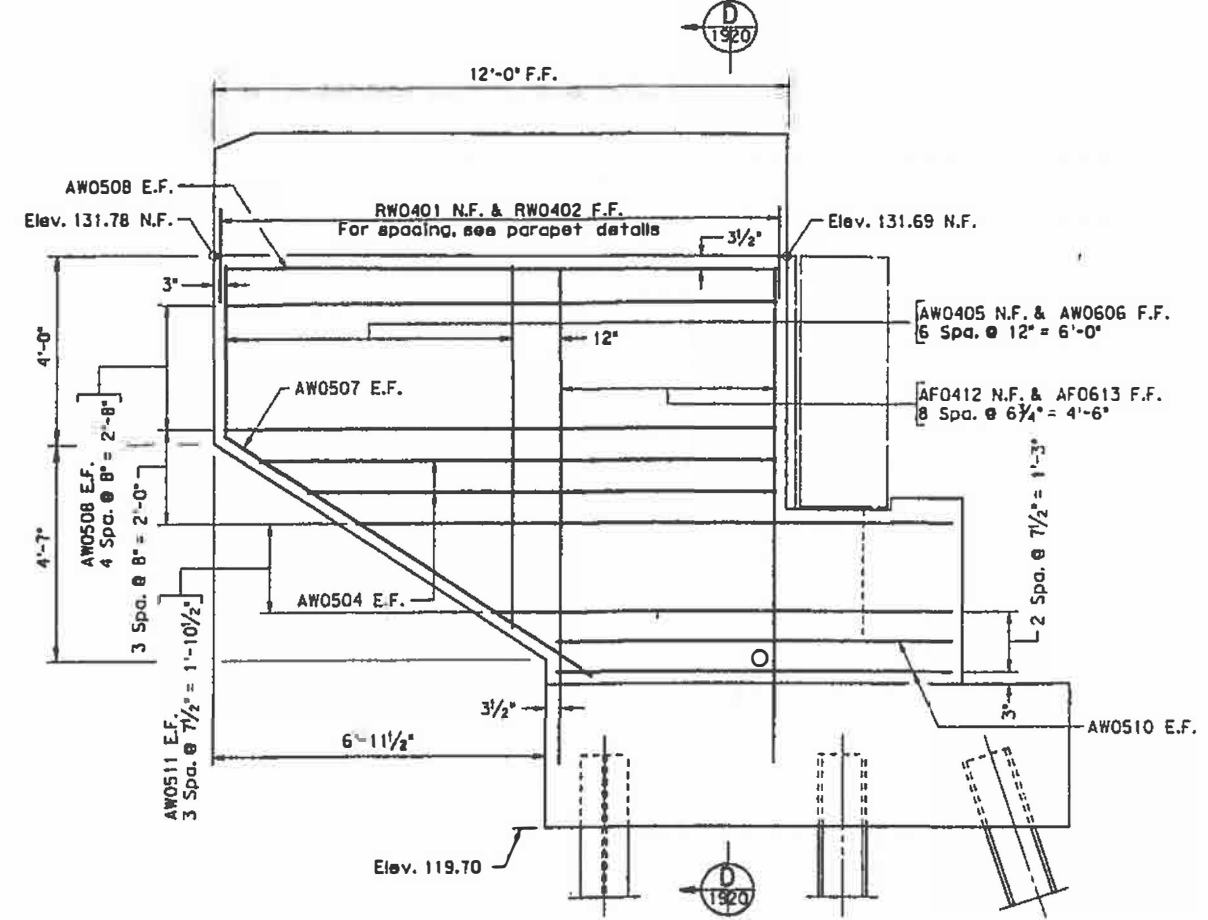


VIEW B
Footing reinforcement not shown

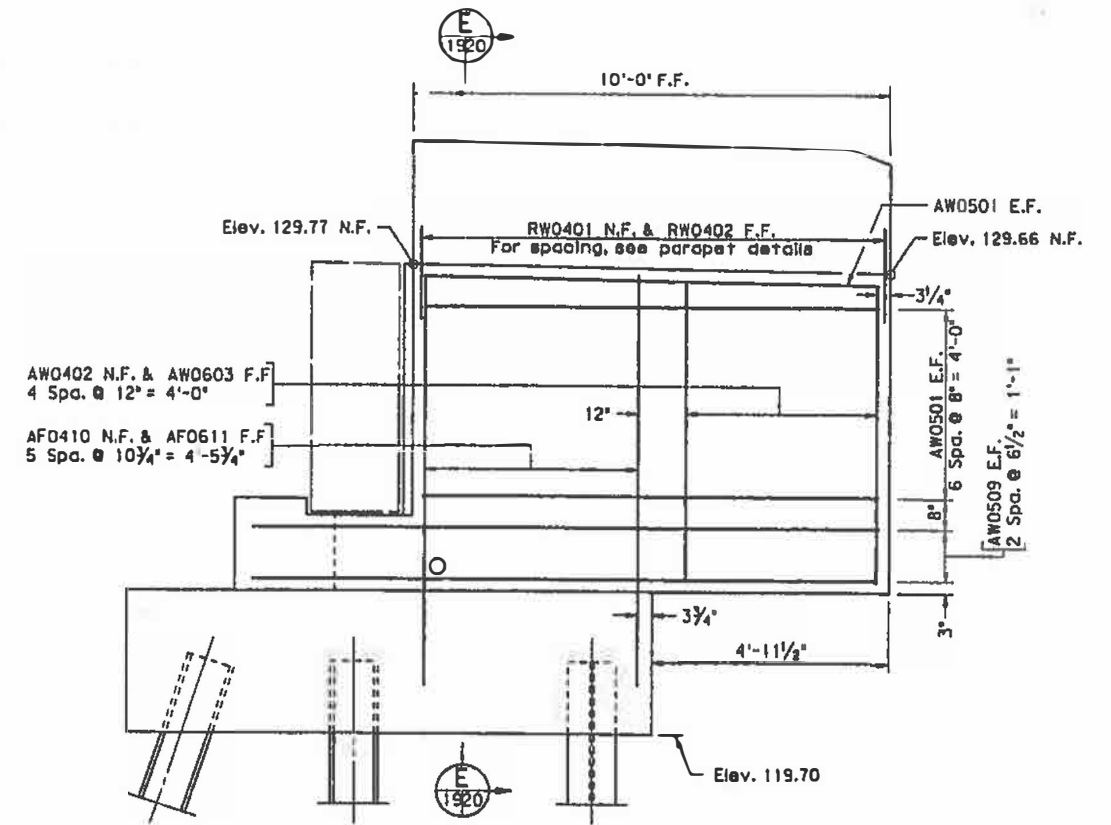

VIEW C
Footing reinforcement not shown

Legend:
F.F. - Far Face
N.F. - Near Face
E.F. - Each Face

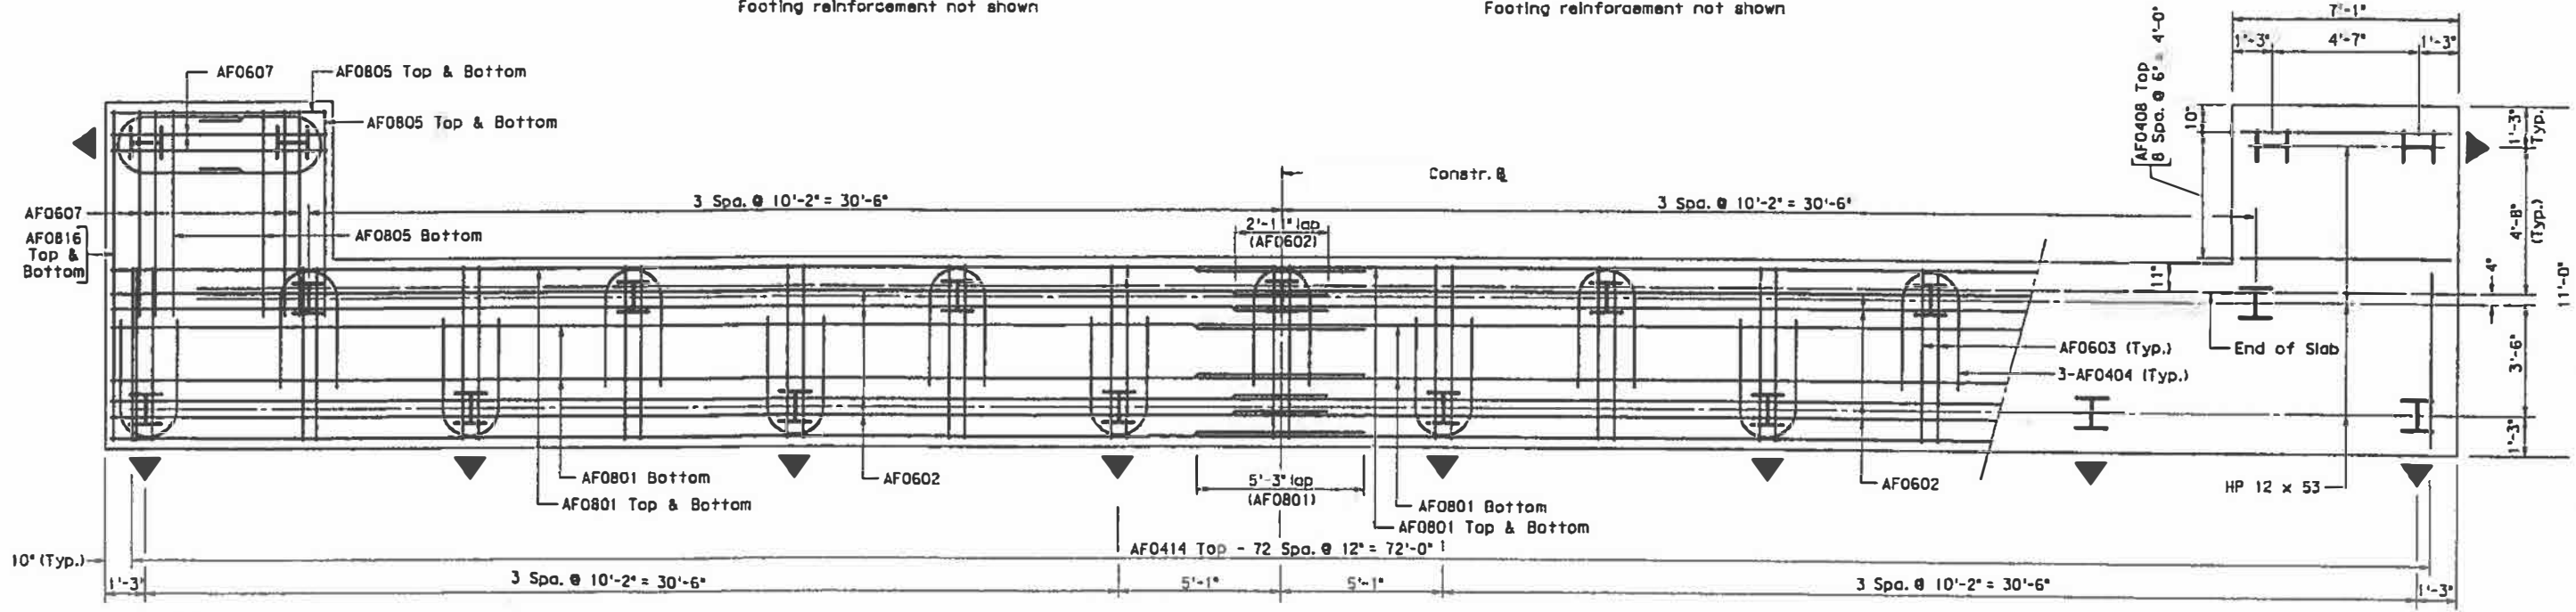






PILE PLAN
Scale: 1/2" = 1'-0"

Note:
1. Piles to be driven to depths in accordance with VDOT Specifications 403.06 (e).

Scale: 1/2" = 1'-0" (unless otherwise shown)

No.	Description	Date	Designed	Checked	Date	Plan No.

ABUTMENT B
PILE PLAN & WINGWALL

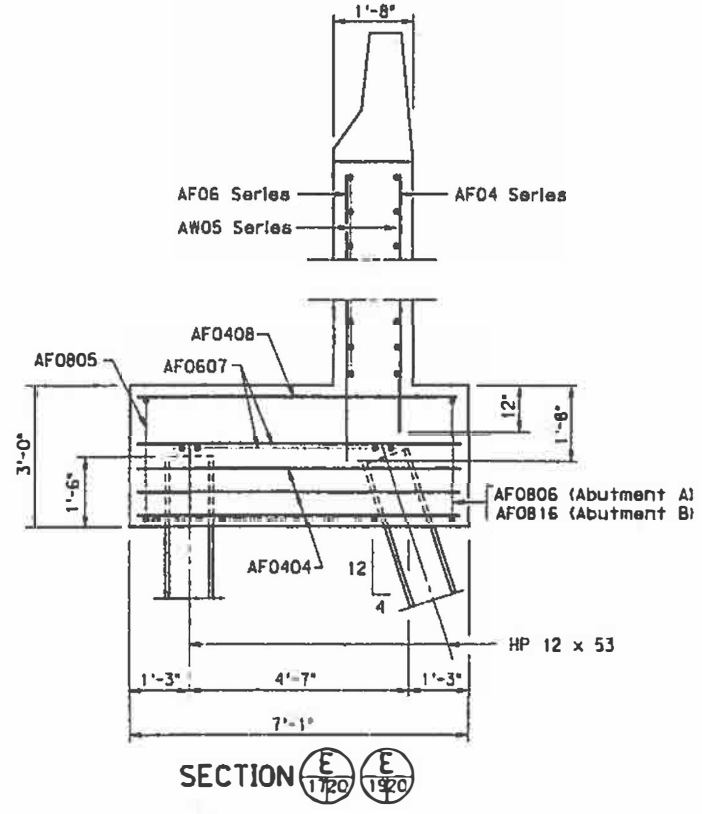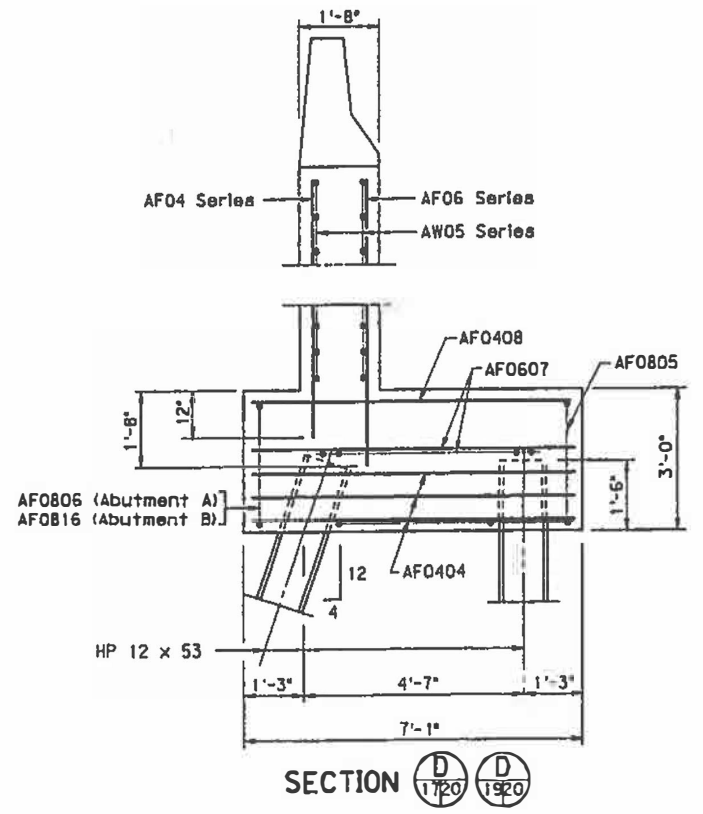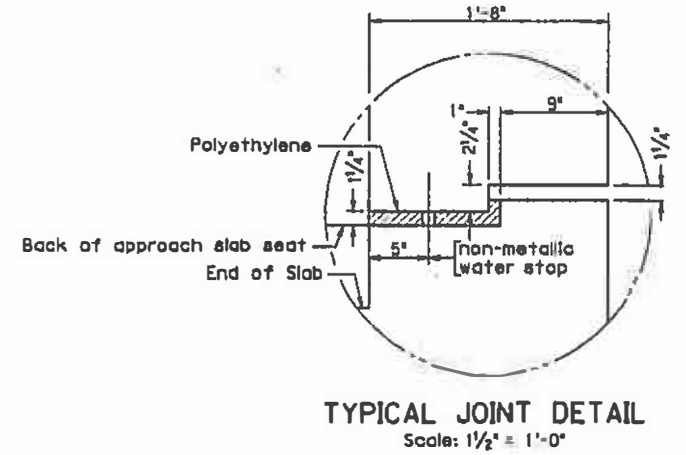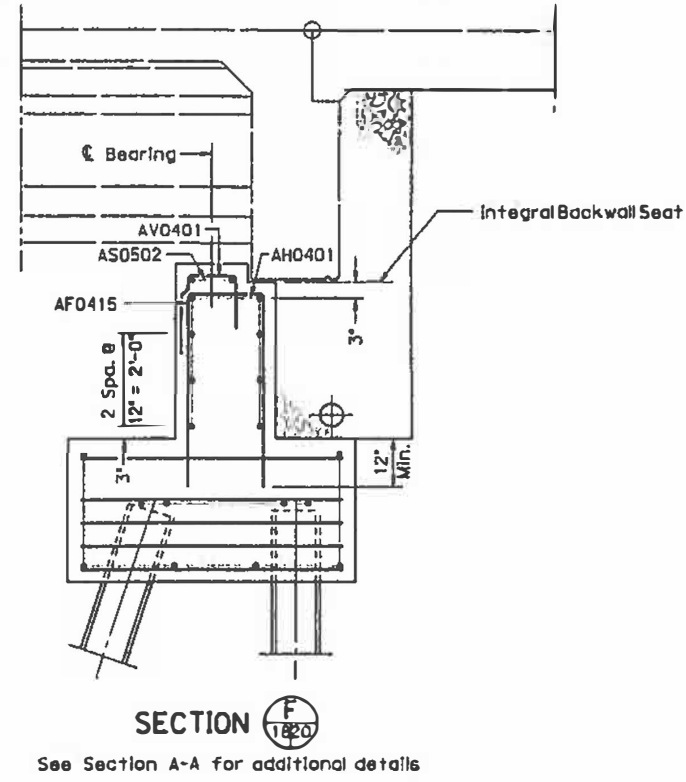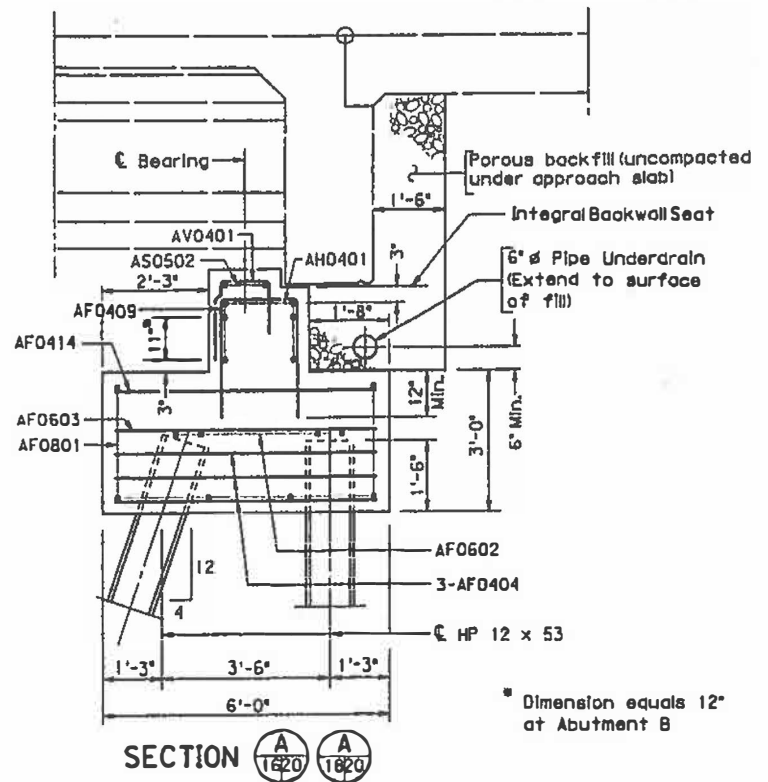


Scale: 1/2" = 1'-0" (unless otherwise shown)

STRUCTURE AND BRIDGE DIV					
ABUTMENTS A & SECTIONS & DET					
No.	Description	Date	Designed by	Date	Plan No.
Revisions			Checked:		

REINFORCING STEEL SCHEDULE						DIMENSION TABLE																
MARK	NO.	SIZE	PIN DIA IN.	LENGTH FT.- IN.	WT. LBS.	LOCATION	MARK	TYPE	A	B	C	D	E	F	G	H	I	J	K	L	V	N
									FT.- IN.	FT.- IN.	FT.- IN.	FT.- IN.	FT.- IN.	FT.- IN.	FT.- IN.	FT.- IN.	FT.- IN.	FT.- IN.	FT.- IN.	FT.- IN.	FT.- IN.	
SUPERSTRUCTURE EPOXY COATED																						
AB0601	44	6		37 - 0	2445	Int. Backwall	AB0601	1	37 - 0													
AB0602	14	6		7 - 6	158	Int. Backwall	AB0602	1	7 - 6													
AB0603	48	6		11 - 7	835	Int. Backwall	AB0603	1	11 - 7													
AB0504	12	5		37 - 0	463	Int. Backwall	AB0504	1	37 - 0													
AB0505	276	5		3 - 0	864	Int. Backwall	AB0505	1	3 - 0													
AB0606	4	6		1 - 11	12	Int. Backwall	AB0606	1	1 - 11													
AV0401	138	4	2	7 - 5	683	Int. Backwall	AV0401	7		0 - 10	2 - 9	4 - 0										
AV0402	40	4	2	6 - 0	160	Int. Backwall	AV0402	6		3 - 4	2 - 9											
AV0403	170	4	3	4 - 4	492	Int. Backwall	AV0403	30		1 - 5	2 - 6 1/4					0 - 4 1/2						
AV0404	32	4	3	3 - 9	80	Int. Backwall	AV0404	30		0 - 10	2 - 6 1/4					0 - 4 1/2						
AV0405	138	4	2	6 - 3	576	Int. Backwall	AV0405	7		1 - 5	2 - 6	2 - 6										
AV0506	138	5	3 3/4	4 - 3	612	Int. Backwall	AV0506	2	2 - 9 3/4				1 - 3/8	1 - 3/8	1 - 5 1/2							
SB0501	188	5	3 3/4	43 - 3	8481	Slab	SB0501	59	4 - 10 5/8	4 - 2 3/8	4 - 5 5/8	4 - 5 5/8	4 - 5 5/8	4 - 2 3/8	4 - 2 3/8		0 - 4 7/8	0 - 4	0 - 6 1/4		4 - 2 3/8	5
SB0502	188	5	3 3/4	31 - 4 1/2	6153	Slab	SB0502	59	1 - 11	4 - 10 5/8	4 - 5 5/8	4 - 5 5/8	4 - 5 5/8	4 - 2 3/8	4 - 2 3/8		0 - 4 7/8	0 - 4	0 - 6 1/4			4
SC0501	378	5		42 - 3	16657	Slab	SC0501	1	42 - 3													
SC0502	378	5		30 - 7	12058	Slab	SC0502	1	30 - 7													
SL0401	184	4		49 - 8	6105	Slab	SL0401	1	49 - 8													
SL0602	296	6		34 - 0	15116	Slab	SL0602	1	34 - 0													
SL0403	92	4		34 - 9	2136	Slab	SL0403	1	34 - 9													
SL0404	424	4		48 - 9	13808	Slab	SL0404	1	48 - 9													
DL0601	108	6		7 - 8	1244	Diaphragm	DL0601	1	7 - 8													
DL0602	42	6		8 - 5	531	Diaphragm	DL0602	1	8 - 5													
DL0403	42	4		8 - 5	236	Diaphragm	DL0403	1	8 - 5													
DL0404	42	4		7 - 8	215	Diaphragm	DL0404	1	7 - 8													
DL0605	32	6		35 - 0	1682	Diaphragm	DL0605	1	35 - 0													
DL0406	14	4	2	6 - 10	64	Diaphragm	DL0406	7		5 - 0	1 - 0	1 - 0										
DL0607	6	6		7 - 6	68	Diaphragm	DL0607	1	7 - 6													
DS0401	162	4	2	7 - 7	821	Diaphragm	DS0401	17		0 - 9 1/8	2 - 11 1/2	0 - 6										
DS0402	112	4	2	10 - 1	755	Diaphragm	DS0402	17		0 - 9 1/8	4 - 2	0 - 7										
DS0403	8	4	2	6 - 0	32	Diaphragm	DS0403	7		4 - 2	1 - 0	1 - 0										
DS0404	27	4	2	8 - 9	158	Diaphragm	DS0404	17		0 - 9 1/8	3 - 6 1/2	0 - 6										
ML0301	37	3		48 - 6	675	Median	ML0301	1	48 - 6													
ML0302	1	3		19 - 0	7	Median	ML0302	1	19 - 0													
ML0303	1	3		38 - 0	14	Median	ML0303	1	38 - 0													
ML0304	3	3		9 - 9	32	Median	ML0304	1	V A R Y													
ML0305	1	3		19 - 6	7	Median	ML0305	1	19 - 6													
ML0306	1	3		38 - 6	14	Median	ML0306	1	38 - 6													
ML0307	1	3		10 - 3	4	Median	ML0307	1	10 - 3													
ML0308	1	3		29 - 3	11	Median	ML0308	1	29 - 3													
ML0309	20	3		2 - 0	15	Median	ML0309	1	2 - 0													
MT0301	192	3		3 - 10	620	Median	MT0301	1	V A R Y													
TOTAL EPOXY COATED					95100																	

DIMENSION VARIATION TABLE								
MARK	NO. EA. LEN.	DIM.	FROM FT.- IN.	TO FT.- IN.	VARY BY FT.- IN.	DIM.	FROM FT.- IN.	TO FT.- IN.
ML0304	1	A	9 - 9	47 - 9	19 - 0			
MT0301	2	A	3 - 10	13 - 4	0 - 1 3/16			

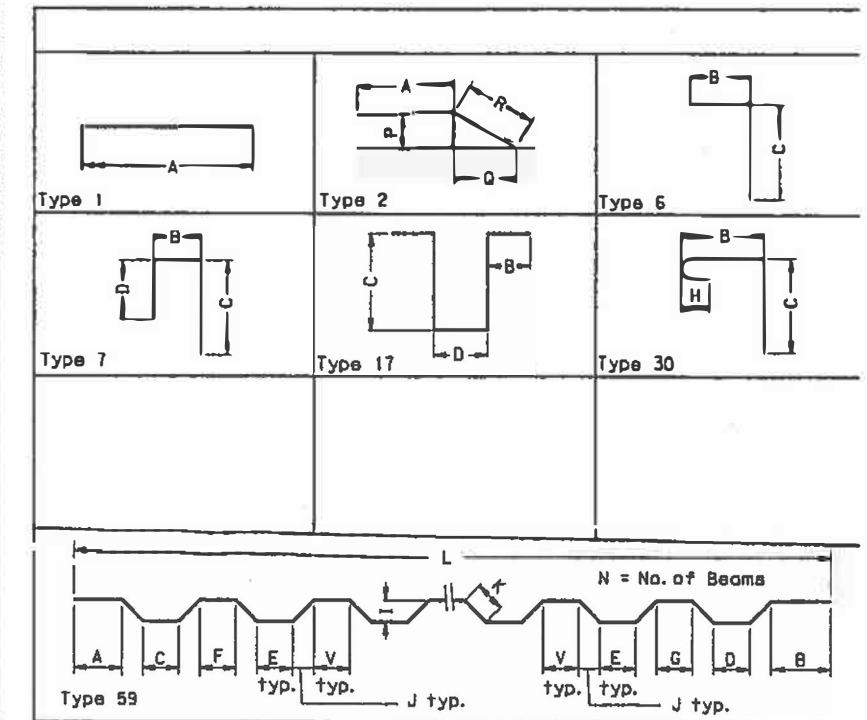


STRUCTURE AND BRIDGE DIV				
REINFORCING STEEL SCHEDULE I				
No.	Description	Date	Designed:	Date
			Drawn:	
			Checked:	
Plan No.				

27833016 980918






REINFORCING STEEL SCHEDULE							DIMENSION TABLE																		
MARK	NO.	SIZE	PIN DIA IN.	LENGTH FT.- IN.	WT. LBS.	LOCATION	MARK	TYPE	A	B	C	D	E	F	G	H	I	J	K	L	V	N			
ABUTMENT A - UNCOATED																									
AF0801	12	8		39 - 3	1258	Footng	AF0801	1	39 - 3																
AF0602	8	6		38 - 1	458	Footng	AF0602	1	38 - 1																
AF0603	30	6		5 - 6	248	Footng	AF0603	1	5 - 6																
AF0404	57	4	21	8 - 8	330	Footng	AF0404	45	3 - 10 1/8	3 - 10 1/8															
AF0805	12	8		6 - 7	211	Footng	AF0805	1	6 - 7																
AF0806	4	8		9 - 6	101	Footng	AF0806	1	9 - 6																
AF0607	12	6		6 - 7	119	Footng	AF0607	1	6 - 7																
AF0408	14	4		6 - 7	62	Footng	AF0408	1	6 - 7																
AF0409	73	4	2	8 - 6	414	Footng	AF0409	7		1 - 8	3 - 6	3 - 6													
AF0410	10	4		7 - 9	52	Footng	AF0410	1	7 - 9																
AF0611	10	6		8 - 5	126	Footng	AF0611	1	8 - 5																
AF0414	73	4		5 - 6	268	Footng	AF0414	1	5 - 6																
TOTAL UNCOATED					3650																				
EPOXY COATED																									
AH0401	12	4		36 - 6	293	Abut. Stem	AH0401	1	36 - 6																
AS0501	4	5		4 - 3	18	Abut. Stem	AS0501	1	4 - 3																
AS0502	14	5		12 - 4	180	Abut. Stem	AS0502	1	12 - 4																
AV0401	102	4	2	4 - 6	306	Abut. Stem	AV0401	7		1 - 0	1 - 10	1 - 10													
AW0501	32	5		9 - 6	317	Wingwall	AW0501	1	9 - 6																
AW0402	12	4		6 - 5	51	Wingwall	AW0402	1	6 - 5																
AW0603	12	6		6 - 5	116	Wingwall	AW0603	1	6 - 5																
AW0509	12	5		13 - 3	166	Wingwall / Stem	AW0509	1	13 - 3																
TOTAL EPOXY COATED					1450																				
ABUTMENT B - UNCOATED																									
AF0801	12	8		39 - 3	1258	Footng	AF0801	1	39 - 3																
AF0602	8	6		38 - 1	458	Footng	AF0602	1	38 - 1																
AF0603	30	6		5 - 6	248	Footng	AF0603	1	5 - 6																
AF0404	57	4	21	8 - 8	330	Footng	AF0404	45	3 - 10 1/8	3 - 10 1/8															
AF0805	12	8		6 - 7	211	Footng	AF0805	1	6 - 7																
AF0607	12	6		6 - 7	119	Footng	AF0607	1	6 - 7																
AF0408	18	4		6 - 7	79	Footng	AF0408	1	6 - 7																
AF0409	36	4	2	8 - 6	204	Footng	AF0409	7		1 - 8	3 - 6	3 - 6													
AF0410	6	4		7 - 9	31	Footng	AF0410	1	7 - 9																
AF0611	6	6		8 - 5	76	Footng	AF0611	1	8 - 5																
AF0412	9	4		9 - 9	59	Footng	AF0412	1	9 - 9																
AF0613	9	6		10 - 5	141	Footng	AF0613	1	10 - 5																
AF0414	73	4		5 - 6	268	Footng	AF0414	1	5 - 6																
AF0415	36	4	2	10 - 4	248	Footng	AF0415	7		1 - 8	4 - 5	4 - 5													
AF0816	4	8		10 - 6	112	Footng	AF0816	1	10 - 6																
TOTAL UNCOATED					3840																				
EPOXY COATED																									
AH0401	14	4		36 - 6	341	Abut. Stem	AH0401	1	36 - 6																
AS0501	4	5		4 - 3	18	Abut. Stem	AS0501	1	4 - 3																
AS0502	14	5		12 - 4	180	Abut. Stem	AS0502	1	12 - 4																
AV0401	102	4	2	4 - 6	306	Abut. Stem	AV0401	7		1 - 0	1 - 10	1 - 10													
AW0501	16	5		9 - 6	159	Wingwall	AW0501	1	9 - 6																
AW0402	5	4		6 - 5	21	Wingwall	AW0402	1	6 - 5																
AW0603	5	6		6 - 5	48	Wingwall	AW0603	1	6 - 5																
AW0504	4	5		9 - 9	43	Wingwall	AW0504	1	V A R Y																
AW0405	14	4		3 - 7	52	Wingwall	AW0405	1	V A R Y																
AW0606	14	6		3 - 7	117	Wingwall	AW0606	1	V A R Y																
AW0507	2	5		9 - 3	19	Wingwall	AW0507	1	9 - 3																
AW0508	12	5		11 - 6	144	Wingwall	AW0508	1	11 - 6																
AW0509	6	5		13 - 3	83	Wingwall / Stem	AW0509	1	13 - 3																
AW0510	4	5		8 - 3	34	Wingwall / Stem	AW0510	1	8 - 3																
AW0511	8	5		9 - 8	92	Wingwall / Stem	AW0511	1	V A R Y																
TOTAL EPOXY COATED					1660																				

DIMENSION VARIATION TABLE								
MARK	NO. EA. LEN.	DM.	FROM FT.- IN	TO FT.- IN	VARY BY FT.- IN	DM.	FROM FT.- IN	TO FT.- IN
AW0504	2	A	9 - 9	10 - 9	1 - 0			
AW0405	2	A	3 - 7	7 - 7	0 - 8			
AW0606	2	A	3 - 7	7 - 7	0 - 8			
AW0511	2	A	9 - 8	12 - 5	0 - 11			

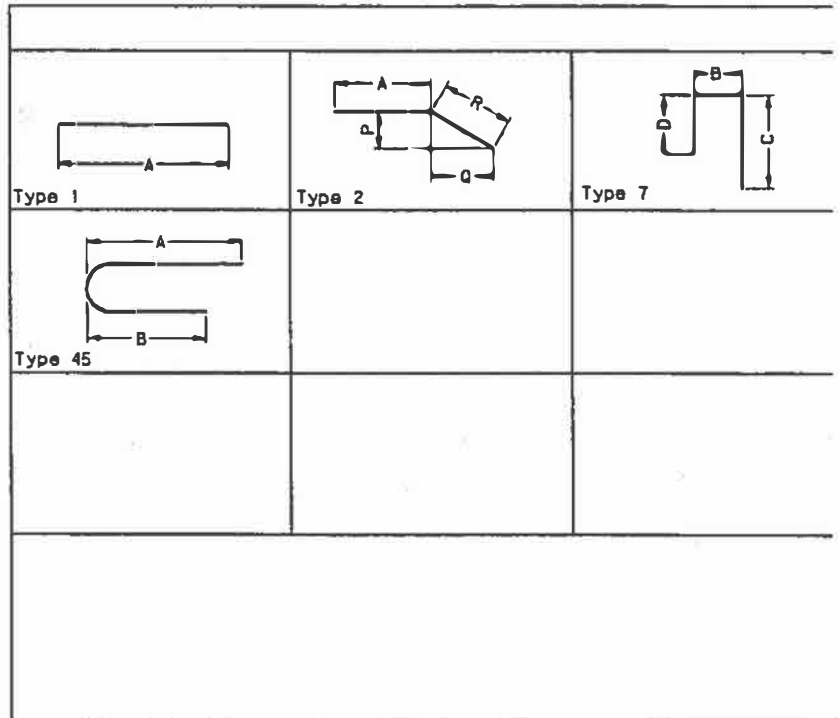

Note:
1. Dimensions in bending diagram are out-to-out of bar.

STRUCTURE AND BRIDGE DIVISION				
REINFORCING STEEL SCHEDULE II				
No.	Description	Date	Designed:	Date
	Revisions		Drawn:	
			Checked:	

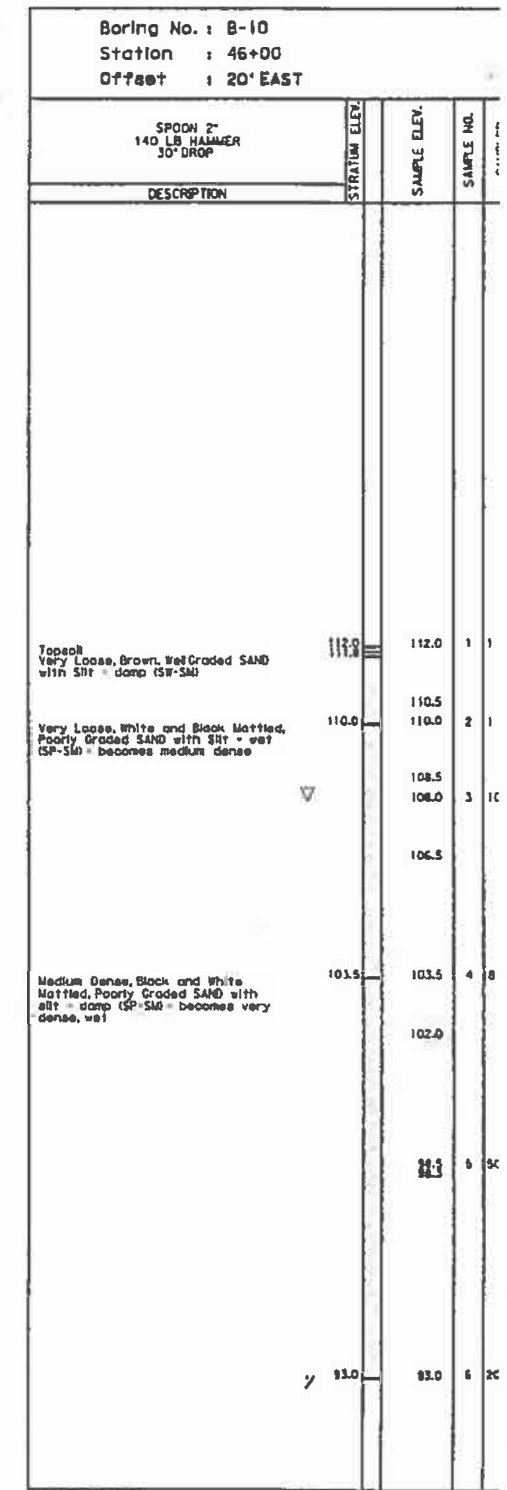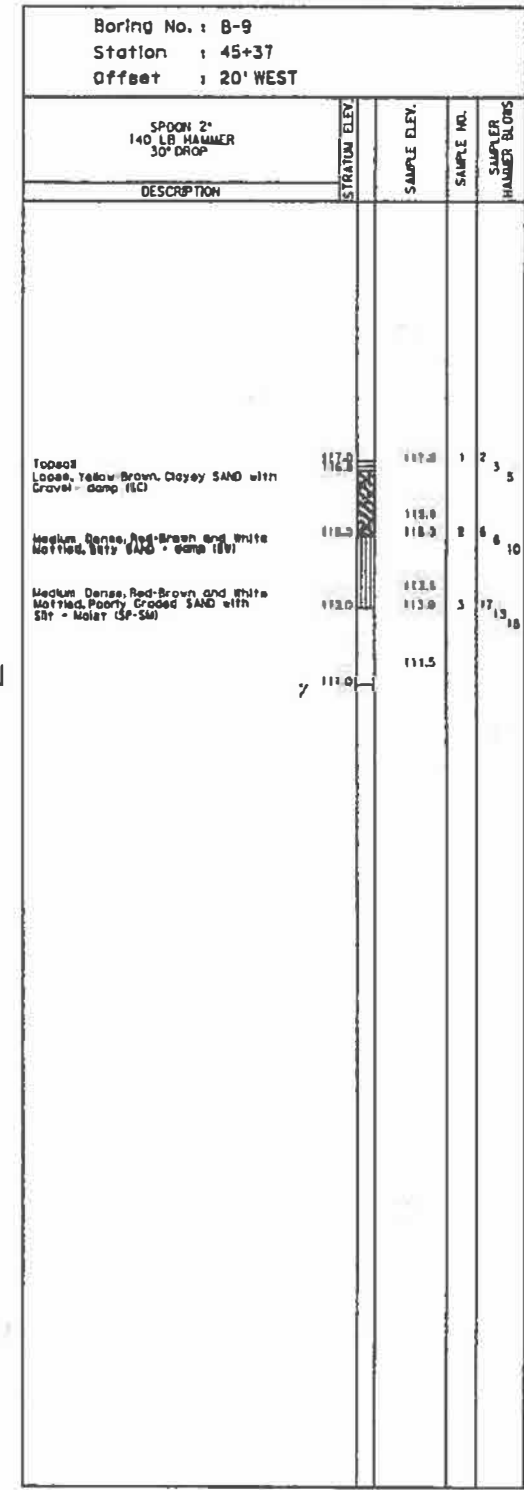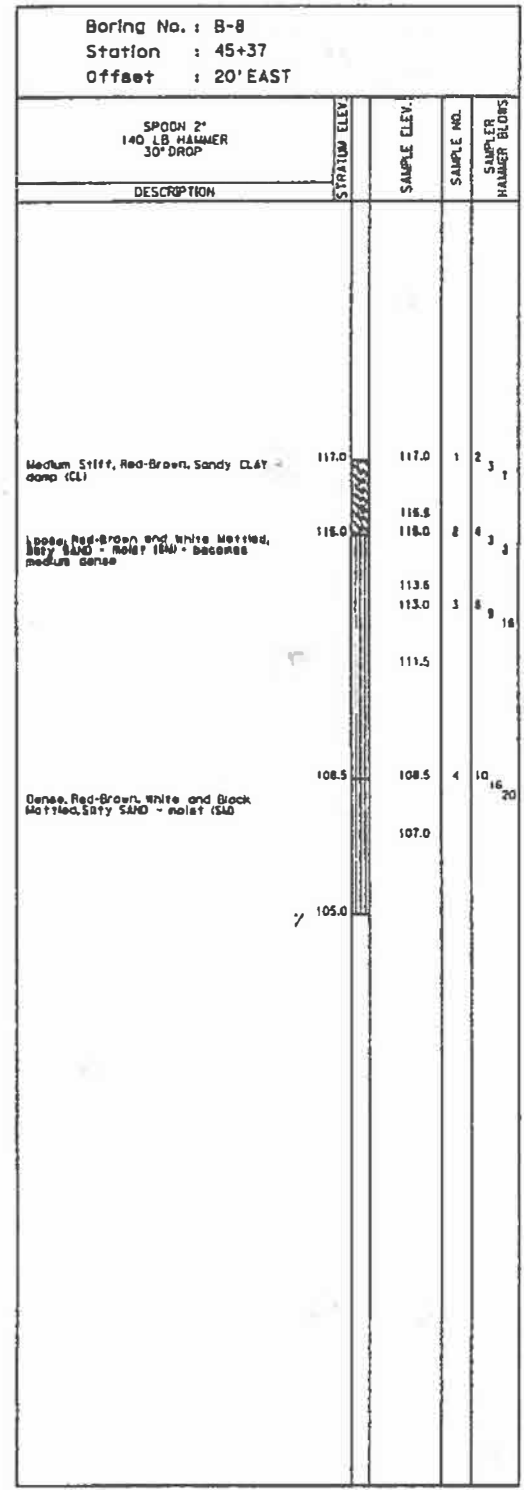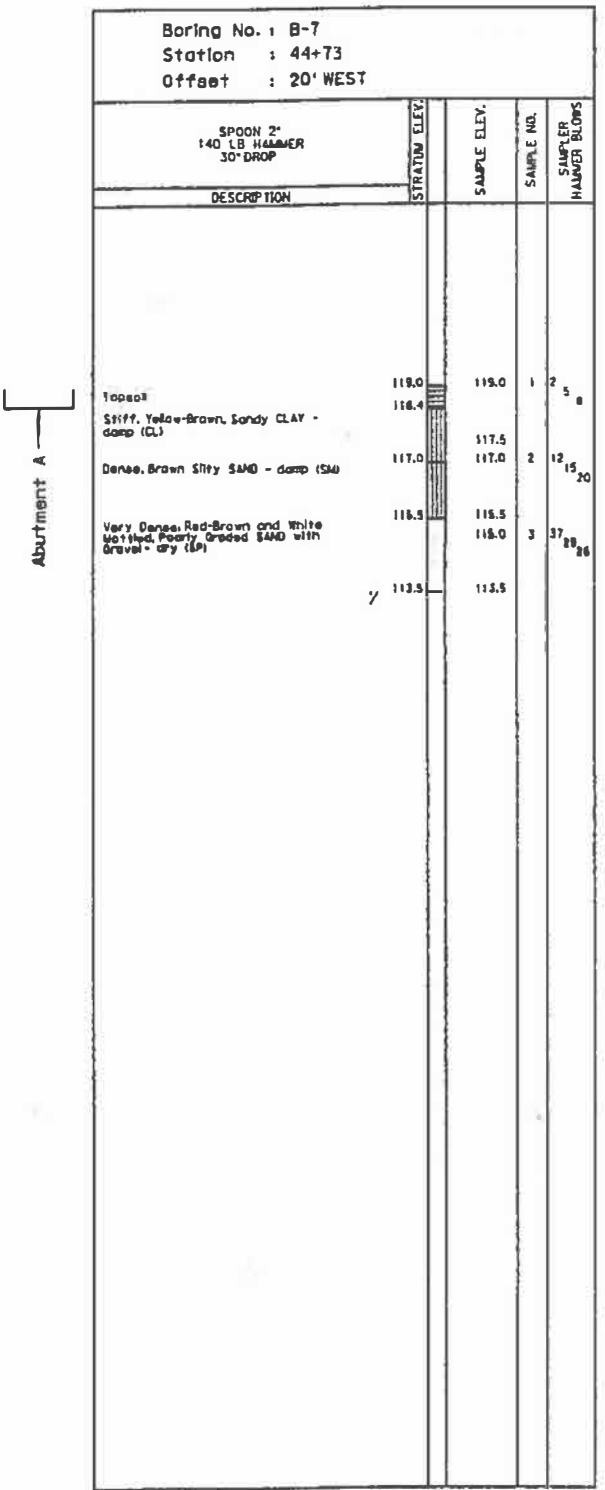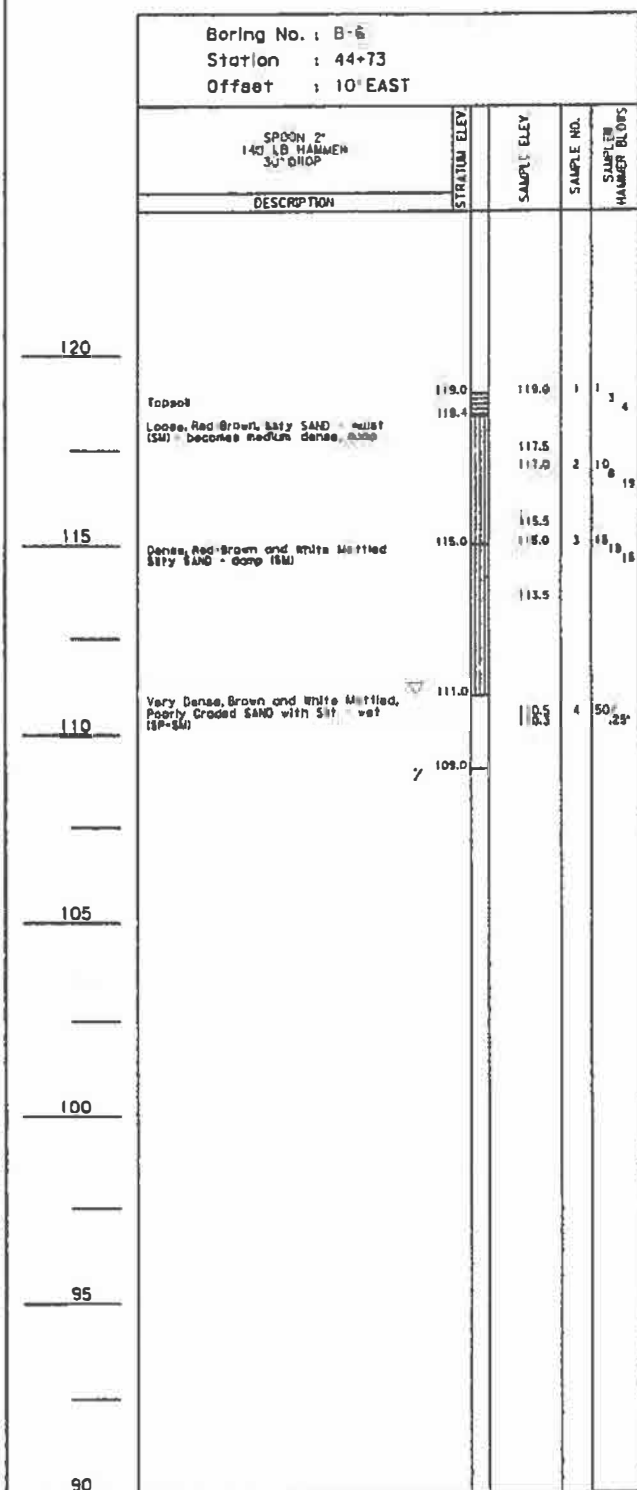

GEOLOGIC SECTION
Scale: 1" = 2.5'




- ▽ ELEVATION OF GROUNDWATER
- ▽ ELEVATION OF CAVE-IN
- ▽ ELEVATION AT BOTTOM OF DRILL HOLE
- EQUIPMENT -
- CB - CORE BARREL

SUBSURFACE INFORMATION - Boring Logs

This subsurface information shown on the boring logs in these plans was obtained with reasonable care and recorded in good faith solely for use by the Department in establishing design controls for the project. The Department has no reason to suspect that such information is not reasonably accurate as an approximate indication of the subsurface conditions at the sites where the borings were taken. The Department does not in any way warrant or guarantee that such data can be projected as indicative of conditions beyond the limits of the borings shown; and any such projections by bidders are purely interpretive and altogether speculative. Further, the Department does not in any way guarantee, either expressly or by implication, the sufficiency of the information for bid purposes.

The boring logs are made available to bidders in order that they may have access to subsurface data identical to that which is possessed by the Department, and are not intended as a substitute for personal investigation, interpretation and judgment by the bidders.

STRUCTURE AND BRIDGE DIV				
ENGINEERING GEOLO				
No.	Description	Date	Designed: _____	Plan No.
Revisions			Checked: _____	

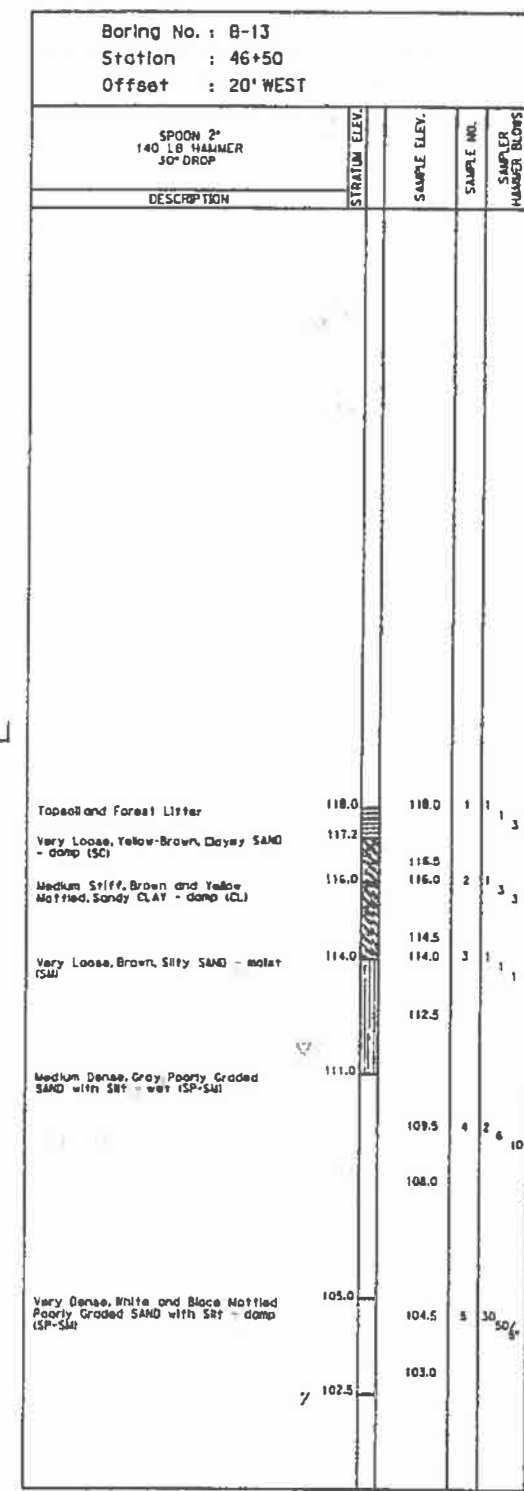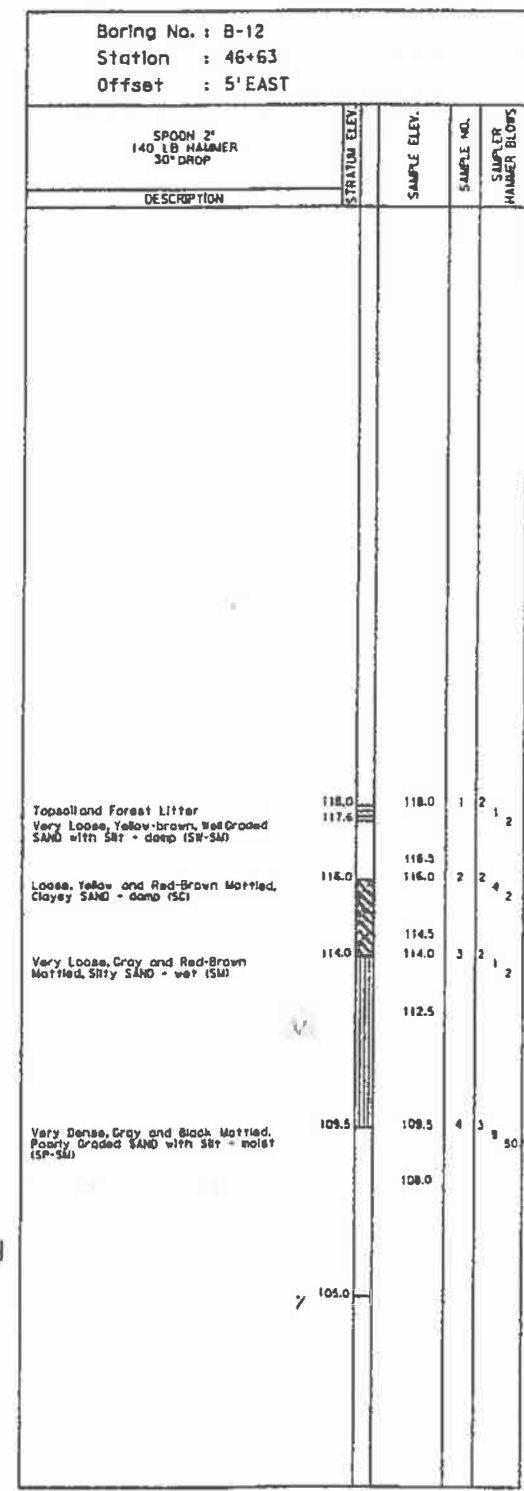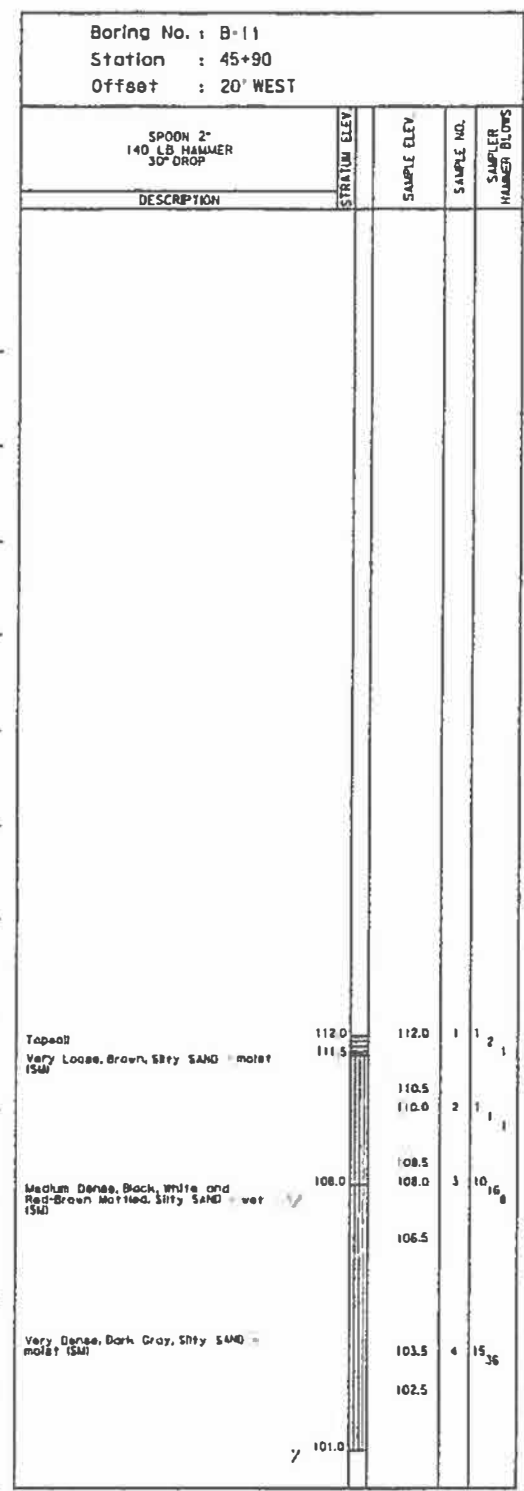

Abutment B

Pier 2

GEOLOGIC SECTION
Scale: 1" = 2.5'






- ▽ ELEVATION OF GROUNDWATER
- ELEVATION OF CAVE-IN
- γ ELEVATION AT BOTTOM OF DRILL HOLE
- EQUIPMENT
- CB - CORE BARREL

SUBSURFACE INFORMATION - Boring Logs

This subsurface information shown on the boring logs in these plans was obtained with reasonable care and recorded in good faith solely for use by the Department in establishing design controls for the project. The Department has no reason to suspect that such information is not reasonably accurate as an approximate indication of the subsurface conditions at the sites where the borings were taken. The Department does not in any way warrant or guarantee that such data can be projected as indicative of conditions beyond the limits of the borings shown; and any such projections by bidders are purely interpretive and altogether speculative. Further, the Department does not in any way guarantee, either expressly or by implication, the sufficiency of the information for bid purposes.

The boring logs are made available to bidders in order that they may have access to subsurface data identical to that which is possessed by the Department, and are not intended as a substitute for personal investigation, interpretation and judgment by the bidders.

				C	
				STRUCTURE AND BRIDGE DIV.	
				ENGINEERING GEOLO	
No.	Description	Date	Designed:	Date	Plan No.
Revisions			Drawn:	Checked:	

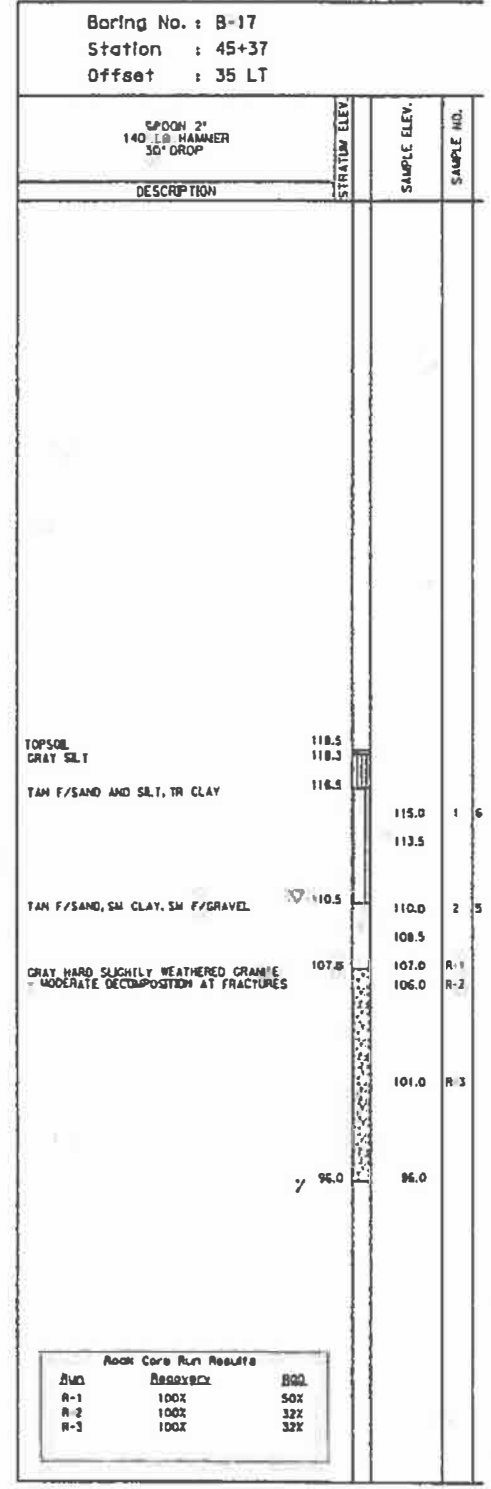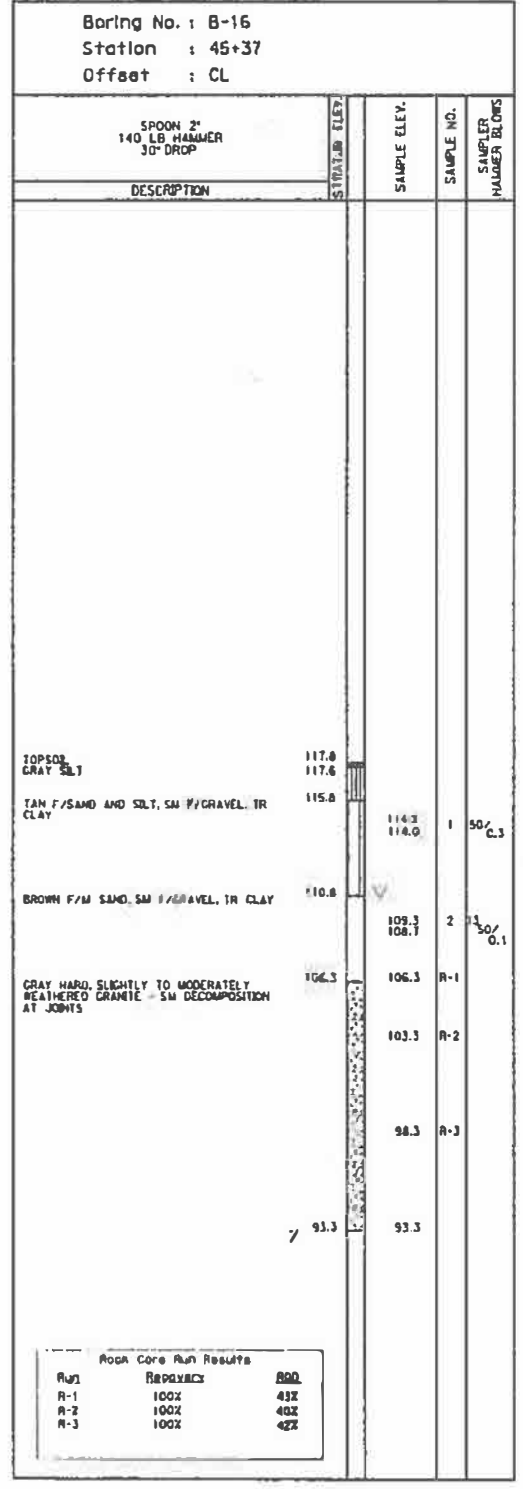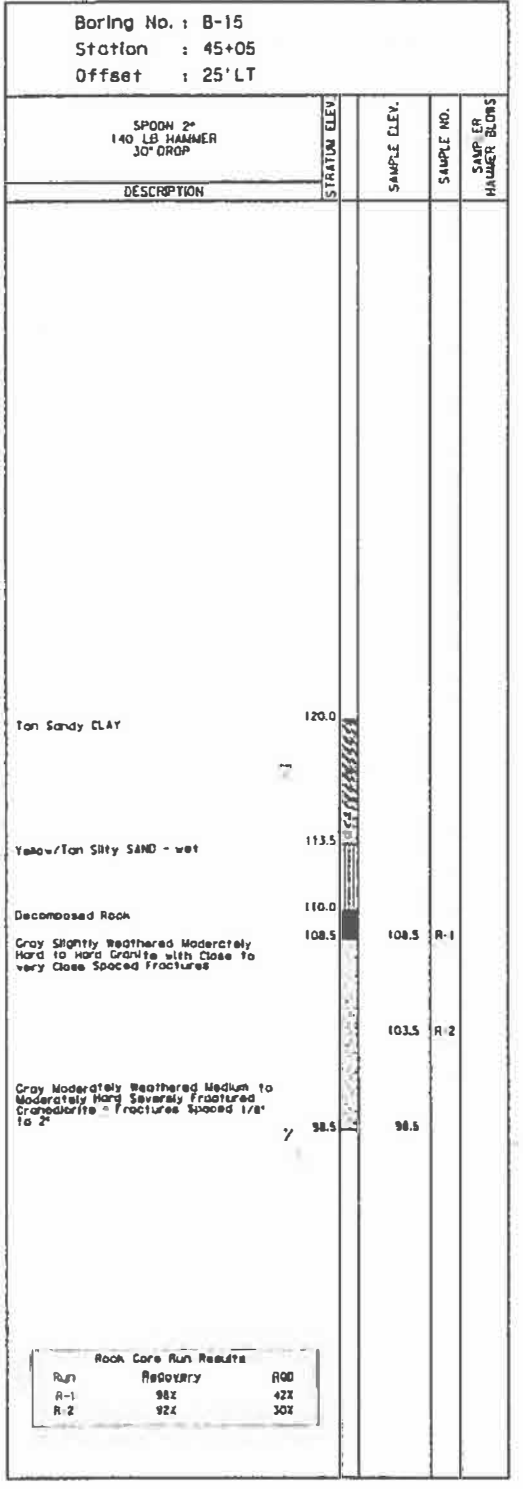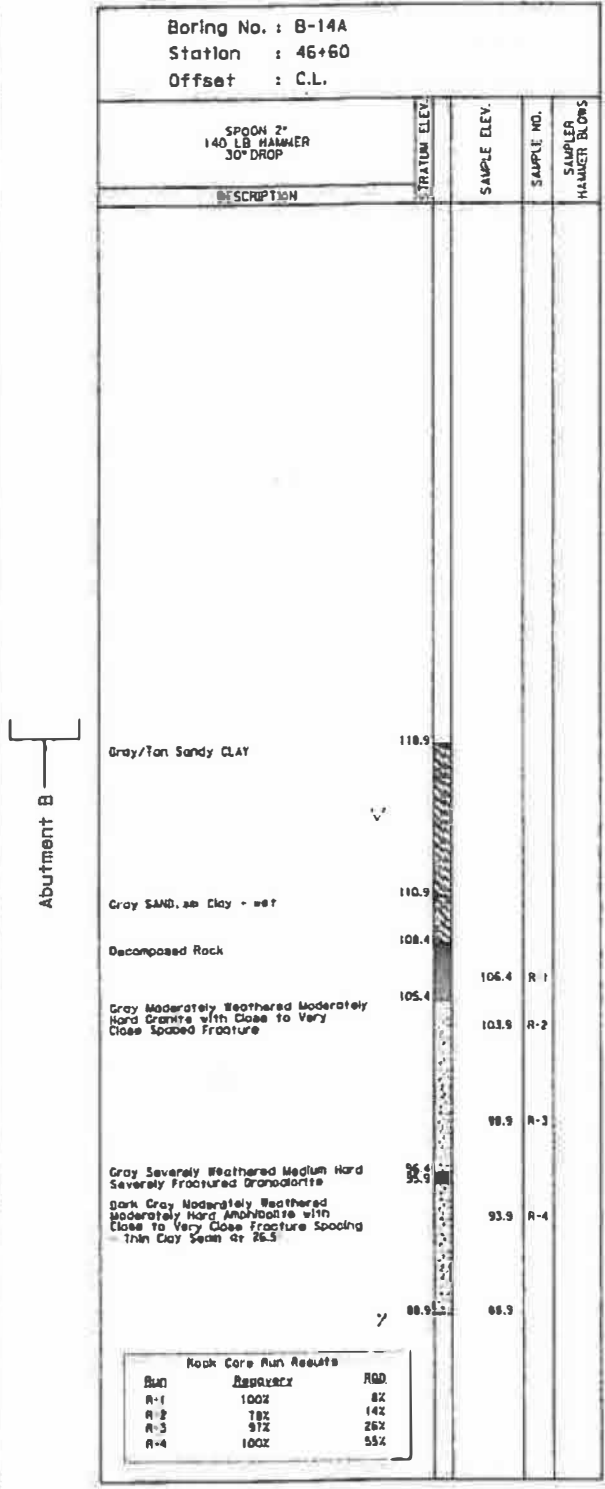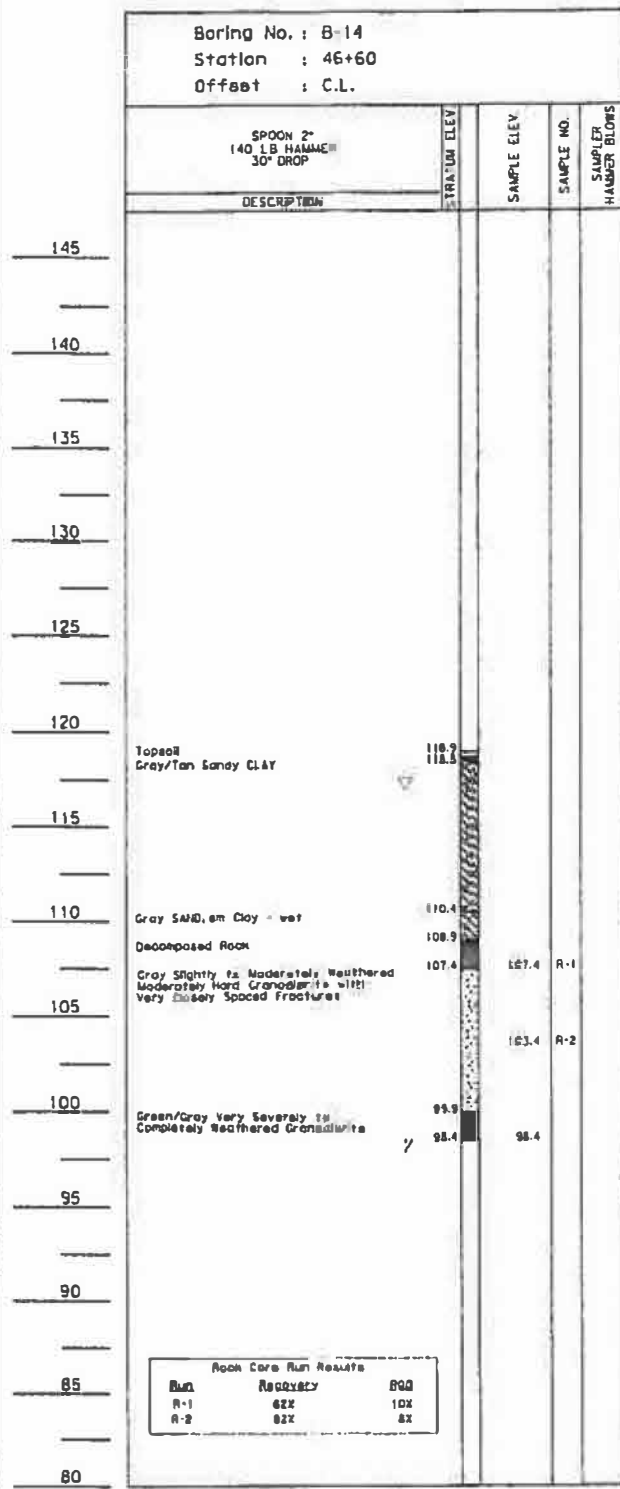

GEOLOGIC SECTION
Scale: 1" = 5.0'


SUBSURFACE INFORMATION - Boring Logs

This subsurface information shown on the boring logs in these plans was obtained with reasonable care and recorded in good faith solely for use by the Department in establishing design controls for the project. The Department has no reason to suspect that such information is not reasonably accurate as an approximate indication of the subsurface conditions at the sites where the borings were taken. The Department does not in any way warrant or guarantee that such data can be projected as indicative of conditions beyond the limits of the borings shown, and any such projections by bidders are purely interpretive and altogether speculative. Further, the Department does not in any way guarantee, either expressly or by implication, the sufficiency of the information for bid purposes.

The boring logs are made available to bidders in order that they may have access to subsurface data identical to that which is possessed by the Department, and are not intended as a substitute for personal investigation, interpretation and judgment by the bidders.

- ELEVATION OF GROUNDWATER
- ELEVATION OF CAVE-IN
- ▽ ELEVATION AT BOTTOM OF DRILL HOLE
- EQUIPMENT -
- CB CORE BARREL
- INDICATES WEATHERED ROCK

STRUCTURE AND BRIDGE DE				
ENGINEERING GEOLO				
No.	Description	Date	Designed:	Date
	Revisions		Drawn:	
			Checked:	
				Proj. M.

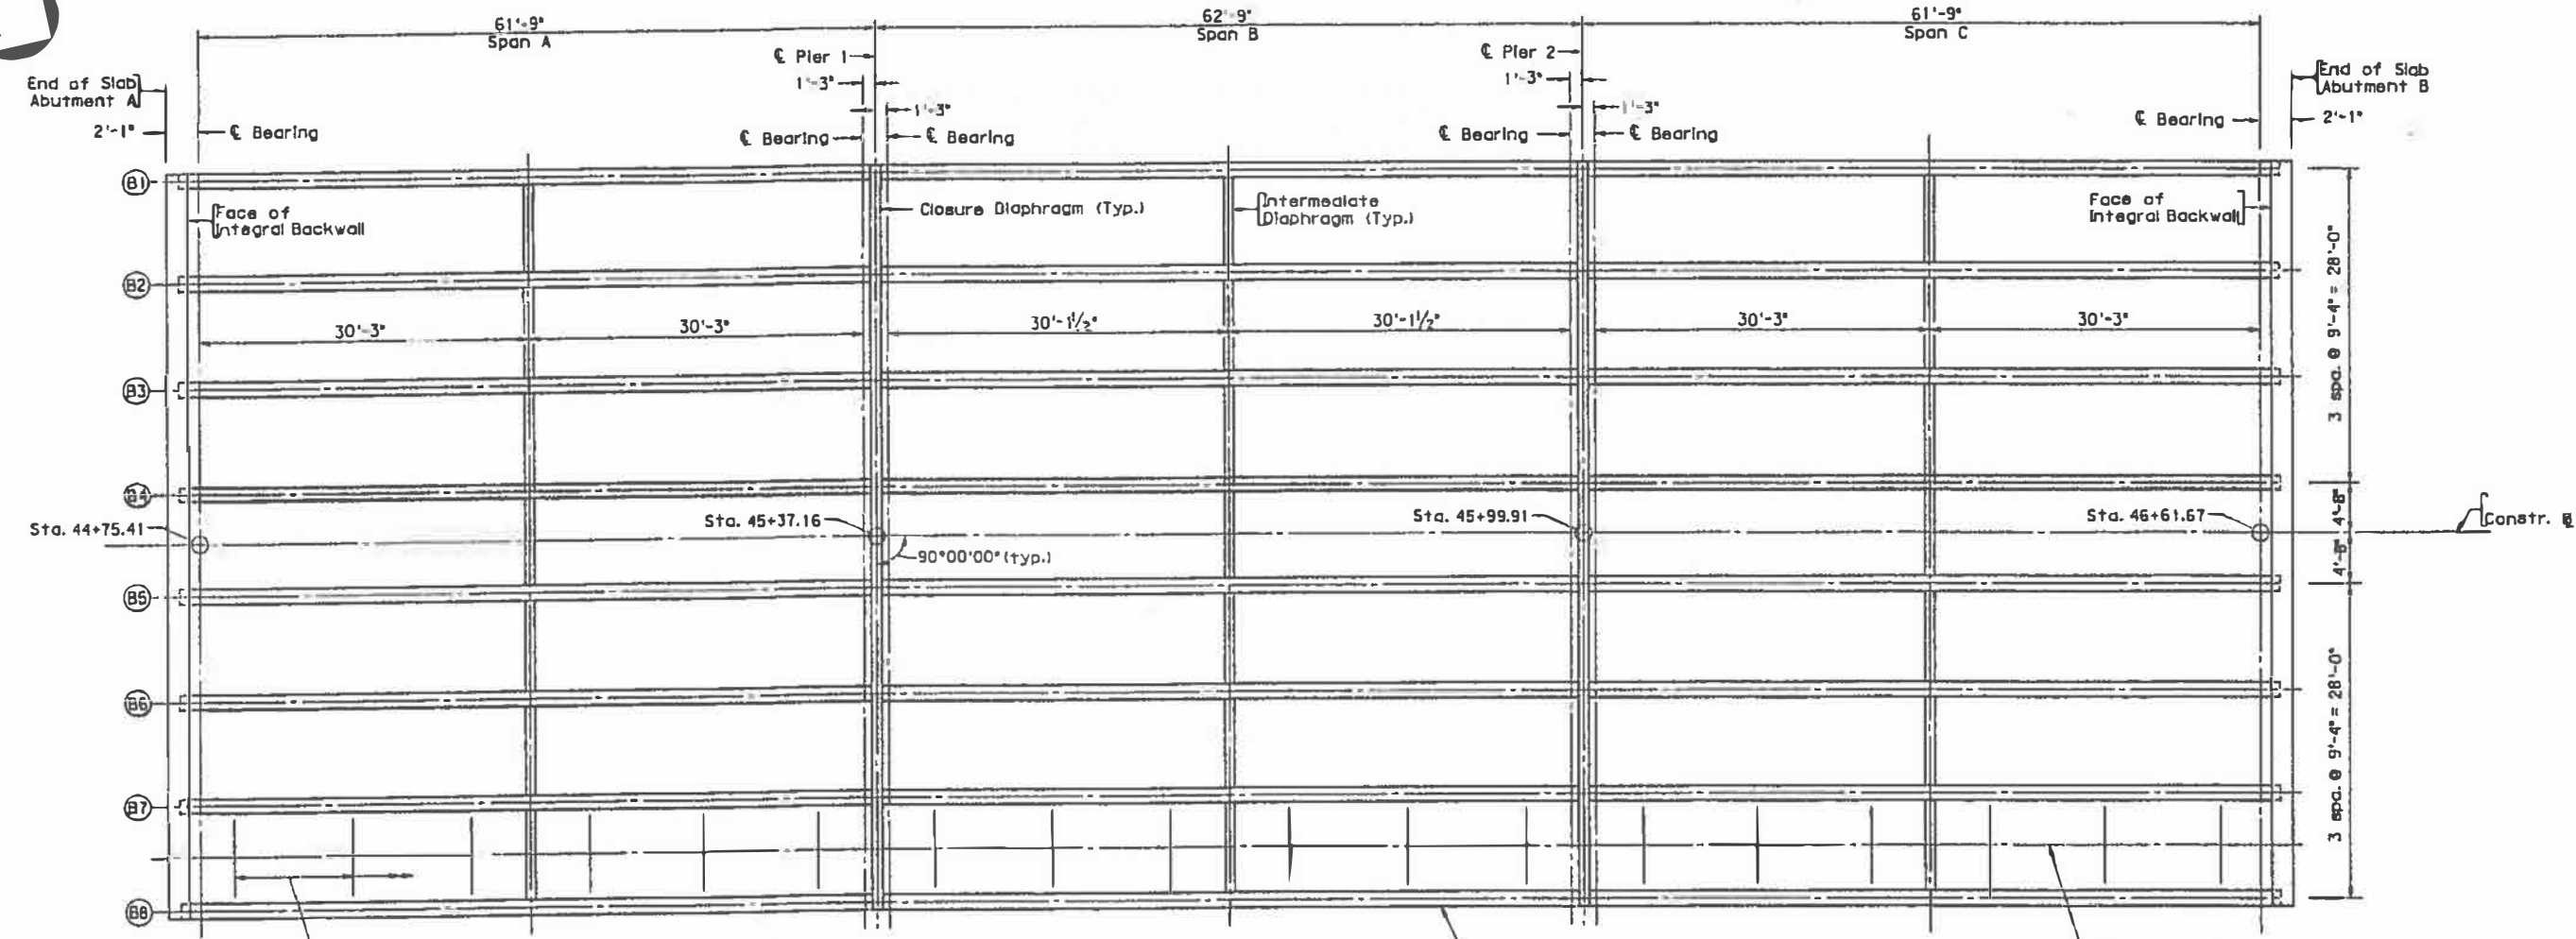

ERECTION DIAGRAM
Scale: 1/8" = 1'-0"


TOP OF SLAB ELEVATIONS ALONG C BEAMS						
Span	Beam	Points				
		1	2	3	4	5
Span A	1	128.65	129.00	129.34	129.65	129.94
	2	128.84	129.16	129.45	129.73	129.98
	3	129.03	129.31	129.57	129.81	130.03
	4	129.22	129.46	129.69	129.90	130.08
	5	129.21	129.44	129.65	129.84	130.01
	6	129.02	129.25	129.46	129.65	129.81
	7	128.83	129.05	129.26	129.45	129.62
	8	128.63	128.86	129.07	129.26	129.43
Span B	1	129.98	130.25	130.50	130.72	130.93
	2	130.03	130.26	130.47	130.66	130.83
	3	130.07	130.26	130.44	130.60	130.74
	4	130.11	130.27	130.41	130.54	130.64
	5	130.03	130.18	130.30	130.41	130.49
	6	129.84	129.98	130.11	130.21	130.30
	7	129.65	129.79	129.91	130.02	130.10
	8	129.45	129.60	129.72	129.83	129.91
Span C	1	130.96	131.15	131.32	131.46	131.59
	2	130.86	131.01	131.14	131.25	131.34
	3	130.76	130.87	130.97	131.04	131.10
	4	130.65	130.73	130.79	130.83	130.85
	5	130.51	130.57	130.61	130.62	130.61
	6	130.31	130.37	130.41	130.41	130.36
	7	130.12	130.18	130.22	130.20	130.12
	8	129.92	129.98	130.03	129.99	129.87

TABLE OF MOMENTS, SHEARS AND STRESSES																											
Location		Live Load + I (Service Load)		Non-Composite DL (Service Load)		Composite DL (Service Load)		Release Stress at 0.4 L		Final Stress (Pos. Mom.)**				Final Stress (Neg. Mom.)													
		Max. M	Max. V	Max. M	Max. V	Max. M	Max. V	Top	Bottom	P/S+DL+LL		P/S+DL															
		k-ft	k	k-ft	k	k-ft	k	psi	psi	psi	psi	psi	psi	psi	psi												
Span A & C														-286.2	2092.5												
CL Brg. Abut A	Interior Beam	72.8	58.4	0.0	54.0	12.4	9.8			-60.8	626.5	-77.8	707.4	-242.2	1489.3	-118.4	900.4										
	Exterior Beam	52.1	41.8	0.0	47.3	10.2	8.0			-61.9	644.5	-77.1	703.6	-229.4	1295.9	-118.7	865.5										
Midspan	Interior Beam	682.3	33.7	840.4	1.5	116.3	2.9			1358.8	-210.1	1199.5	547.7	1157.6	746.7	1199.5	547.7										
	Exterior Beam	488.2	24.1	726.4	0.7	95.5	2.3			1079.6	216.5	937.2	770.3	899.7	915.8	937.2	770.3										
CL Brg. Pier 1	Interior Beam	-530.3	69.5	0.0	56.1	-161.3	15.5			-60.8	626.5	-77.8	707.4	-242.2	1489.3	-118.4	900.4										
	Exterior Beam	-379.5	49.8	0.0	48.3	-132.4	12.7			-61.9	644.5	-77.1	703.6	-229.4	1295.9	-118.7	865.5										
Span B														-291.2	2096.4												
CL Brg. Pier 1	Interior Beam	-480.6	63.3	0.0	53.9	-145.2	12.6			-94.0	783.2	-114.4	880.0	-226.6	1413.9	-114.4	880.0										
	Exterior Beam	-343.9	45.3	0.0	47.1	-119.3	10.3			-96.5	777.6	-114.6	848.3	-215.0	1238.5	-114.6	848.3										
Midspan	Interior Beam	588.5	26.7	833.7	1.5	43.8	0.0			1307.0	-20.9	1169.6	632.7	1117.9	878.5	1169.6	632.7										
	Exterior Beam	421.1	19.1	720.5	0.8	36.0	0.0			1031.2	364.4	908.4	842.1	862.2	1021.7	908.4	842.1										
CL Brg. Pier 2	Interior Beam	-480.8	63.3	0.0	53.9	-145.2	12.6			-94.0	783.2	-114.4	880.0	-226.6	1413.9	-114.4	880.0										
	Exterior Beam	-344.0	45.3	0.0	47.2	-119.3	10.3			-96.5	777.6	-114.6	848.3	-215.0	1238.5	-114.6	848.3										

Note:
Spacing of supports for the telephone conduit system is not shown. See telephone conduit for actual spacing.

References:
1. For prestressed girder details, see sheet
2. For diaphragm details, see sheet 10.
3. For bearing details, see sheet 11.
4. For integral backwall details, see sheets 6
5. For telephone conduit details, see sheet

* Maximum Moments at End Spans may not be at midspan.
** Positive Moment does not include creep and shrinkage.

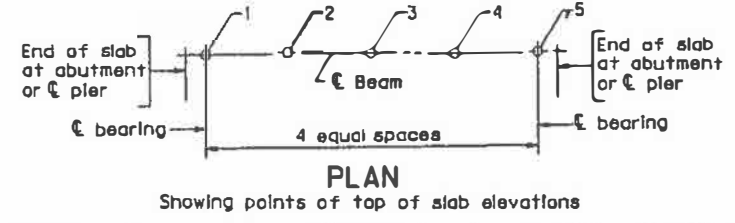

STRUCTURE AND BRIDGE DIV.					
ERECTION DIAGR.					
No.	Description	Date	Designed:	Date	Plan No.
Revisions			Checked:		