
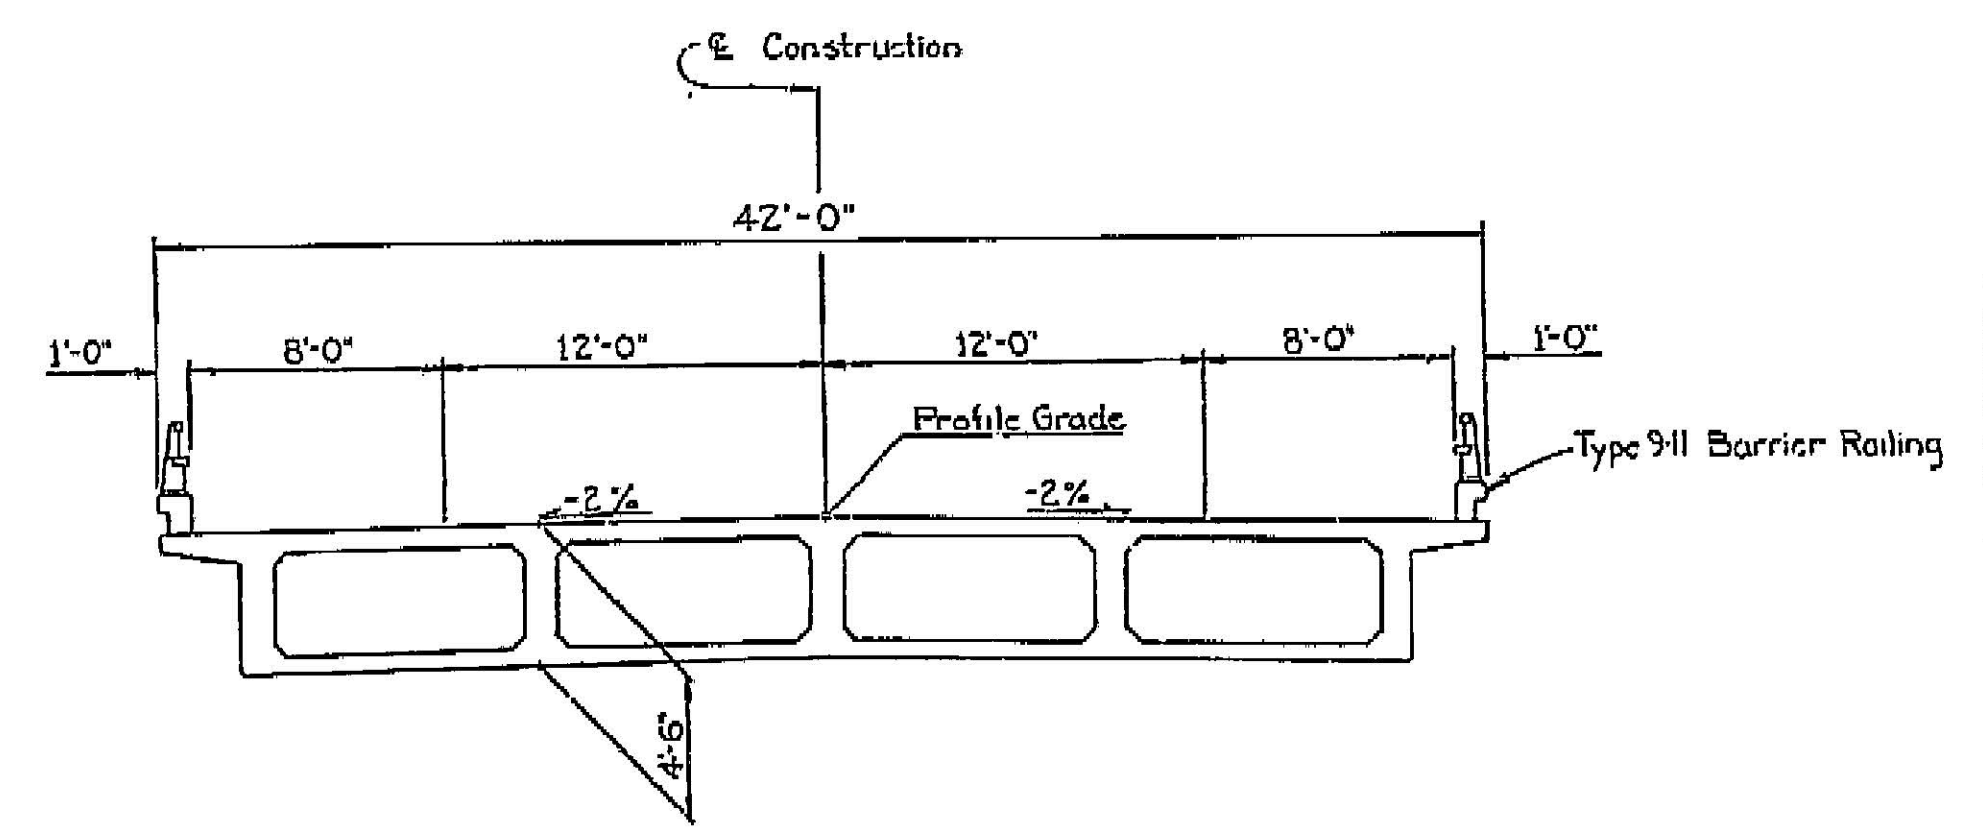


The Bridge As-Built Plans and corresponding BrDR Models are provided for example only and may not represent the modeling techniques used by your agency.

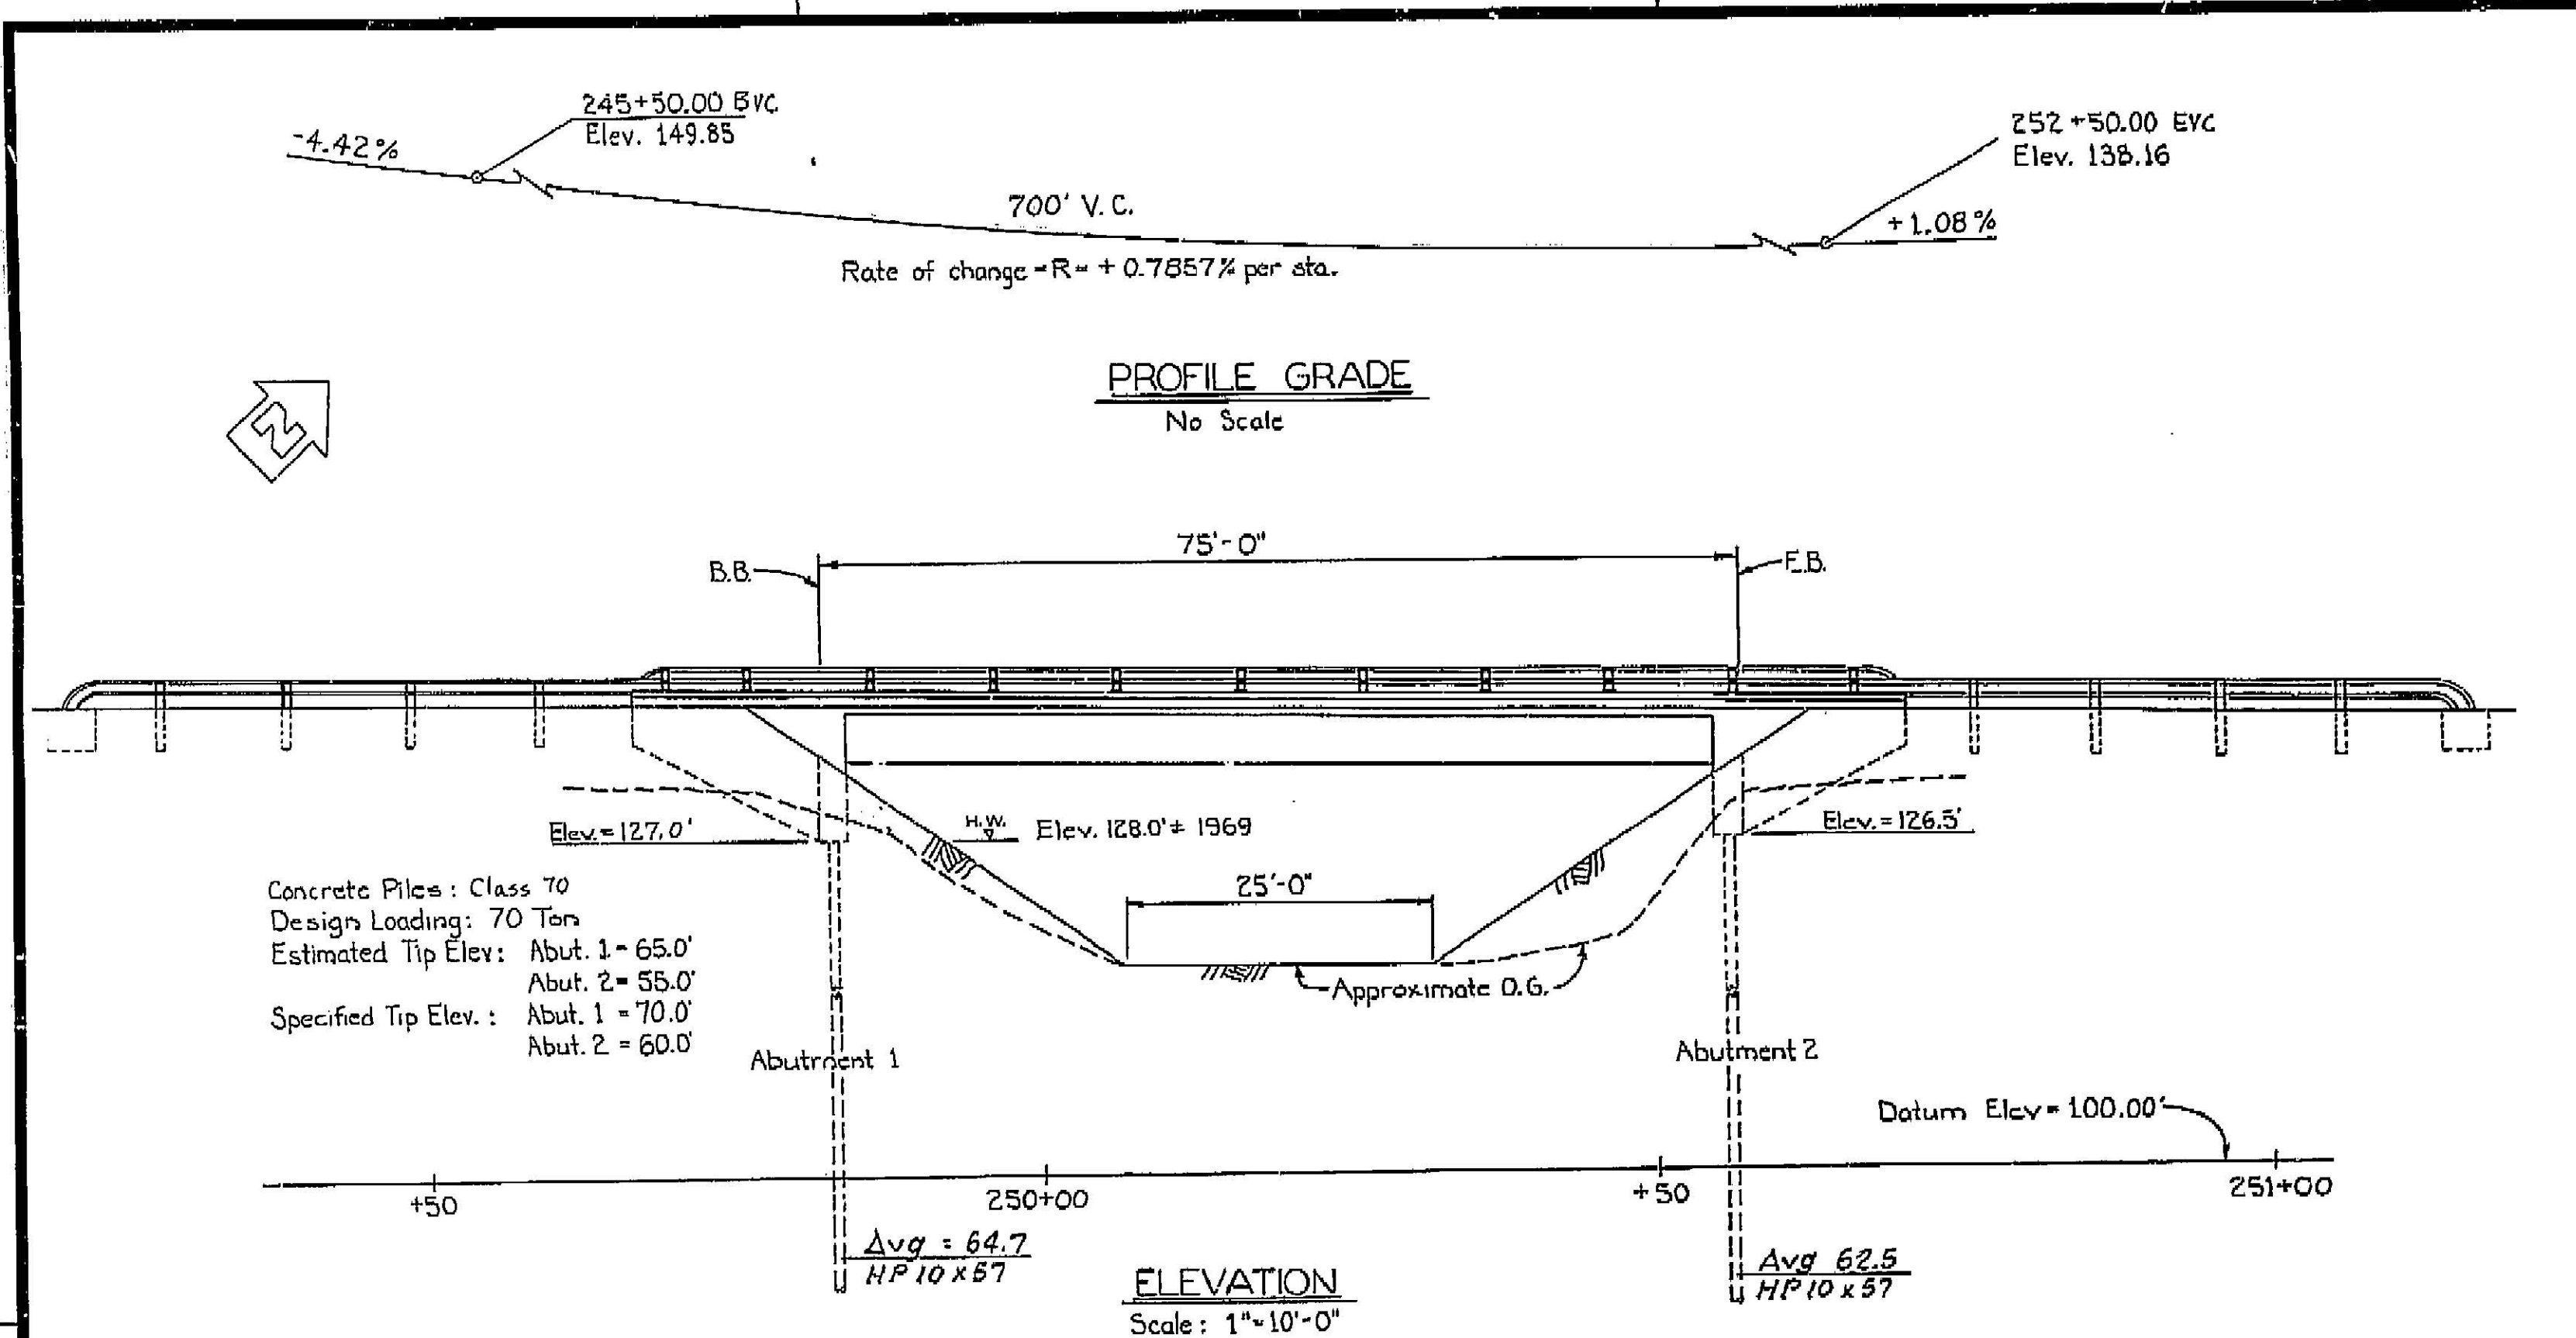


APPROXIMATE QUANTITIES

DESCRIPTION	DRIVE	LUMP SUM	Pay
BRIDGE REMOVAL, LOCATION B	733.8	-820.00	-733.8
FURNISH CONCRETE PILING ( CLASS 70 )			12 EA
DRIVE CONCRETE PILE ( CLASS 70 )			194 LF
BRIDGE APPROACH GUARD RAILING ( TYPE 8 )			210 LF
METAL RAILING ( TYPE 11 )			
FINAL QUANTITIES			
STRUCTURE EXCAVATION ( BRIDGE )			110 CY
STRUCTURE BACKFILL ( BRIDGE )			80 CY
PERVIOUS BACKFILL MATERIAL			10 CY
STRUCTURE CONCRETE, BRIDGE			265 CY
BAR REINFORCING STEEL ( BRIDGE )			65,000 LB

Sheet No.	Title
1	General Plan
2	Foundation Plan
3	Grid Grades and Abutment Details
4	Typical Section
5	Girder Layout and Reinforcement
6	Log of Test Borings

**STANDARD PLANS Dated Jan. 1971**

A35-9	P.C.C. Paving Details and Bridge Approaches
A62-B.2	Ex. and Backfill Bridge & Wall - Limits of Payment
B0-1,3,5	Bridge Details
B2-5	Concrete Pile Details - Class 70
B7-1	Box Girder Details
B11-36,137	Bridge Approach Guard Railing - Type 8
B11-43	Metal Railing Details - Types 9 & 11
B11-45	Barrier Railing - Type 9-11

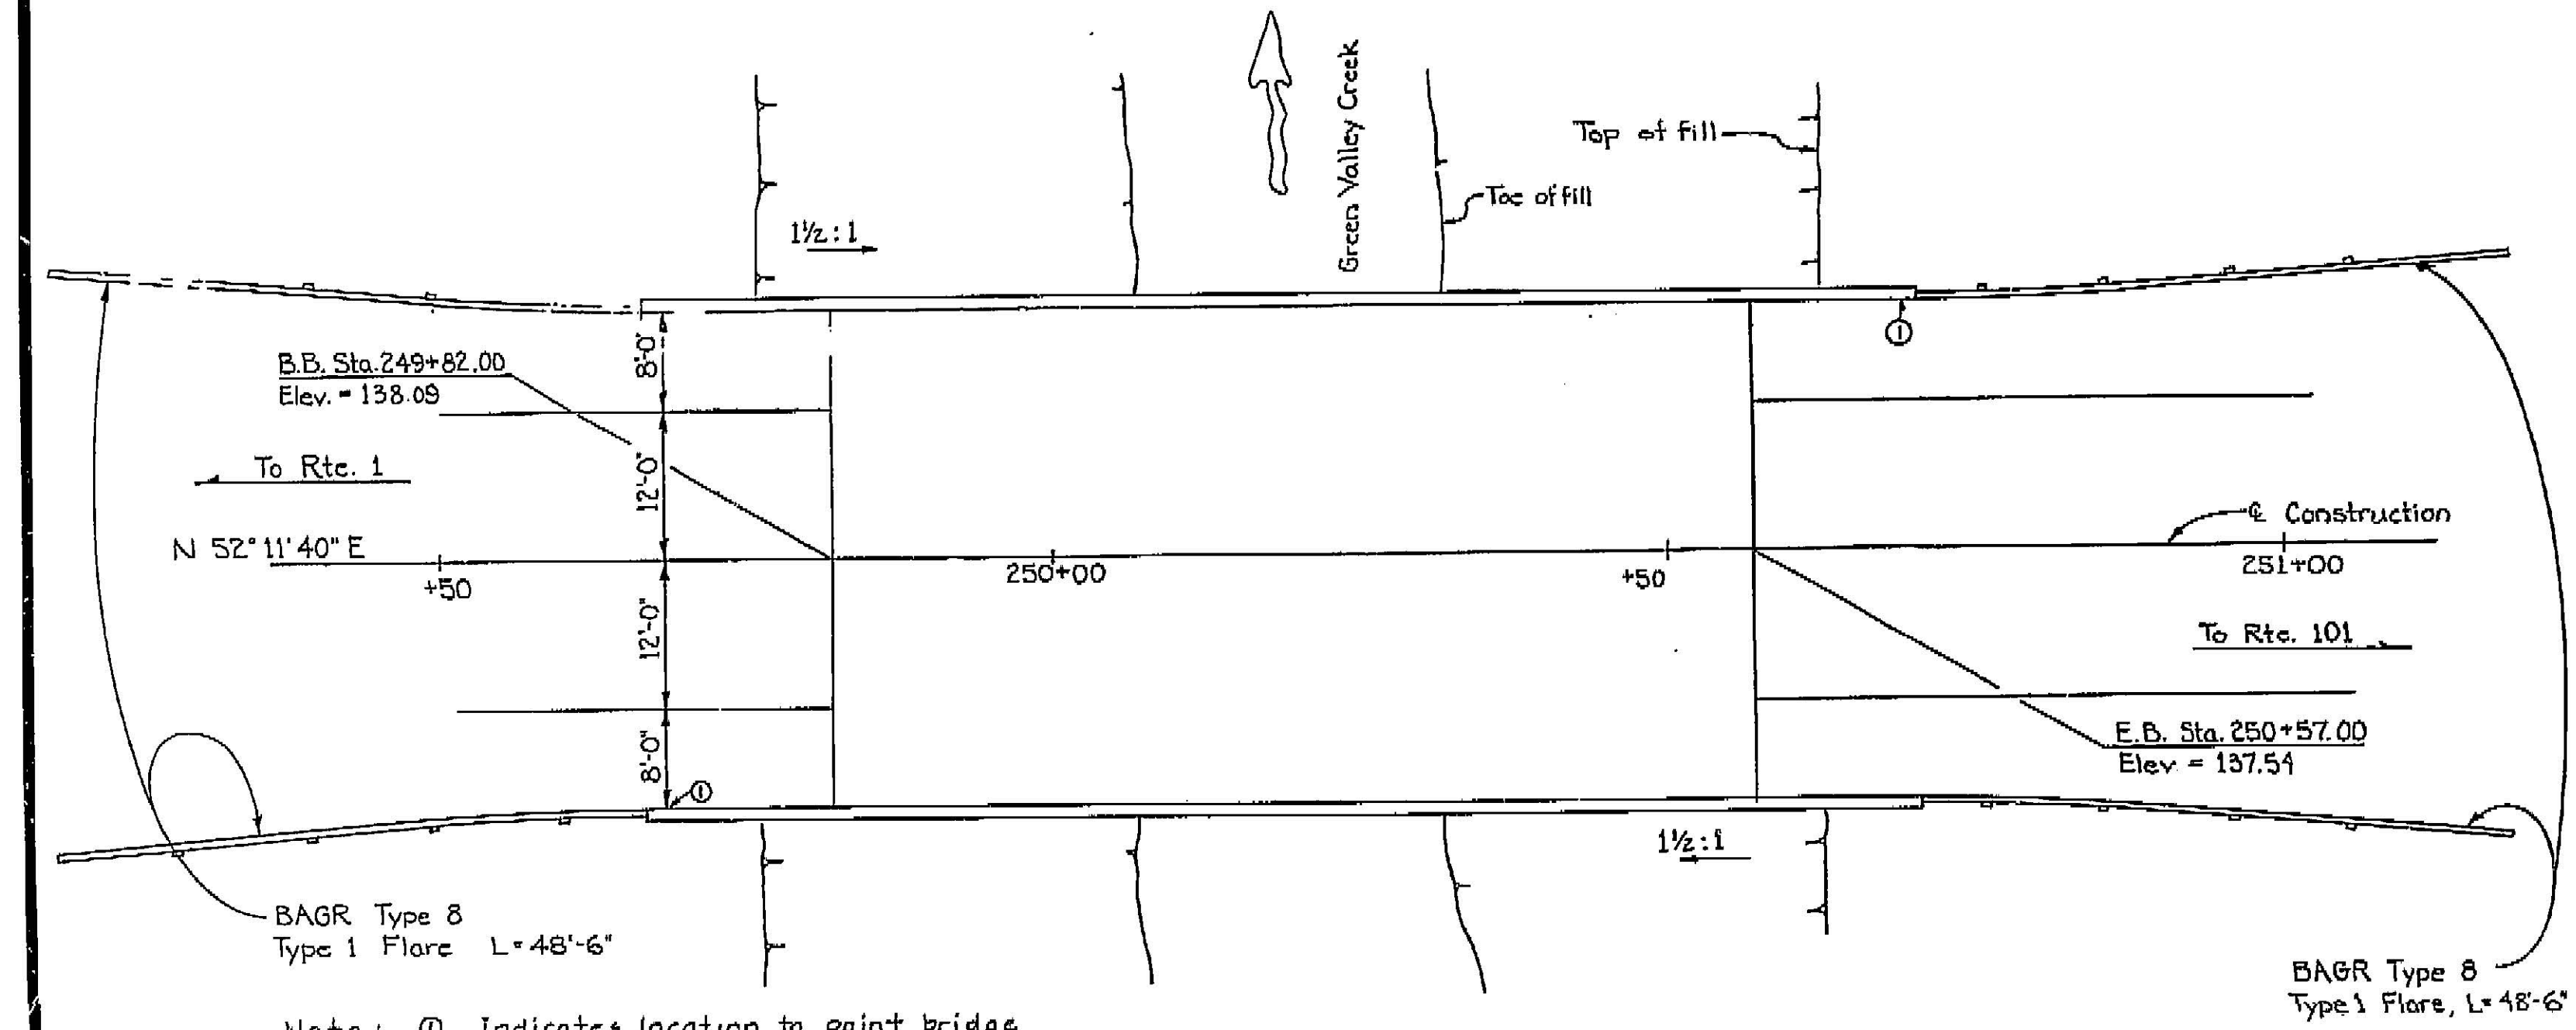

Note: (O) Indicates location to paint bridge name, number and year constructed.

78





GENERAL NOTES


DESIGN: A.A.S.H.O. DATED 1969 WITH REVISIONS AND AS SUPPLEMENTED BY BRIDGE PLANNING AND DESIGN MANUAL.

LIVE LOADING: HS20-44 AND ALTERNATIVE

REINFORCED CONCRETE : F<sub>s</sub> 24,000 PSI, EXCEPT  
20,000 PSI IN TRANSVERSE DECK SLABS AND STIRRUPS

F<sub>c</sub> 1,300 PSI, EXCEPT  
1,200 PSI IN TRANSVERSE DECK SLABS


N 10

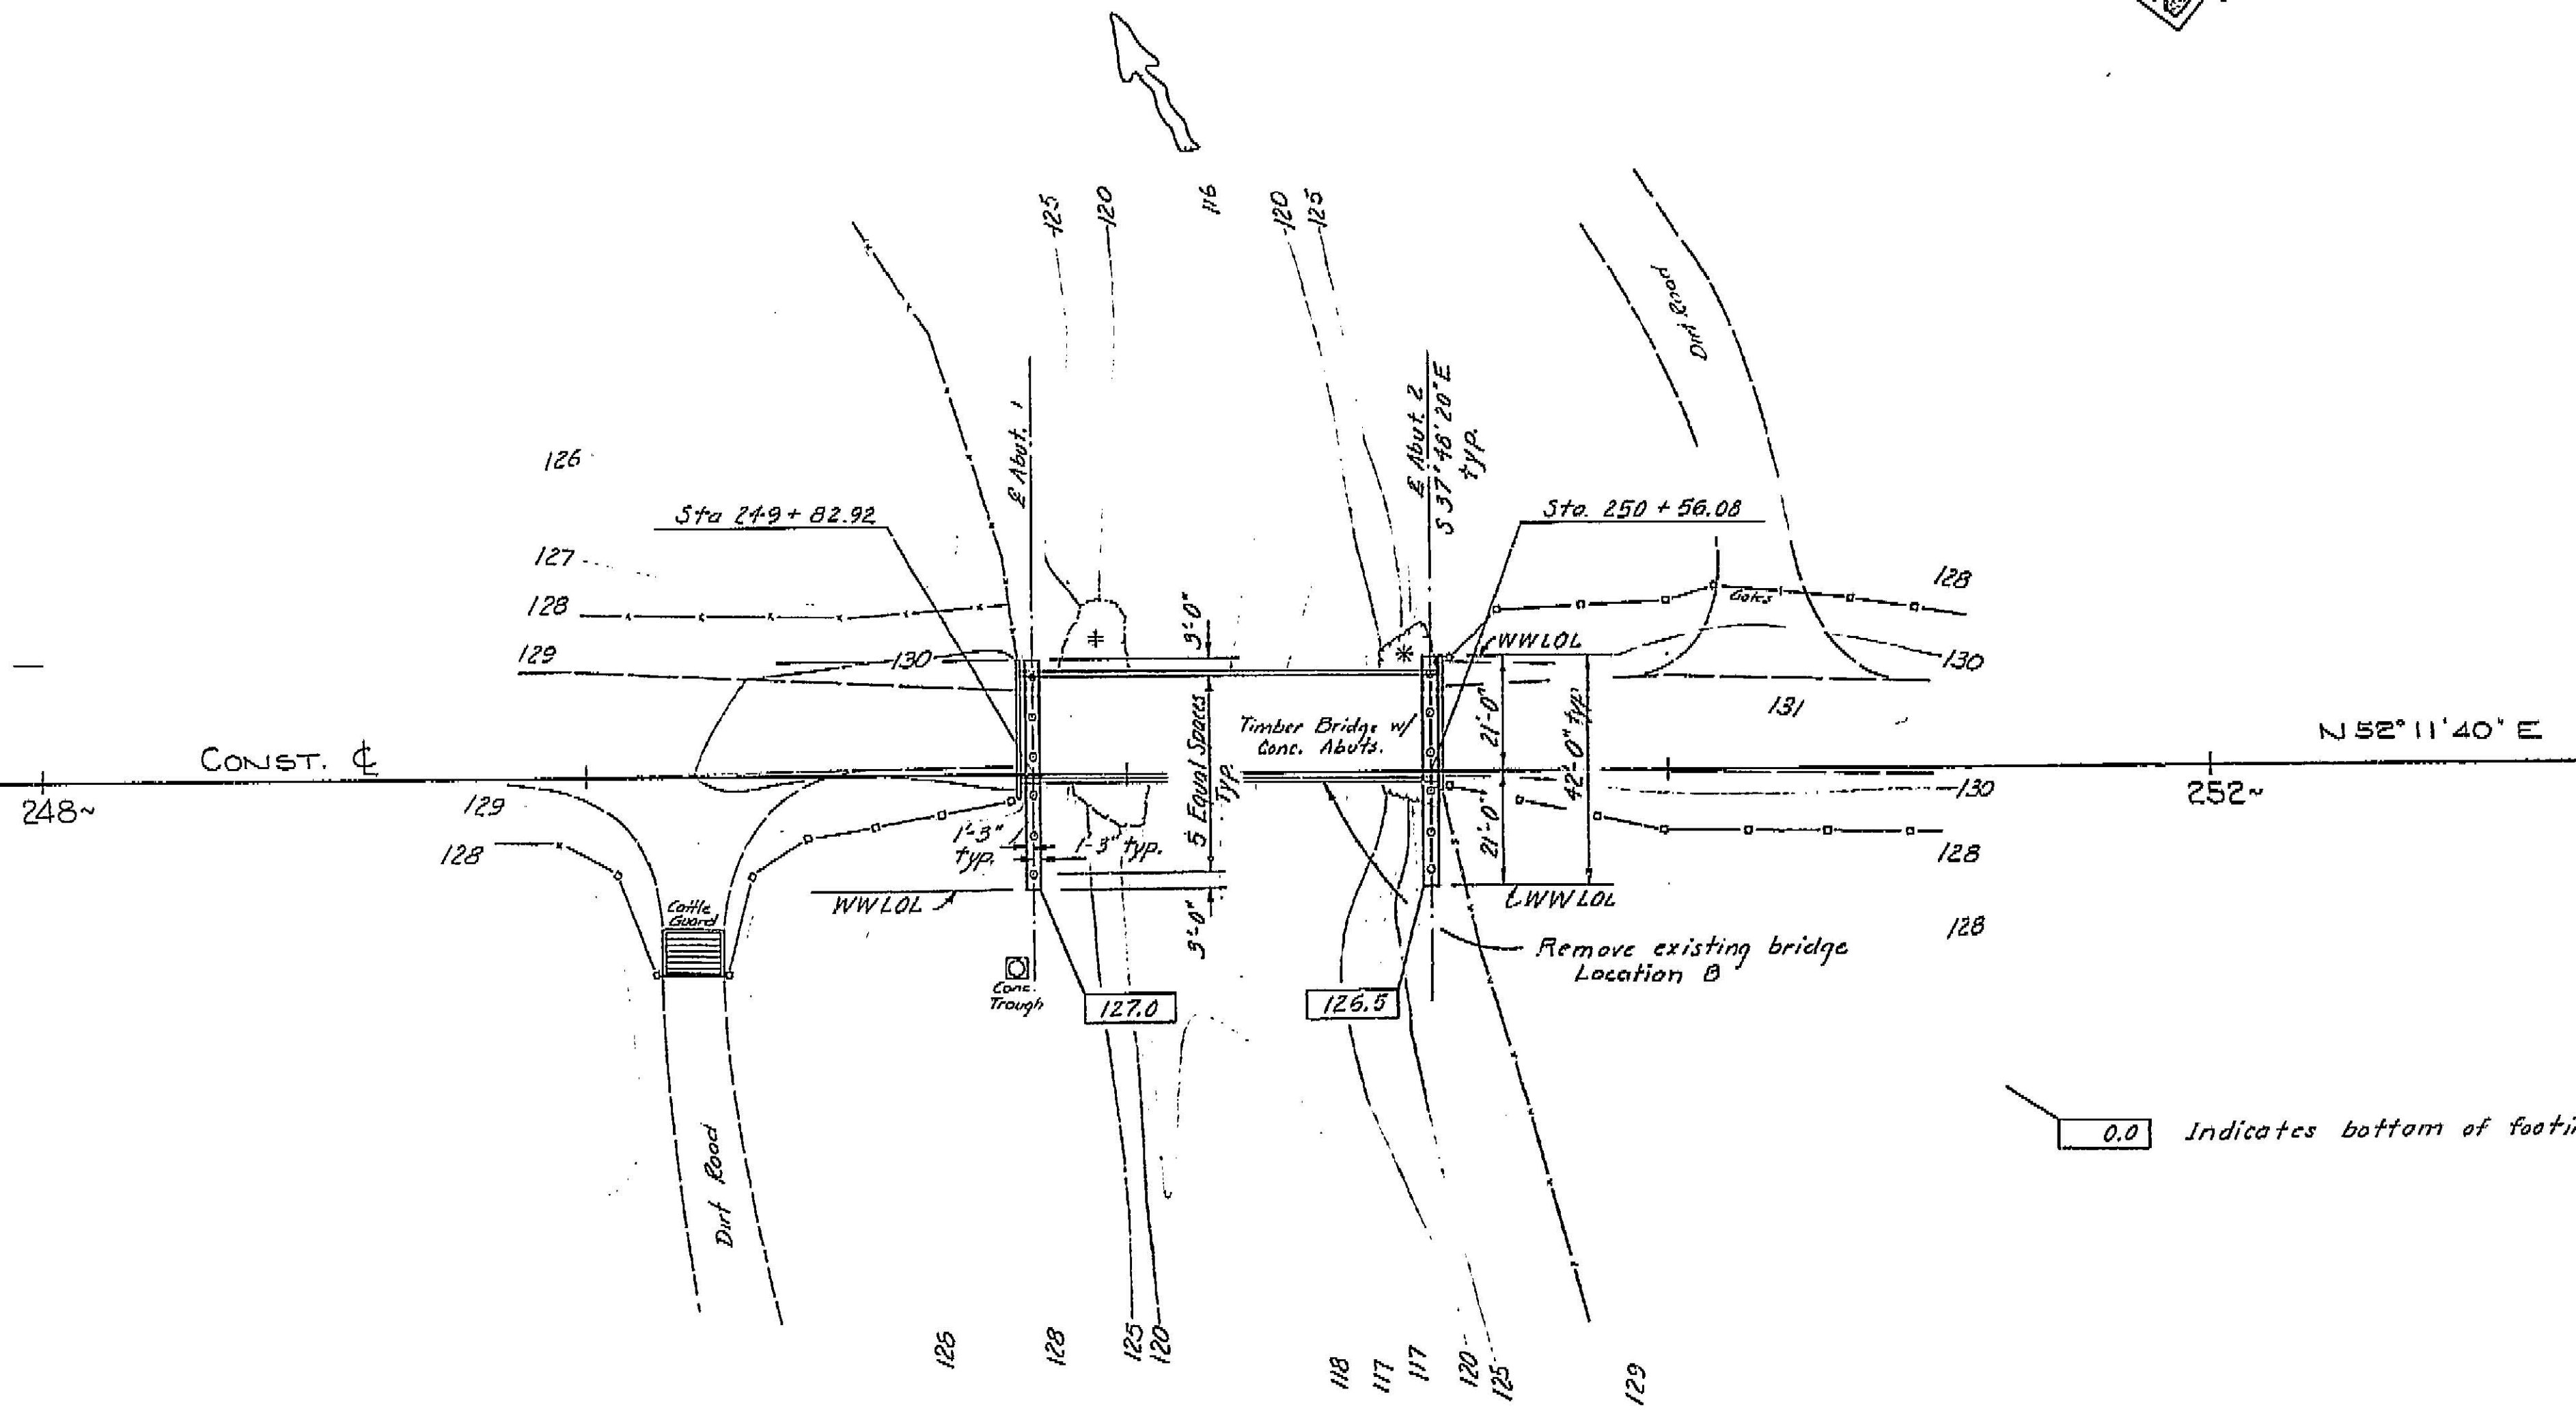


BM 'IP'  
Set on fd. iron pipe  
26' Lt. Const.  $\pm$  257+23  
Elev. 124.06

BM 'A'  
Set chisled sq. @  
upstr end NE abut.  
3' Rt. Const.  $\pm$  250+58  
Elev. 129.89


± Loose rock riprap  
\* Sack conc. riprap

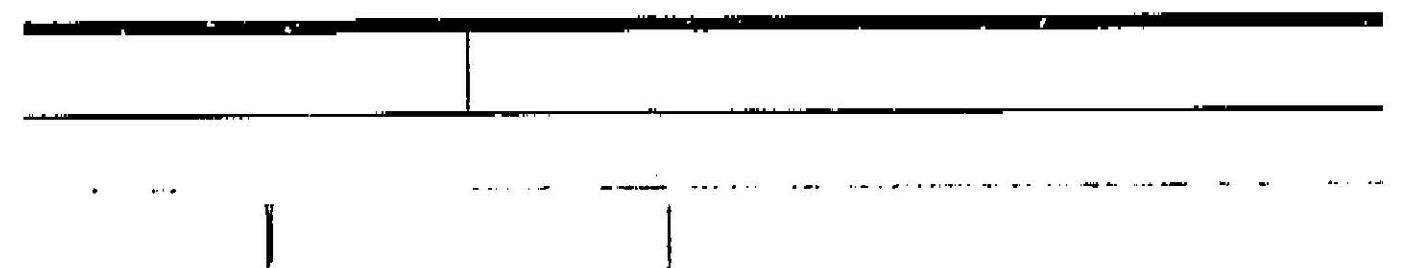

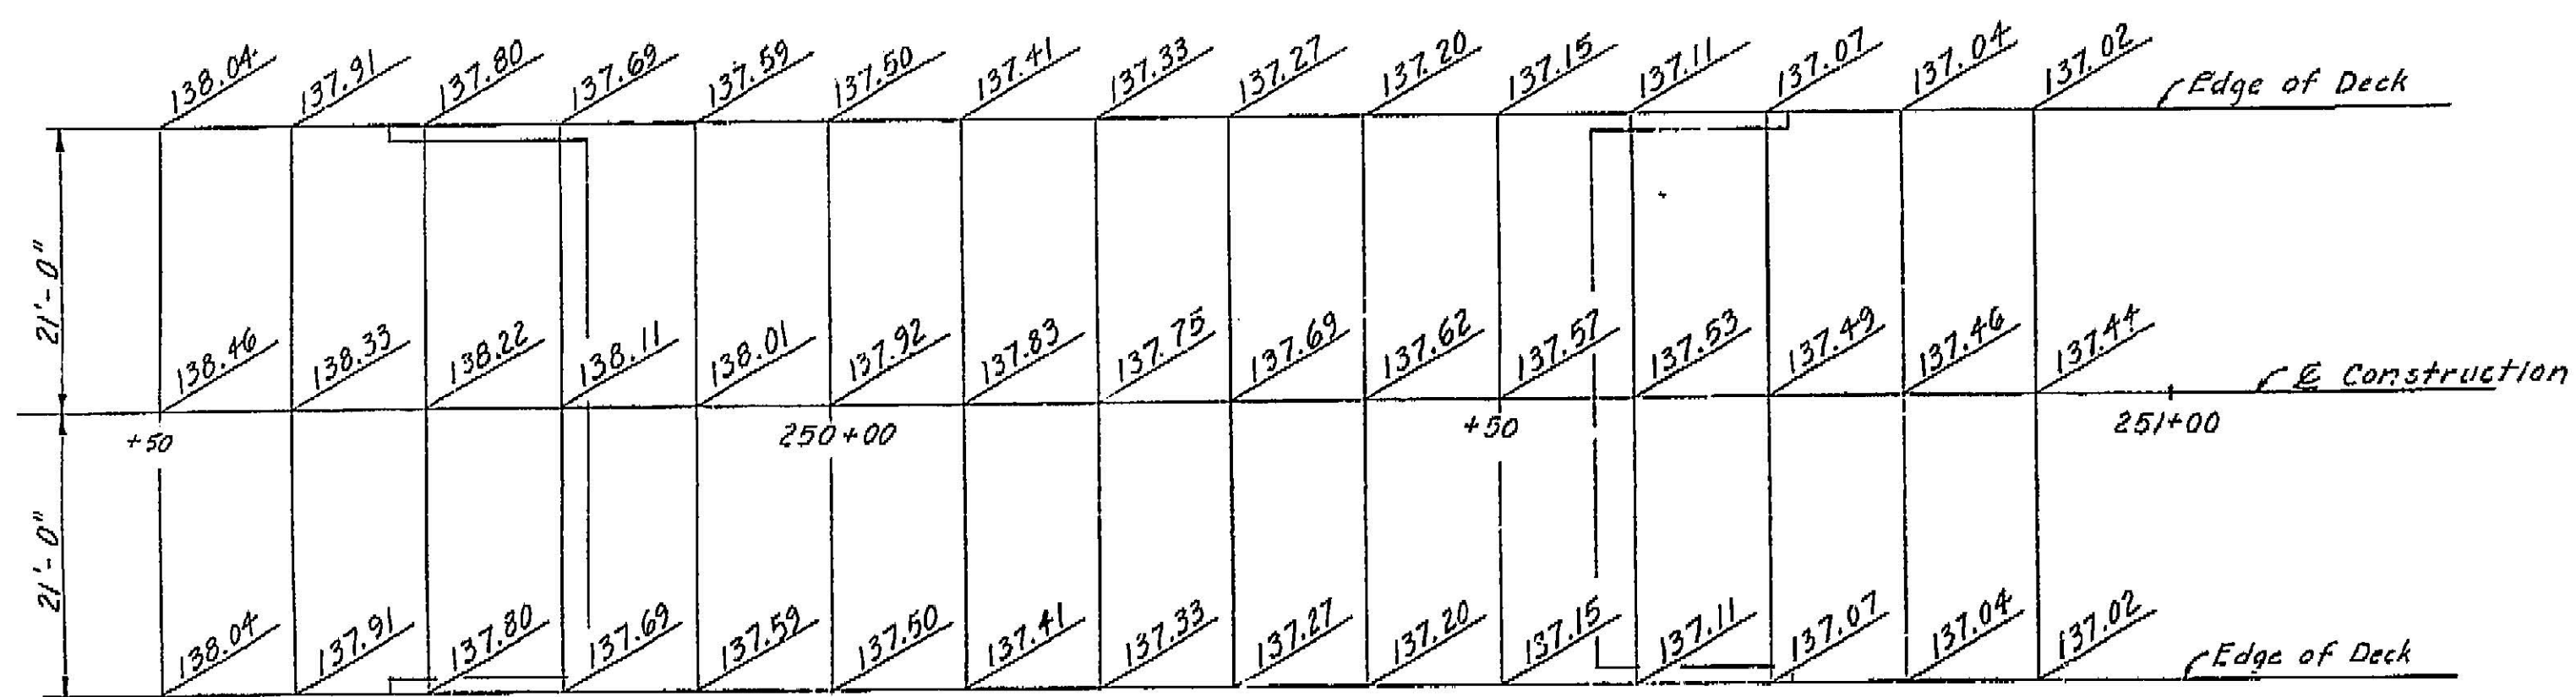


Note: Elevations are at 10' stations along E Construction. These elevations do not include camber.


GRID GRADES  
Scale: 1" = 10'

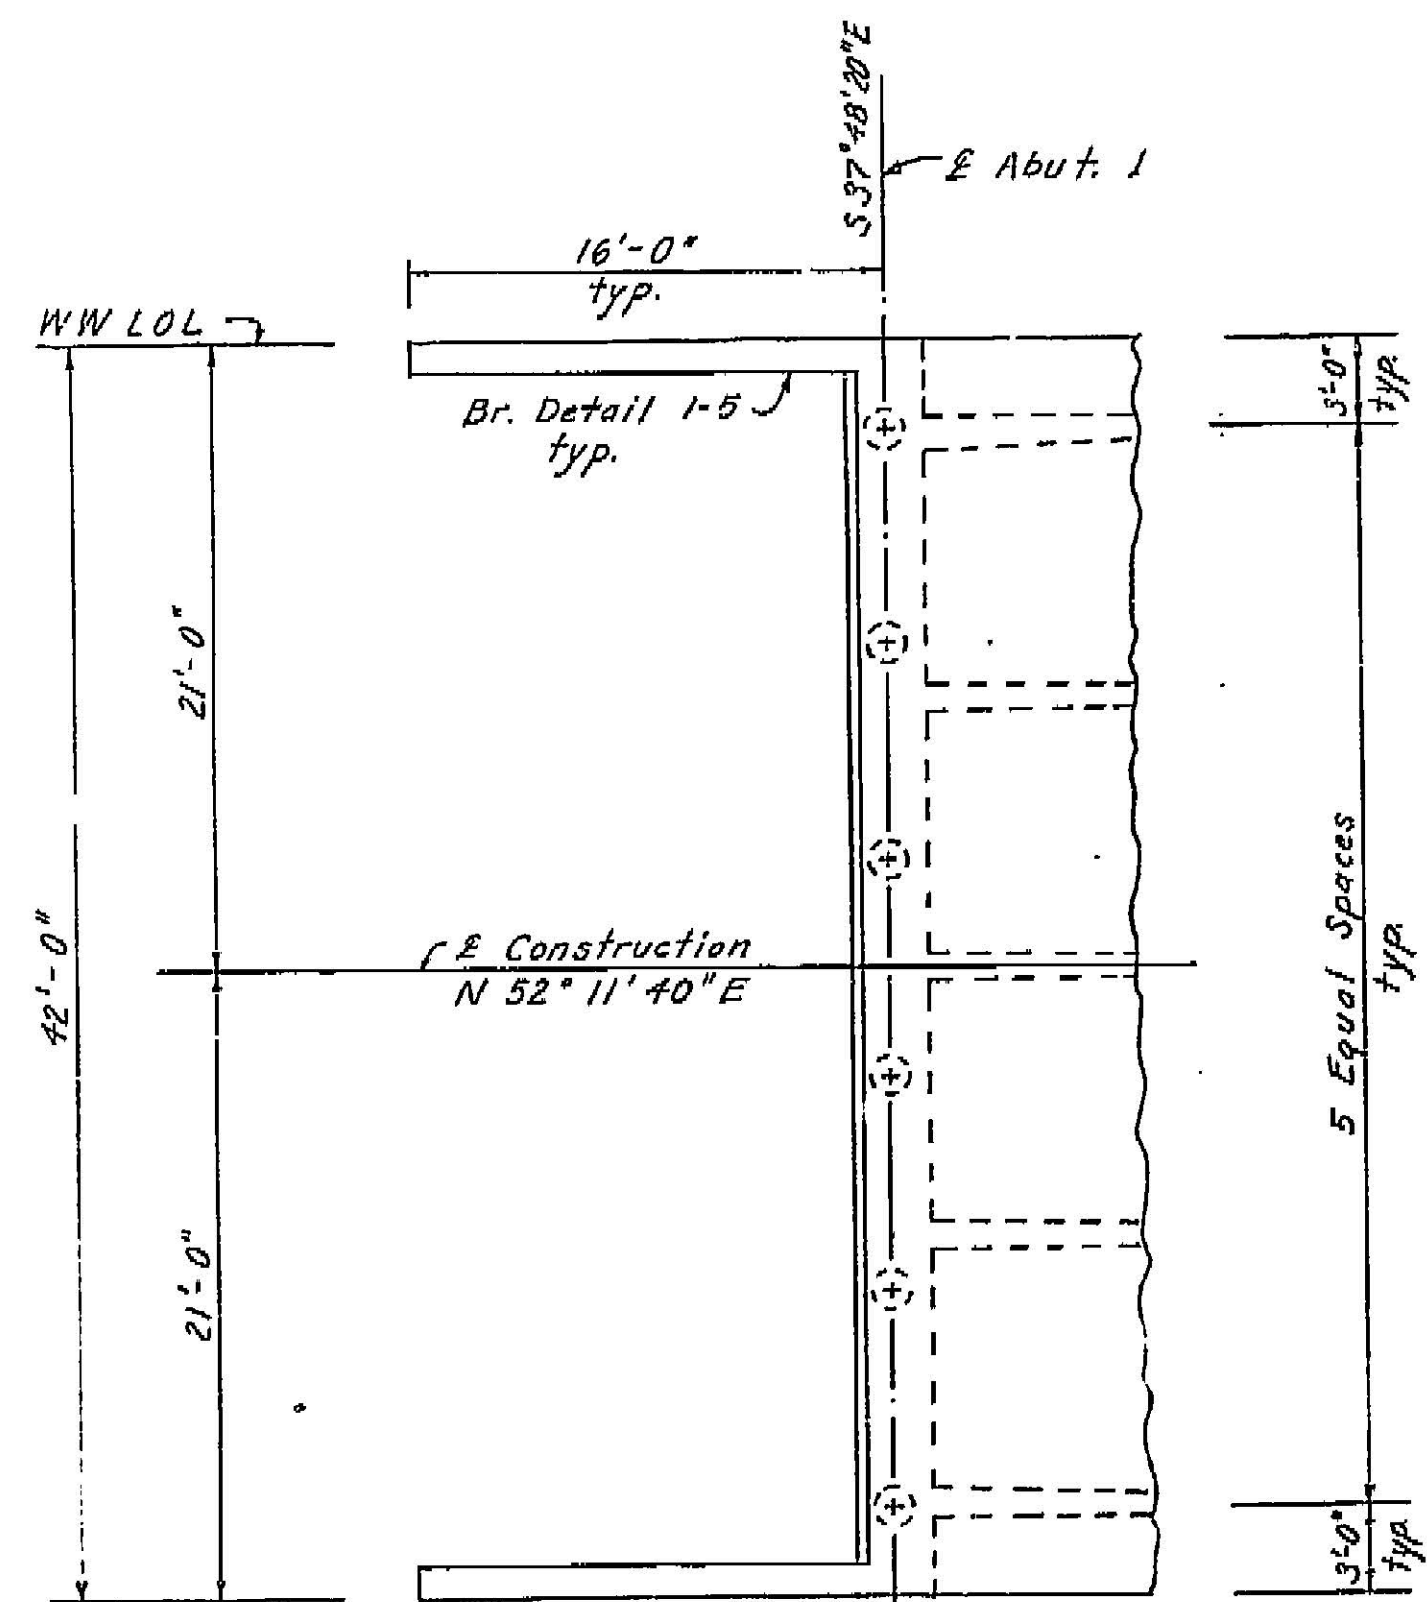

Note: Abut. 1 shown, Abut. 2 similar.

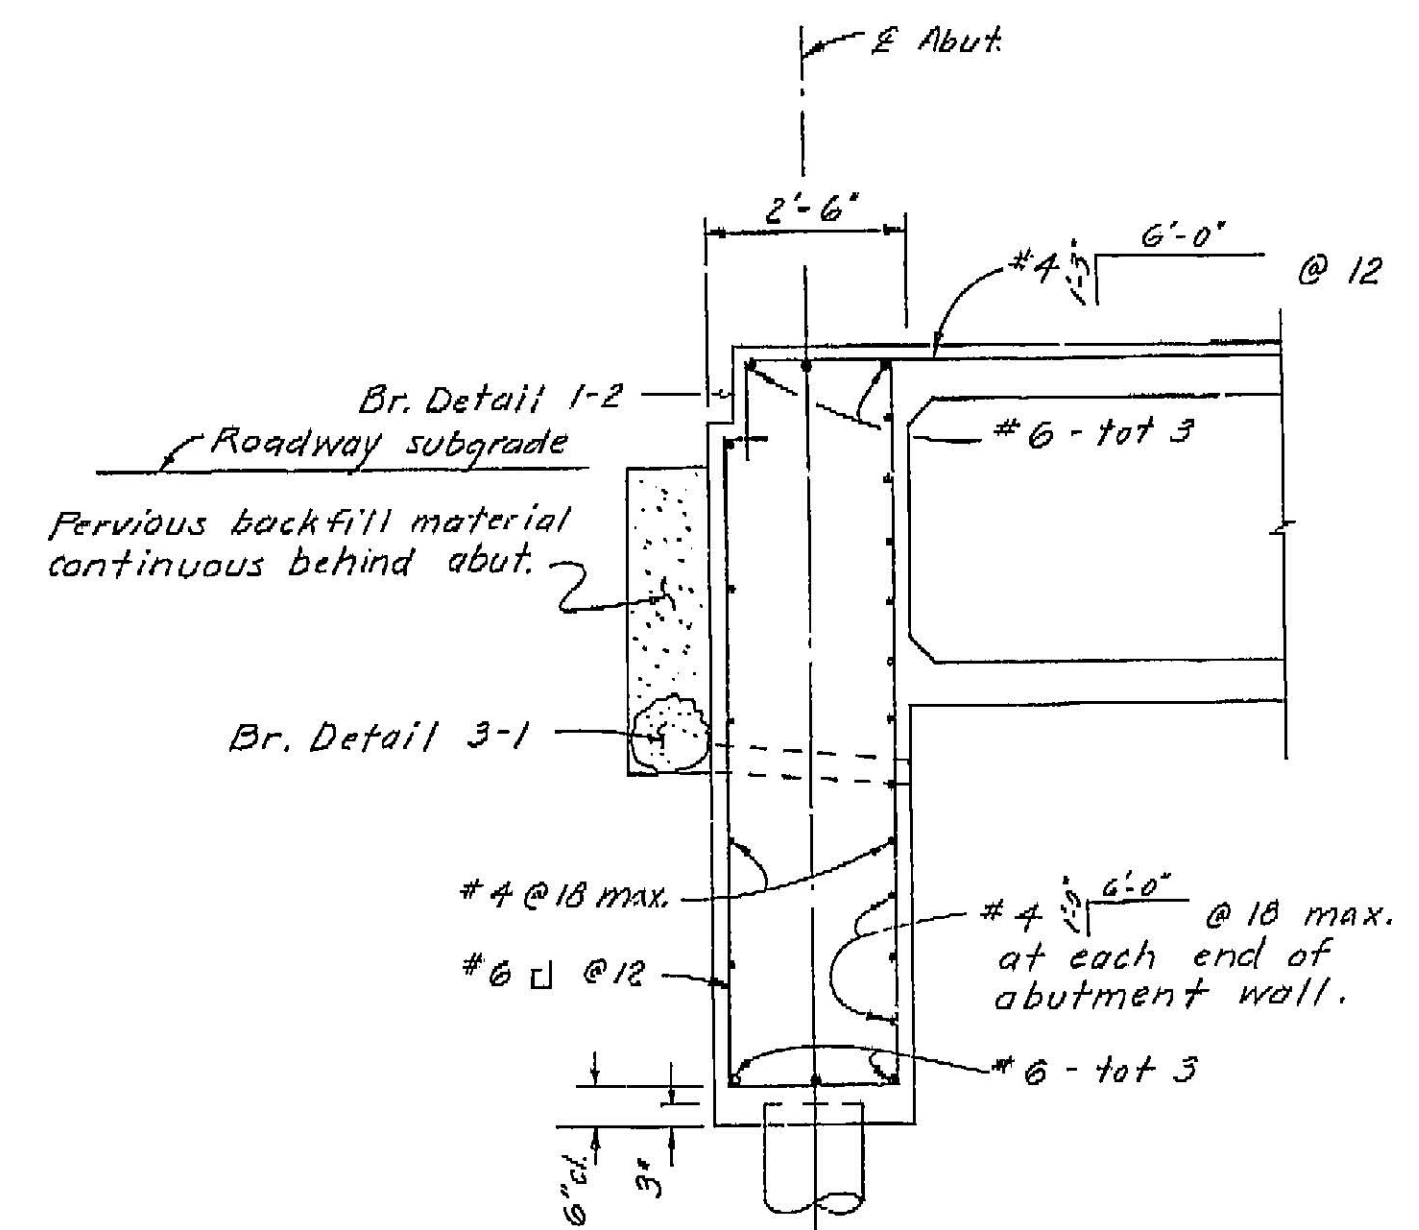



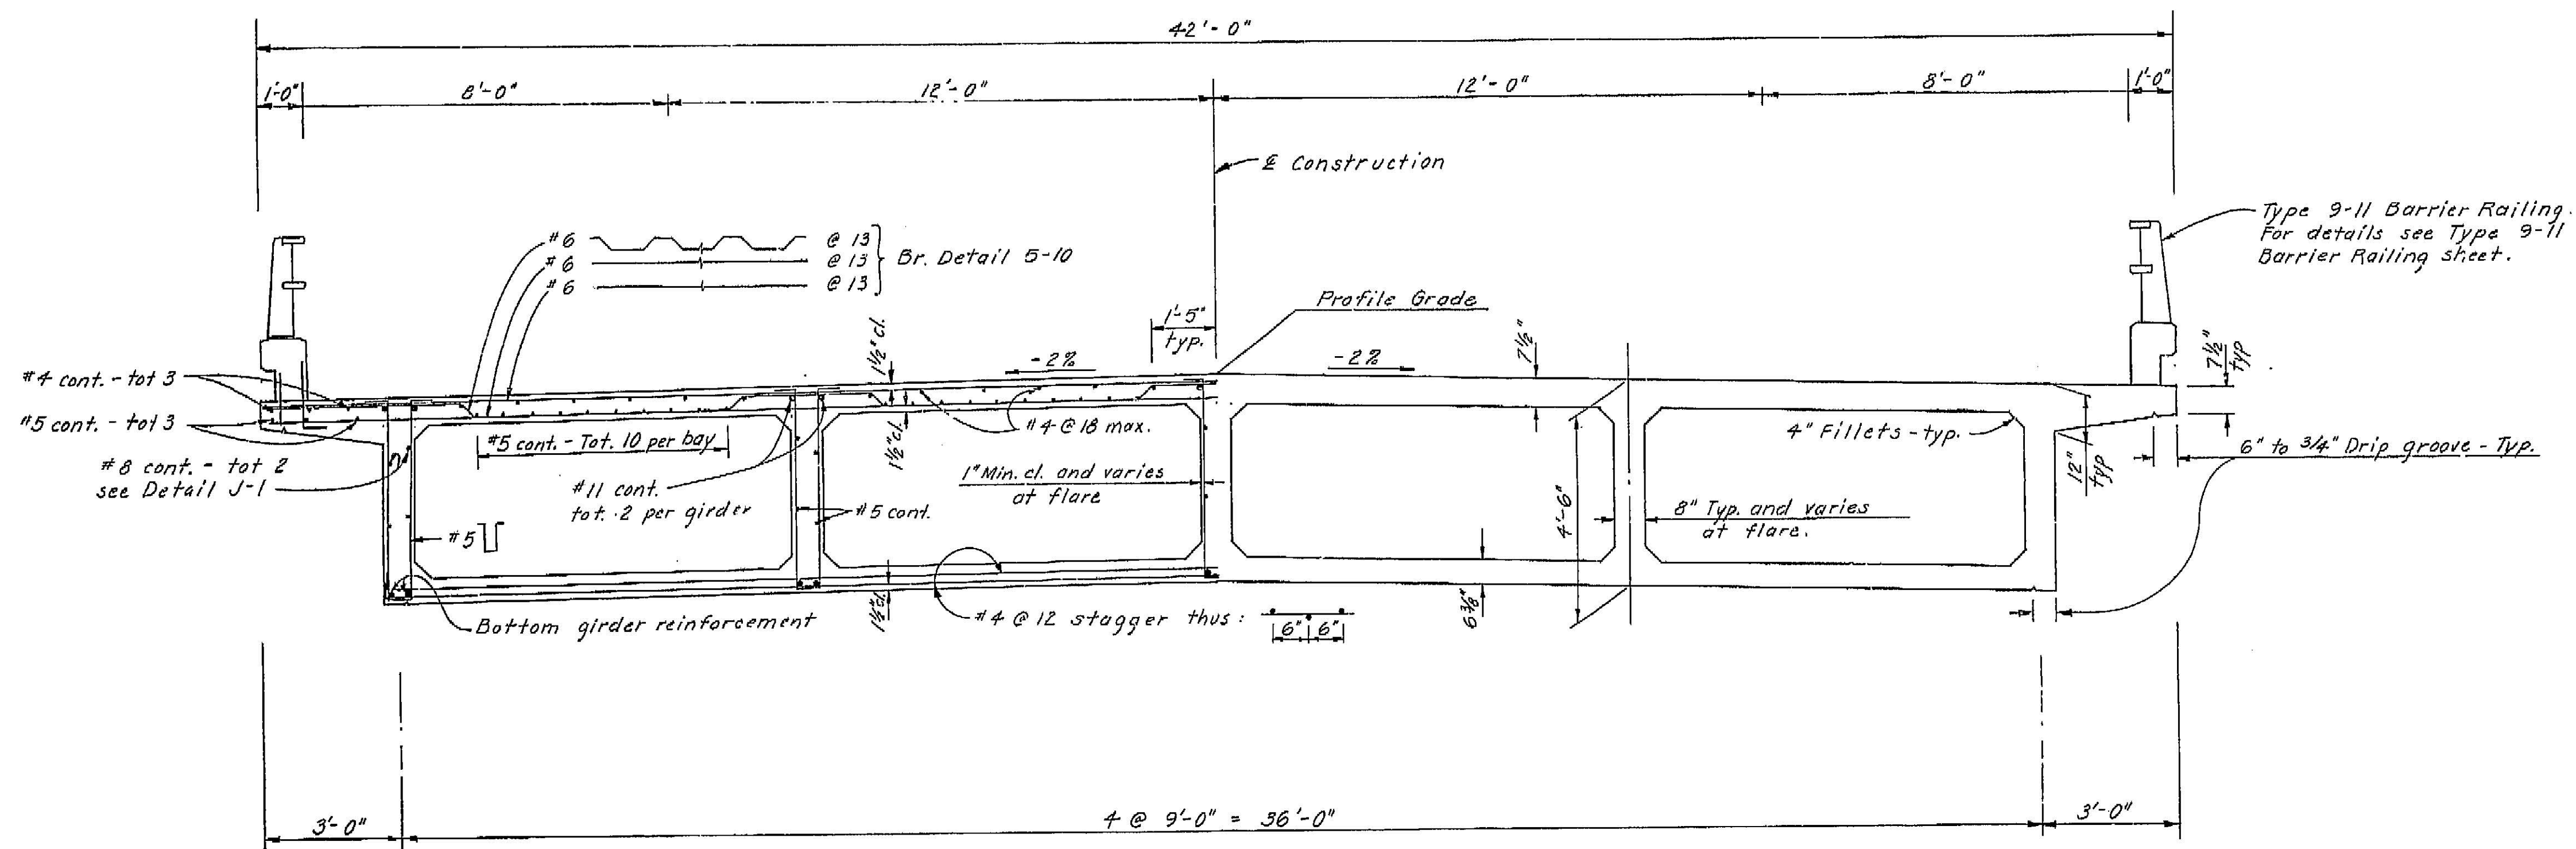


Note: For reinforcement not shown see "Girder Layout & Reinforcement" sheet.


TYPICAL SECTION

Scale: 1/2" = 1'-0"




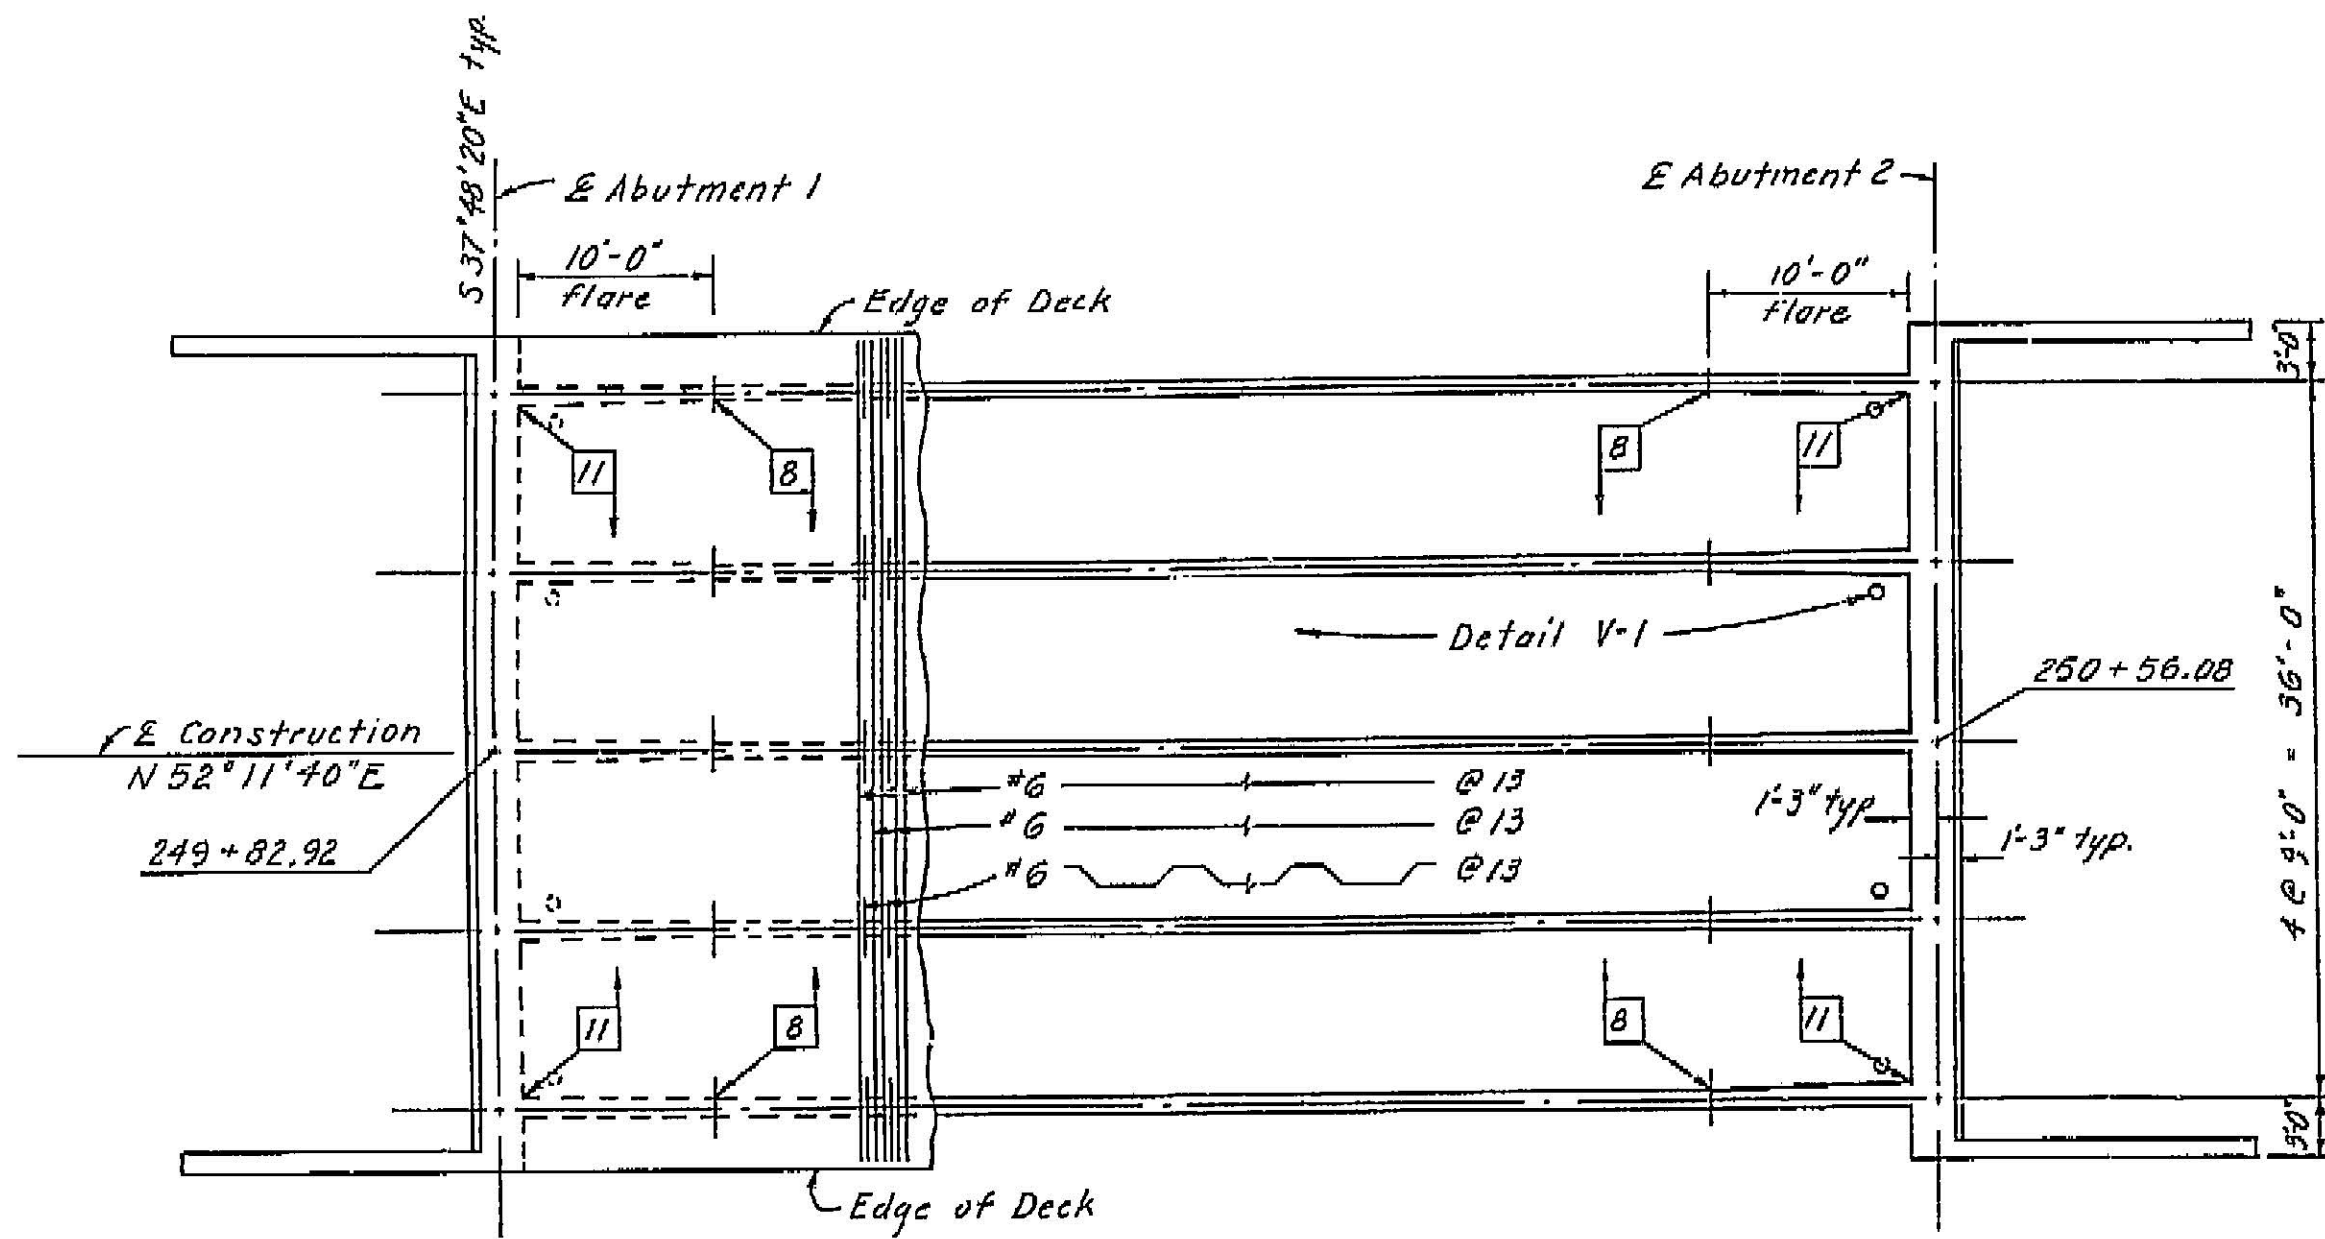


PLAN  
Scale: 1/8" = 1'-0"

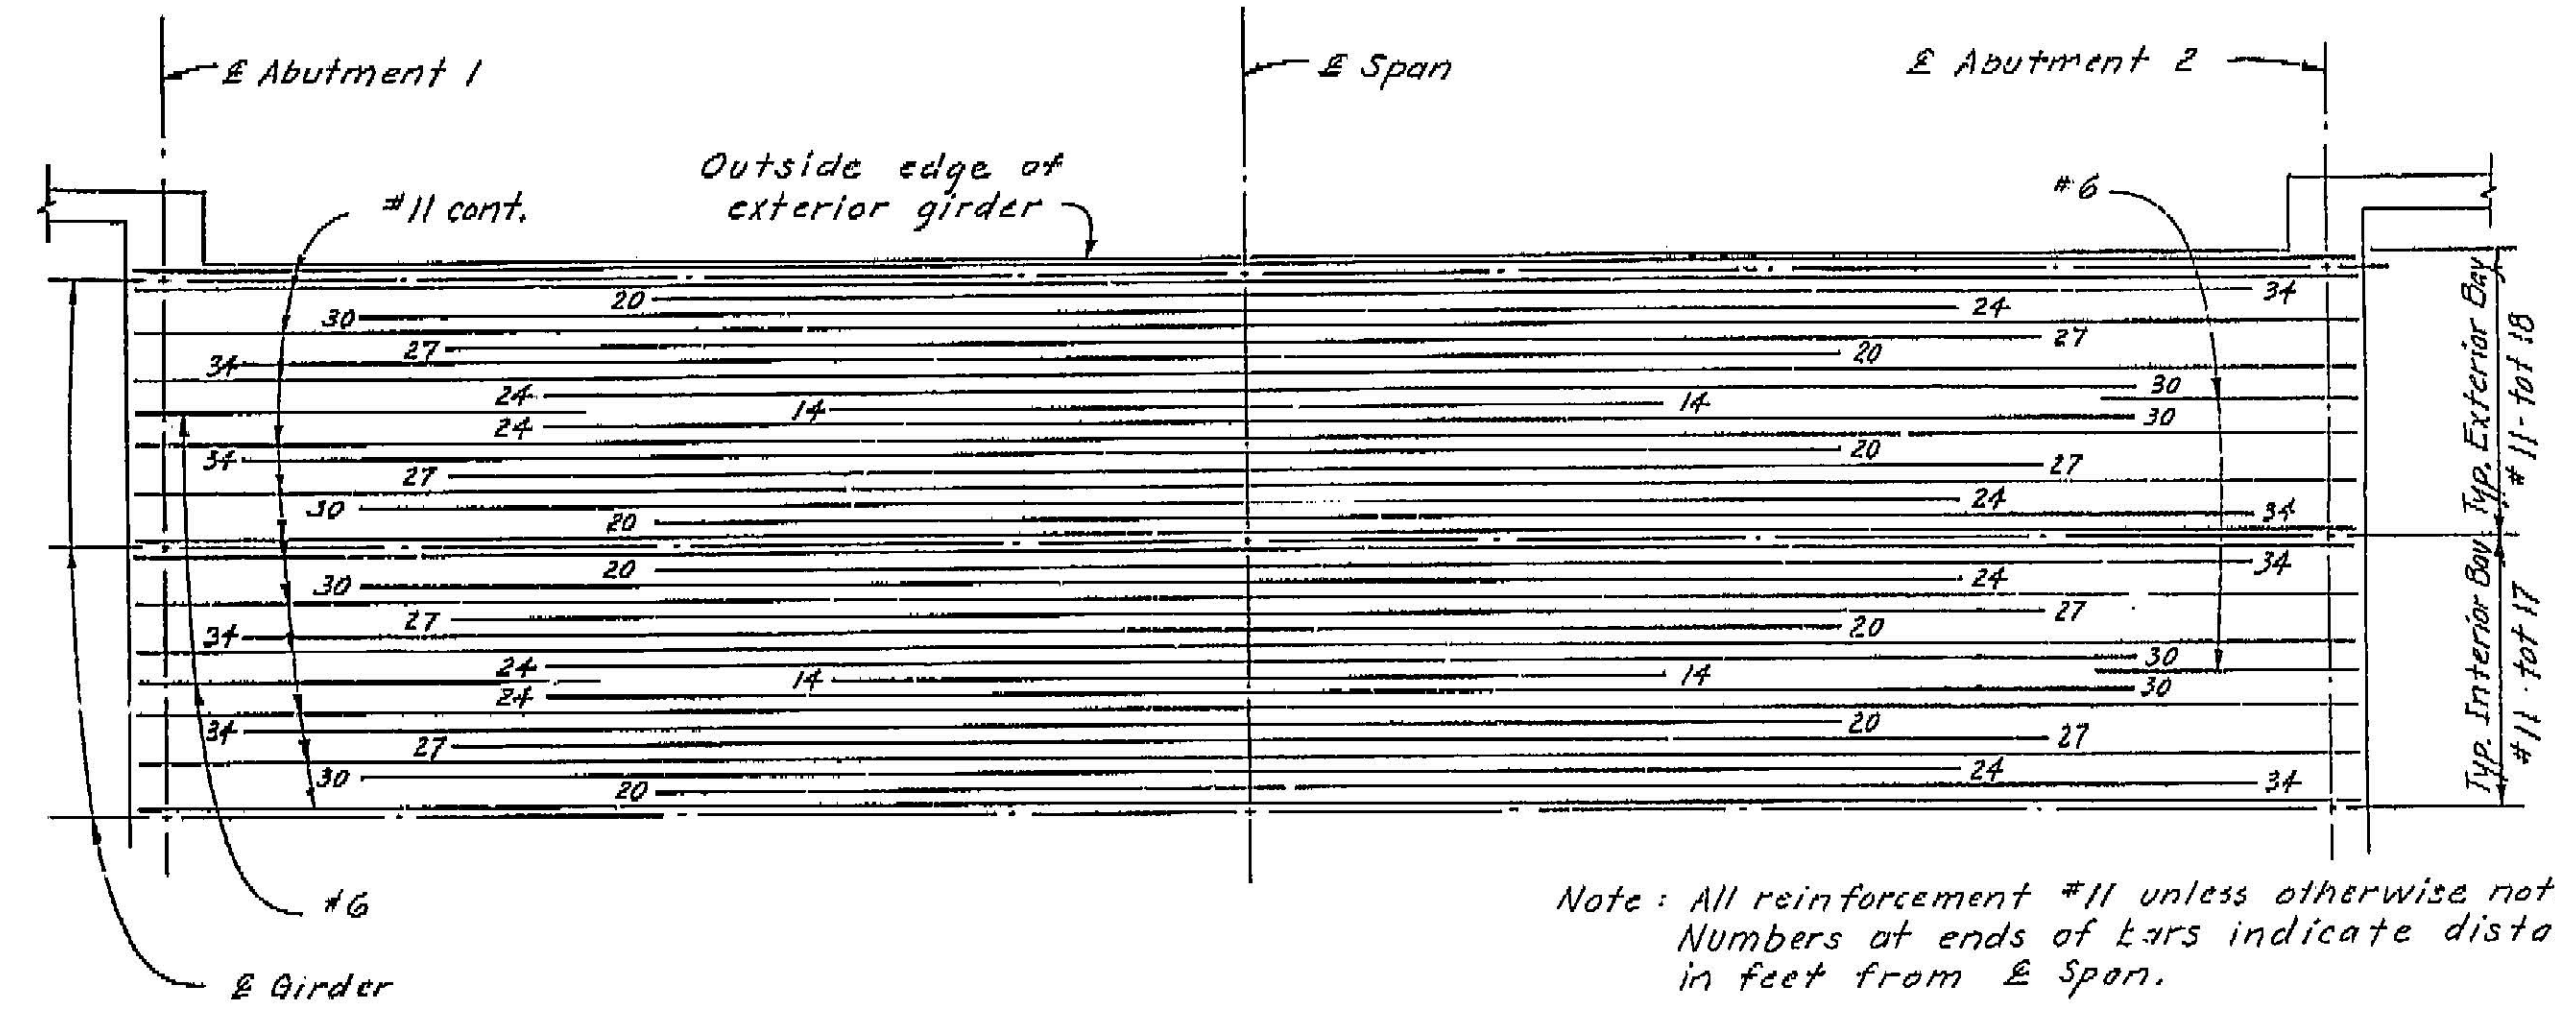

BOTTOM REINFORCEMENT  
Scale: None

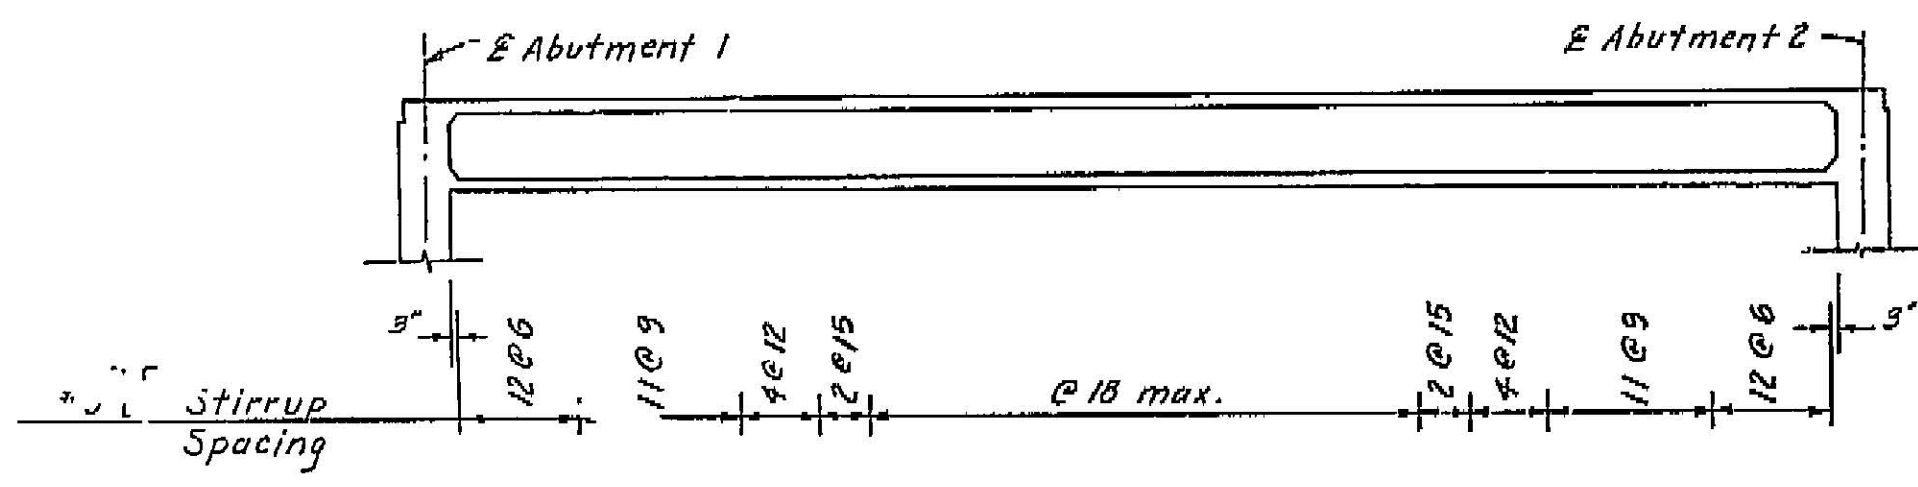

LONGITUDINAL SECTION  
Scale: 1/8" = 1'-0"

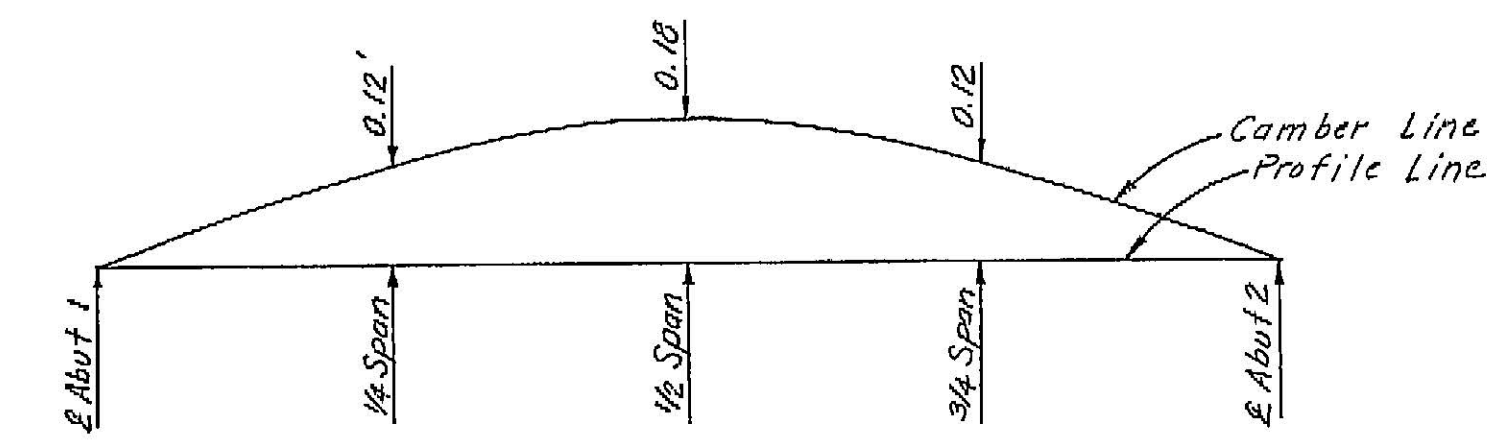

Note: Camber Diagram is for ultimate deflection due to dead load. The amount of camber for construction will be determined by the Engineer.

CAMBER DIAGRAM  
Scale: None



**CLASSIFICATION OF MATERIAL BASED ON STANDARD GRADE SIZE LIMITS.**  
 Diagram showing the basis for estimates of grade size distribution used in determining the soil classification. If gravel is present, the soil is classified as coarse-grained. If sand is present, the soil is classified as fine-grained. The terms "coarsest", "medium", and "finest" refer to the coarsest, medium, and finest sand and gravel sizes, respectively. STANDARD GRADE SIZE LIMITS.

**LEGEND OF EARTH MATERIALS**

- GRAVEL
- SAND
- SILT
- CLAY
- SANDY CLAY OR CLAYEY SAND
- SANDY SILT OR SILTY SAND
- SANDY CLAY OR CLAYEY SILT
- CLAYEY SAND OR SILTY CLAY
- CLAYEY SILT OR SILTY CLAY
- CLAYEY CLAY OR SILTY CLAY
- CLAY
- IGNEOUS ROCK
- SEDIMENTARY ROCK
- METAMORPHIC ROCK

**LEGEND OF SOIL TESTS**

- 1" METEOROMETER
- 2 1/2" CONE PENETROMETER
- SWAMPY BORING (SW)
- ROTARY BORING (RB)
- AVIATION BORING (AV)
- JET BORING
- CORE BORING
- TEST PIT

**1" SOIL TUBE**

**ROTARY BORING**

**PENETRATION BORING**

**NOTE:** Classification of earth material as shown on this sheet is based upon field inspection and is not to be construed to imply mechanical analysis.

